


MATCH LINE - SEE SHEET 4

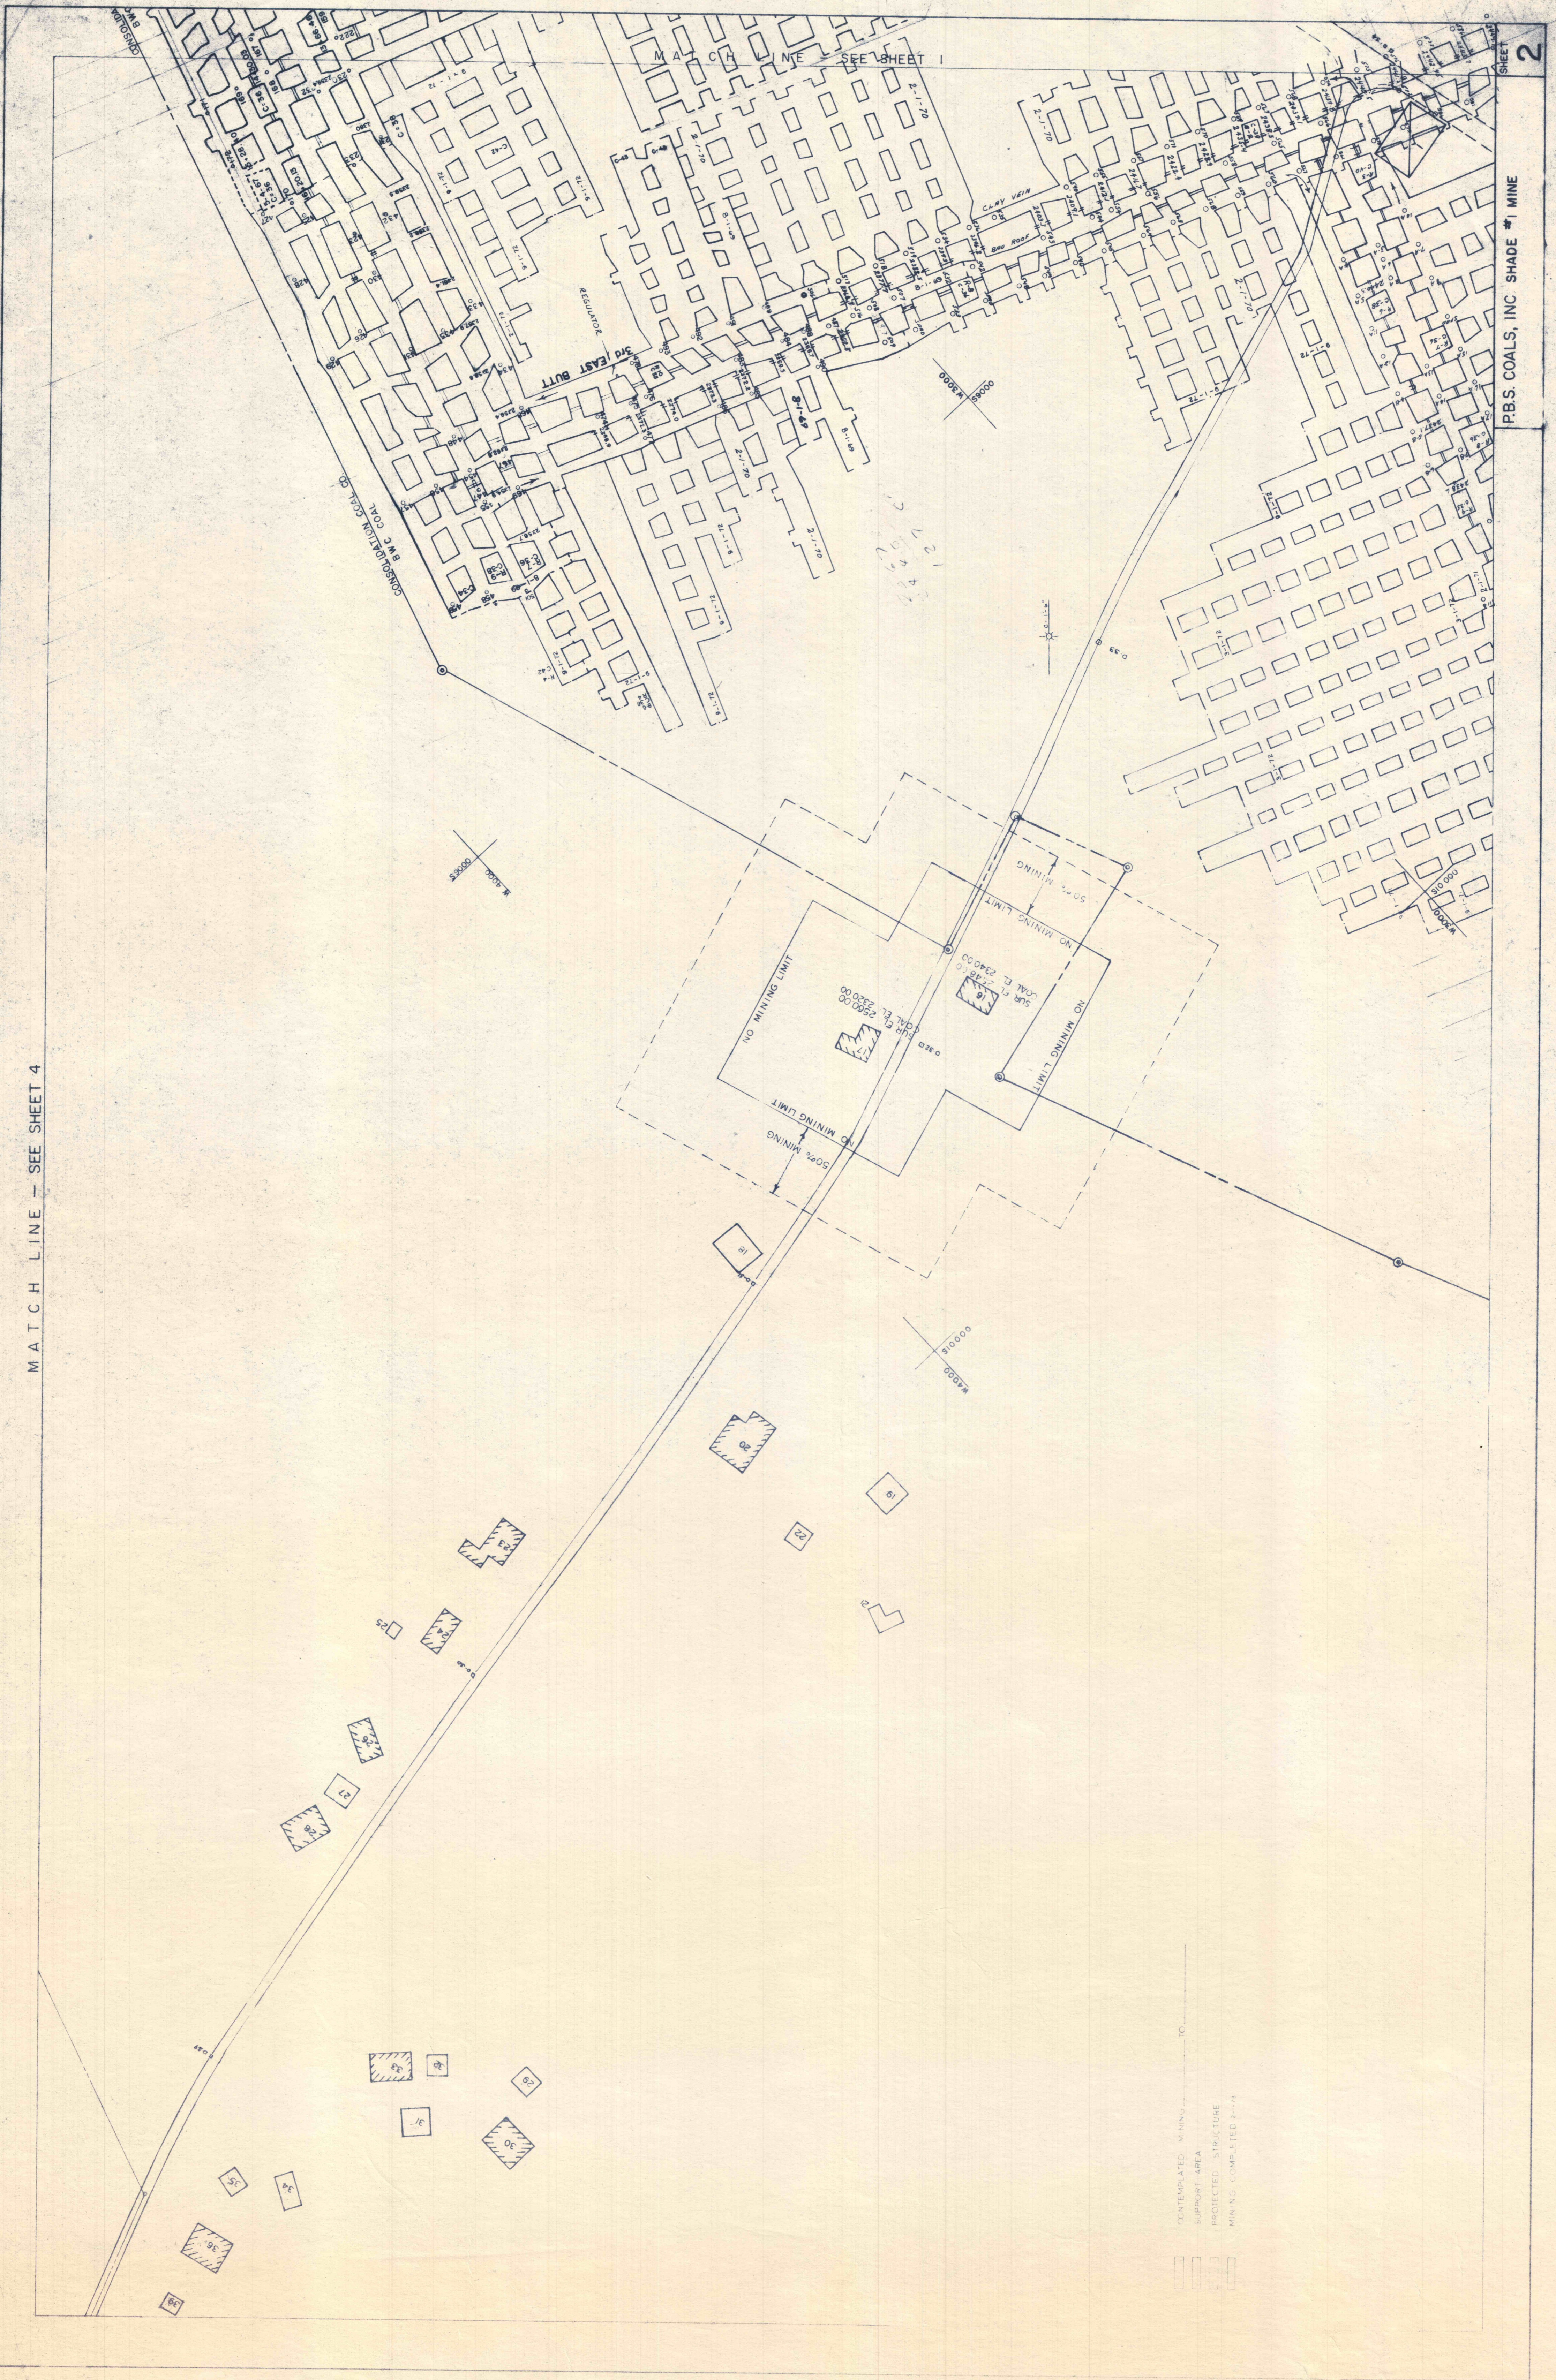

P.B.S. COALS, INC. SHADE #1 MINE

SHEET 2