

THE CONSOLIDATION COAL COMPANY INC.



MAP OF
SOMERSET COUNTY
PENNSYLVANIA
SHOWING
MINING OPERATIONS

Scale 1 Inch = 1 1/2 miles May 1919
Revised July 1942

- C.C.Co. Operations
- Other

*Consol. Coal ownership as of 1-1-61
(Jenner Field not checked for accuracy)*

1 Copy to J.E.N. for Wm. R.E. Co. 1-17-61

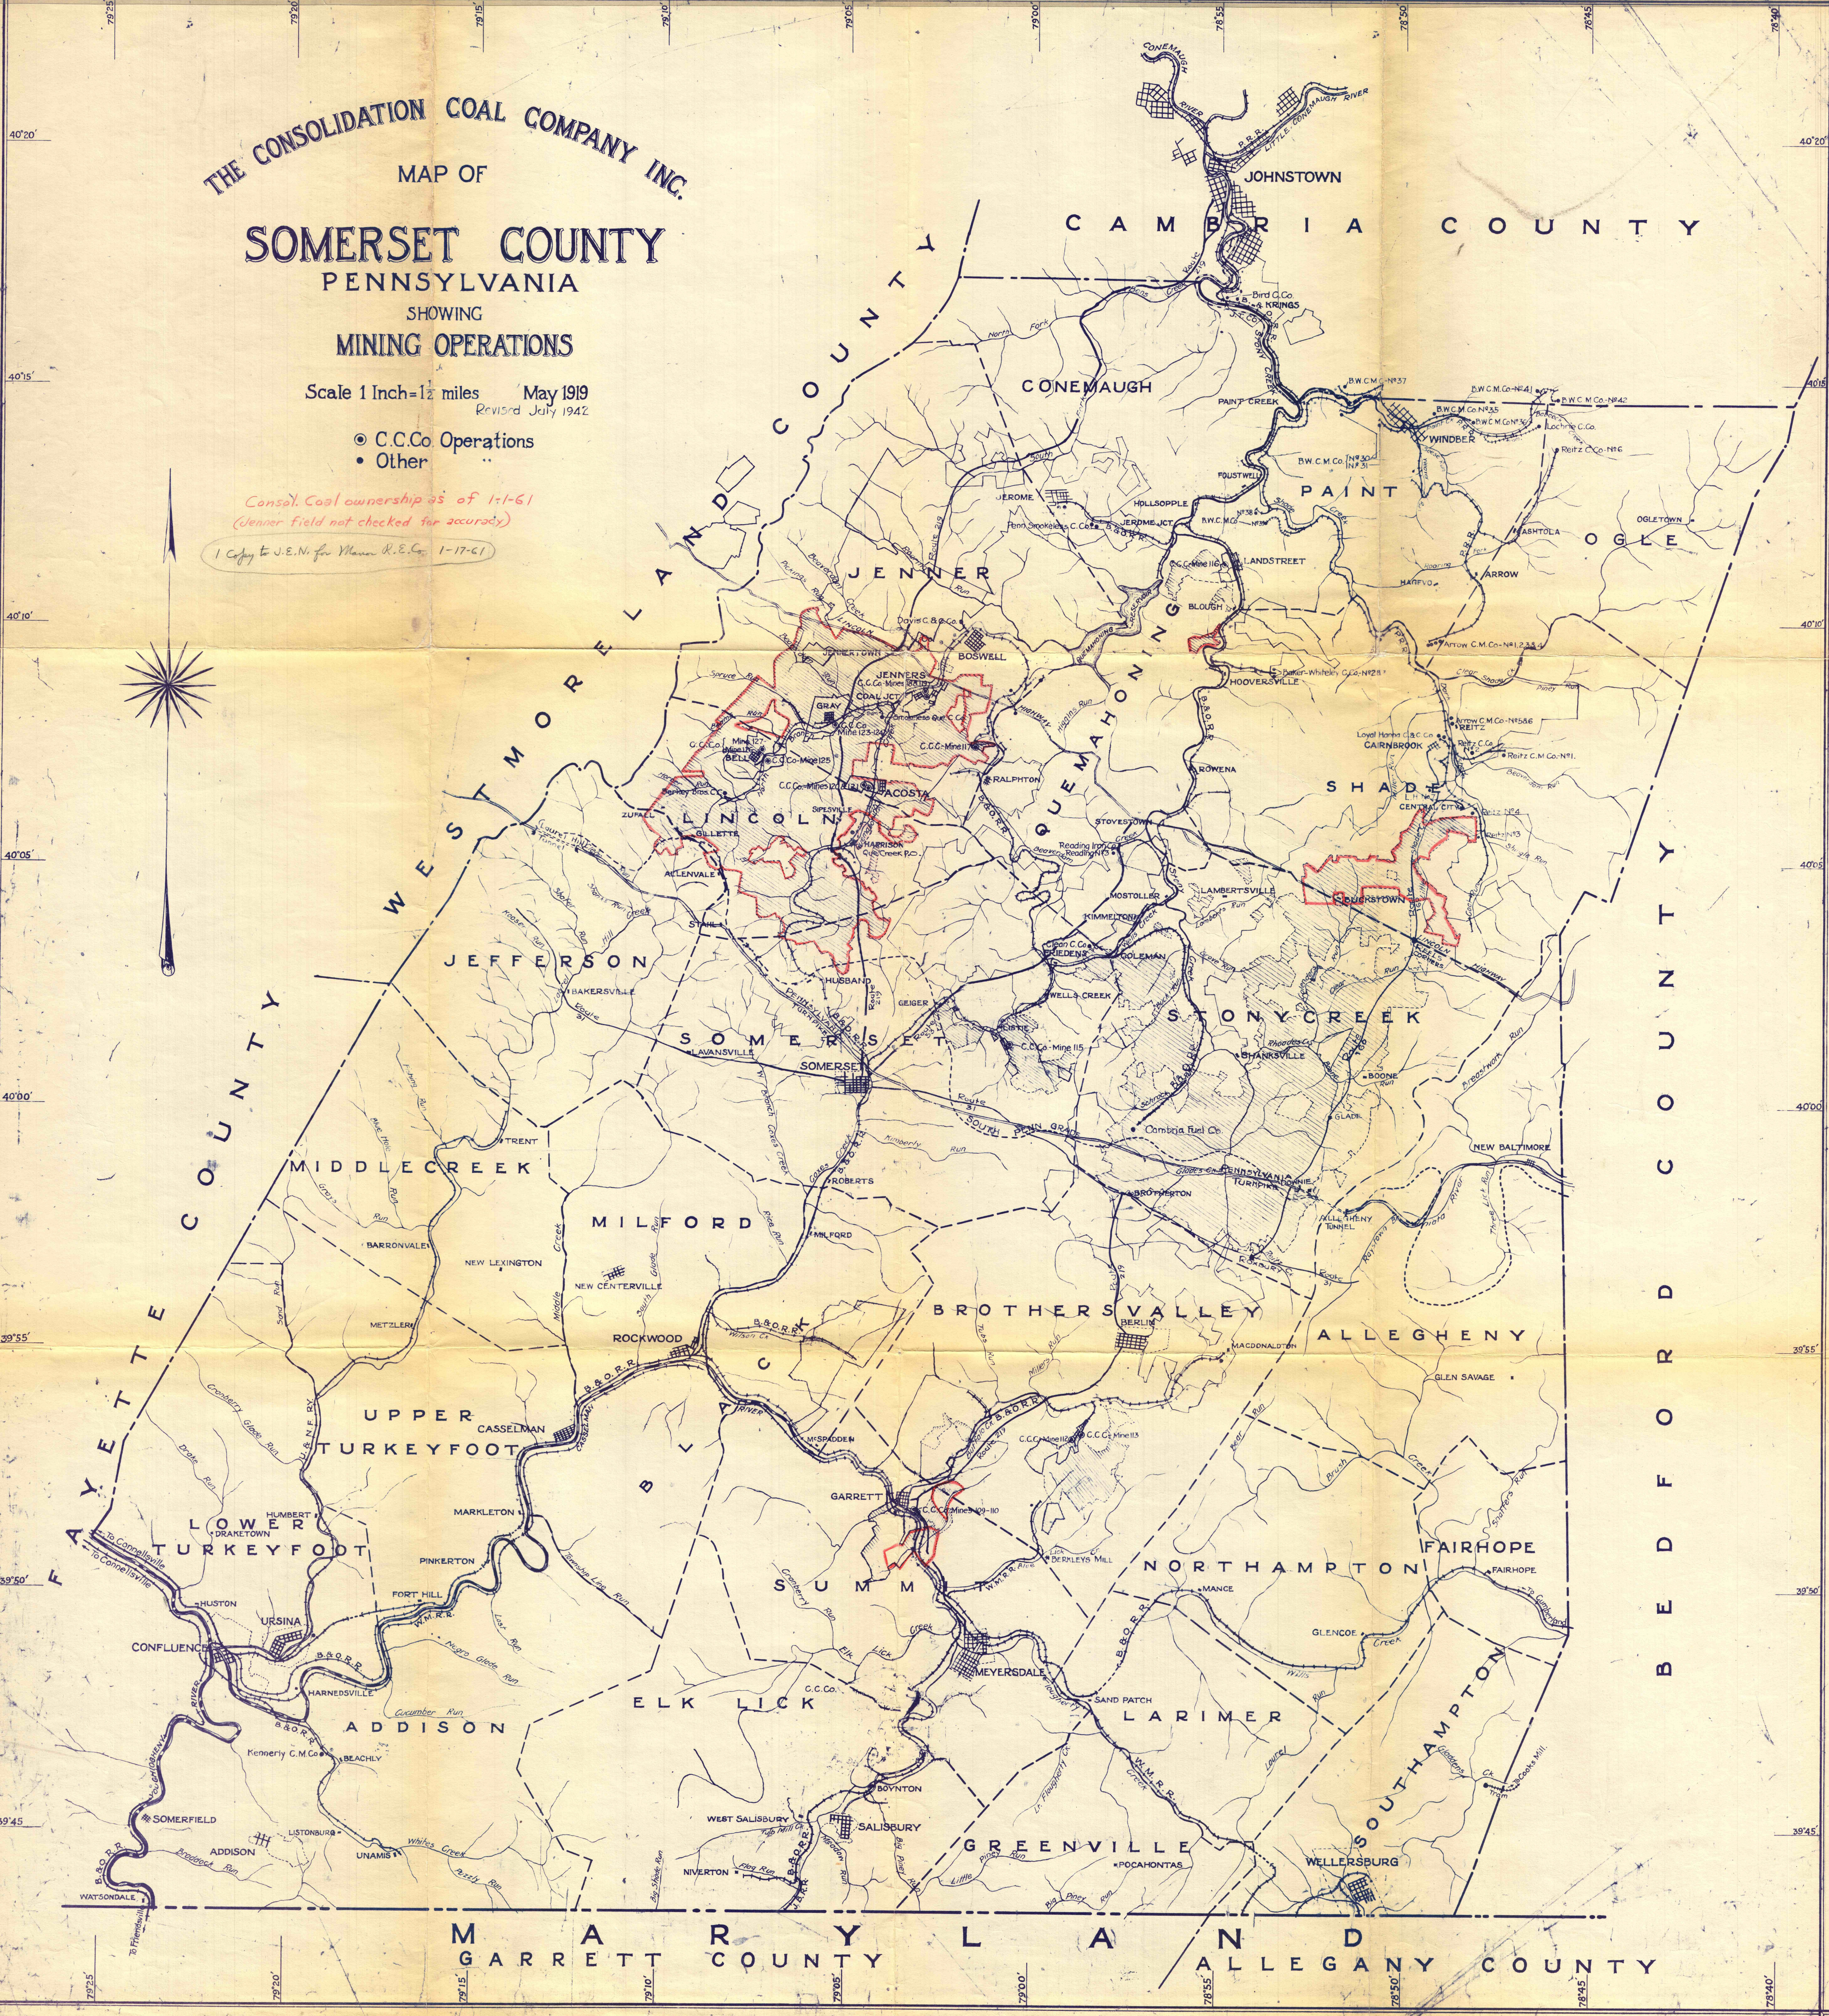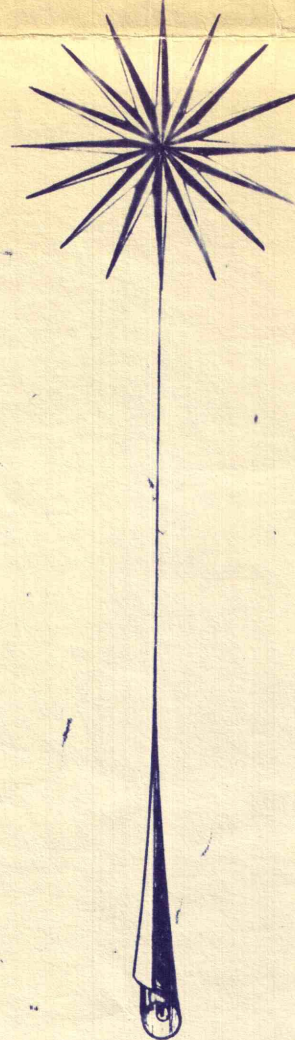

M A R R Y L A N D
GARRETT COUNTY ALLEGANY COUNTY