

ACME MINE


PITTSBURGH-WESTMORELAND COAL CO.

SCALE 1" = 400'

APR. 20 - 1916

ENGINEERS OFFICE

AVG. 18 - 1916
OCT. 25 - 1916
AUG. 11 - 1917
DEC. 15 - 1918
JUNE 25 - 1918
NOVEMBER 25 - 1918

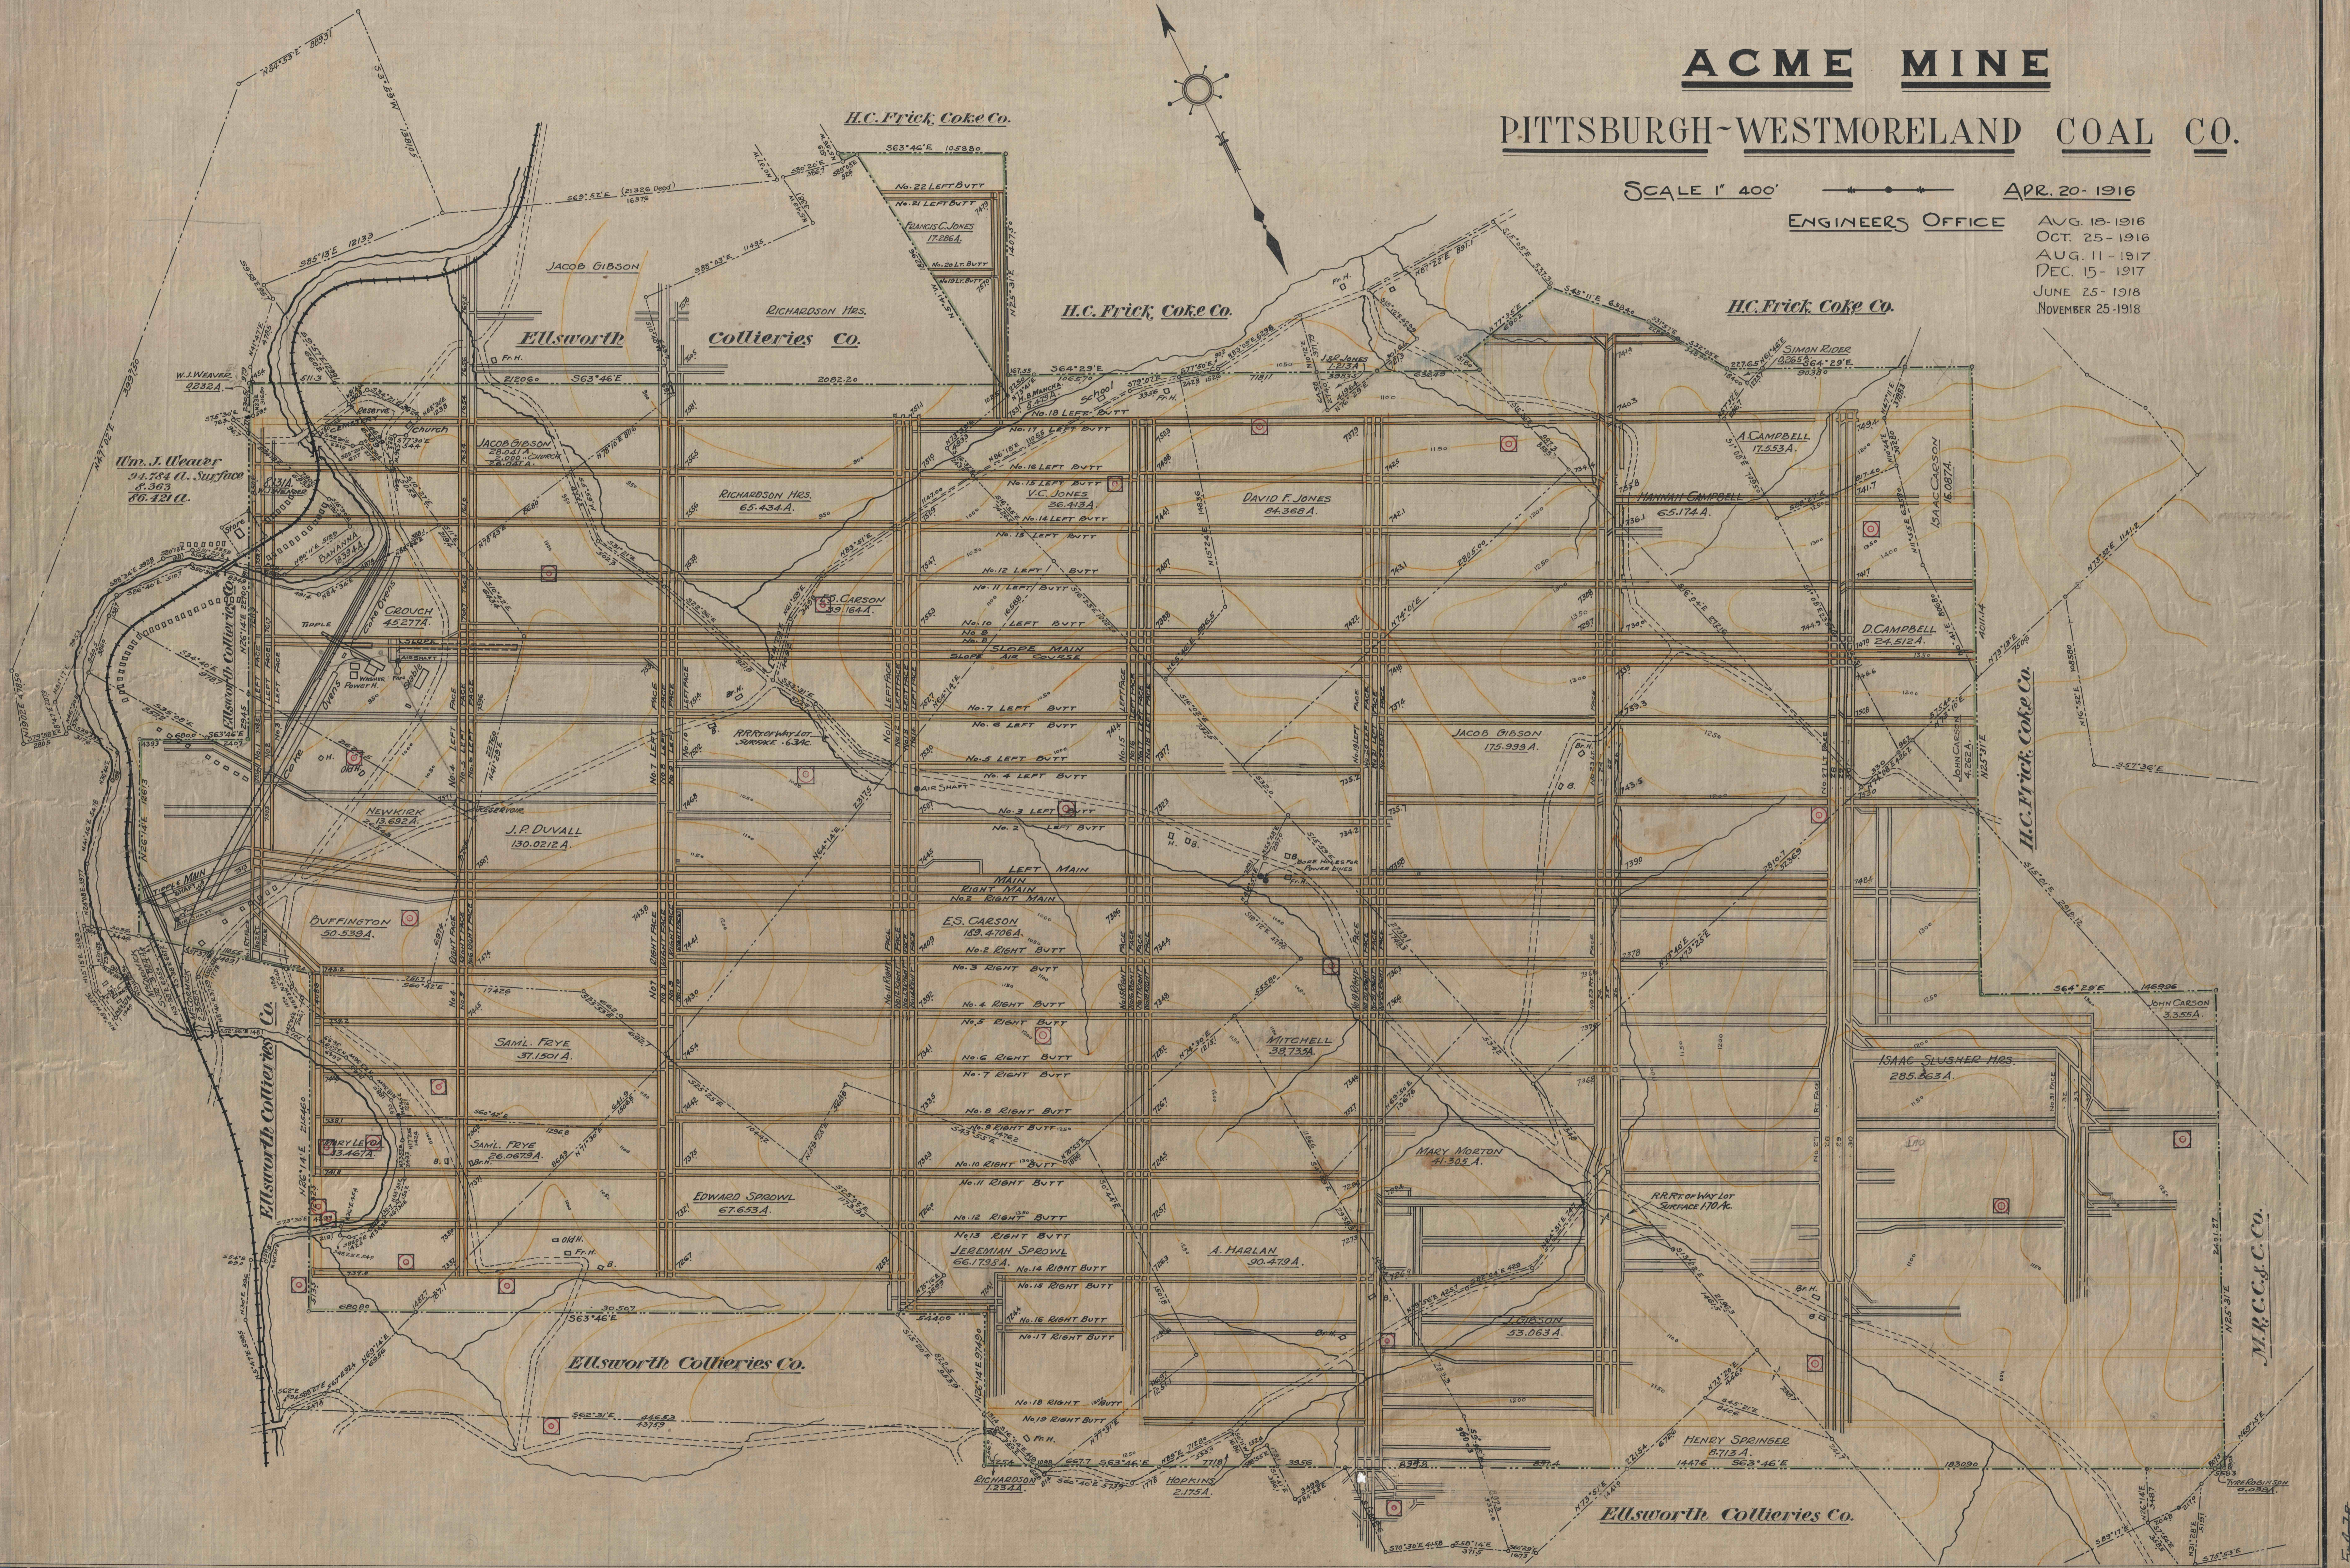

5478

5478