


SEWICKLEY 519

FIT TO 495

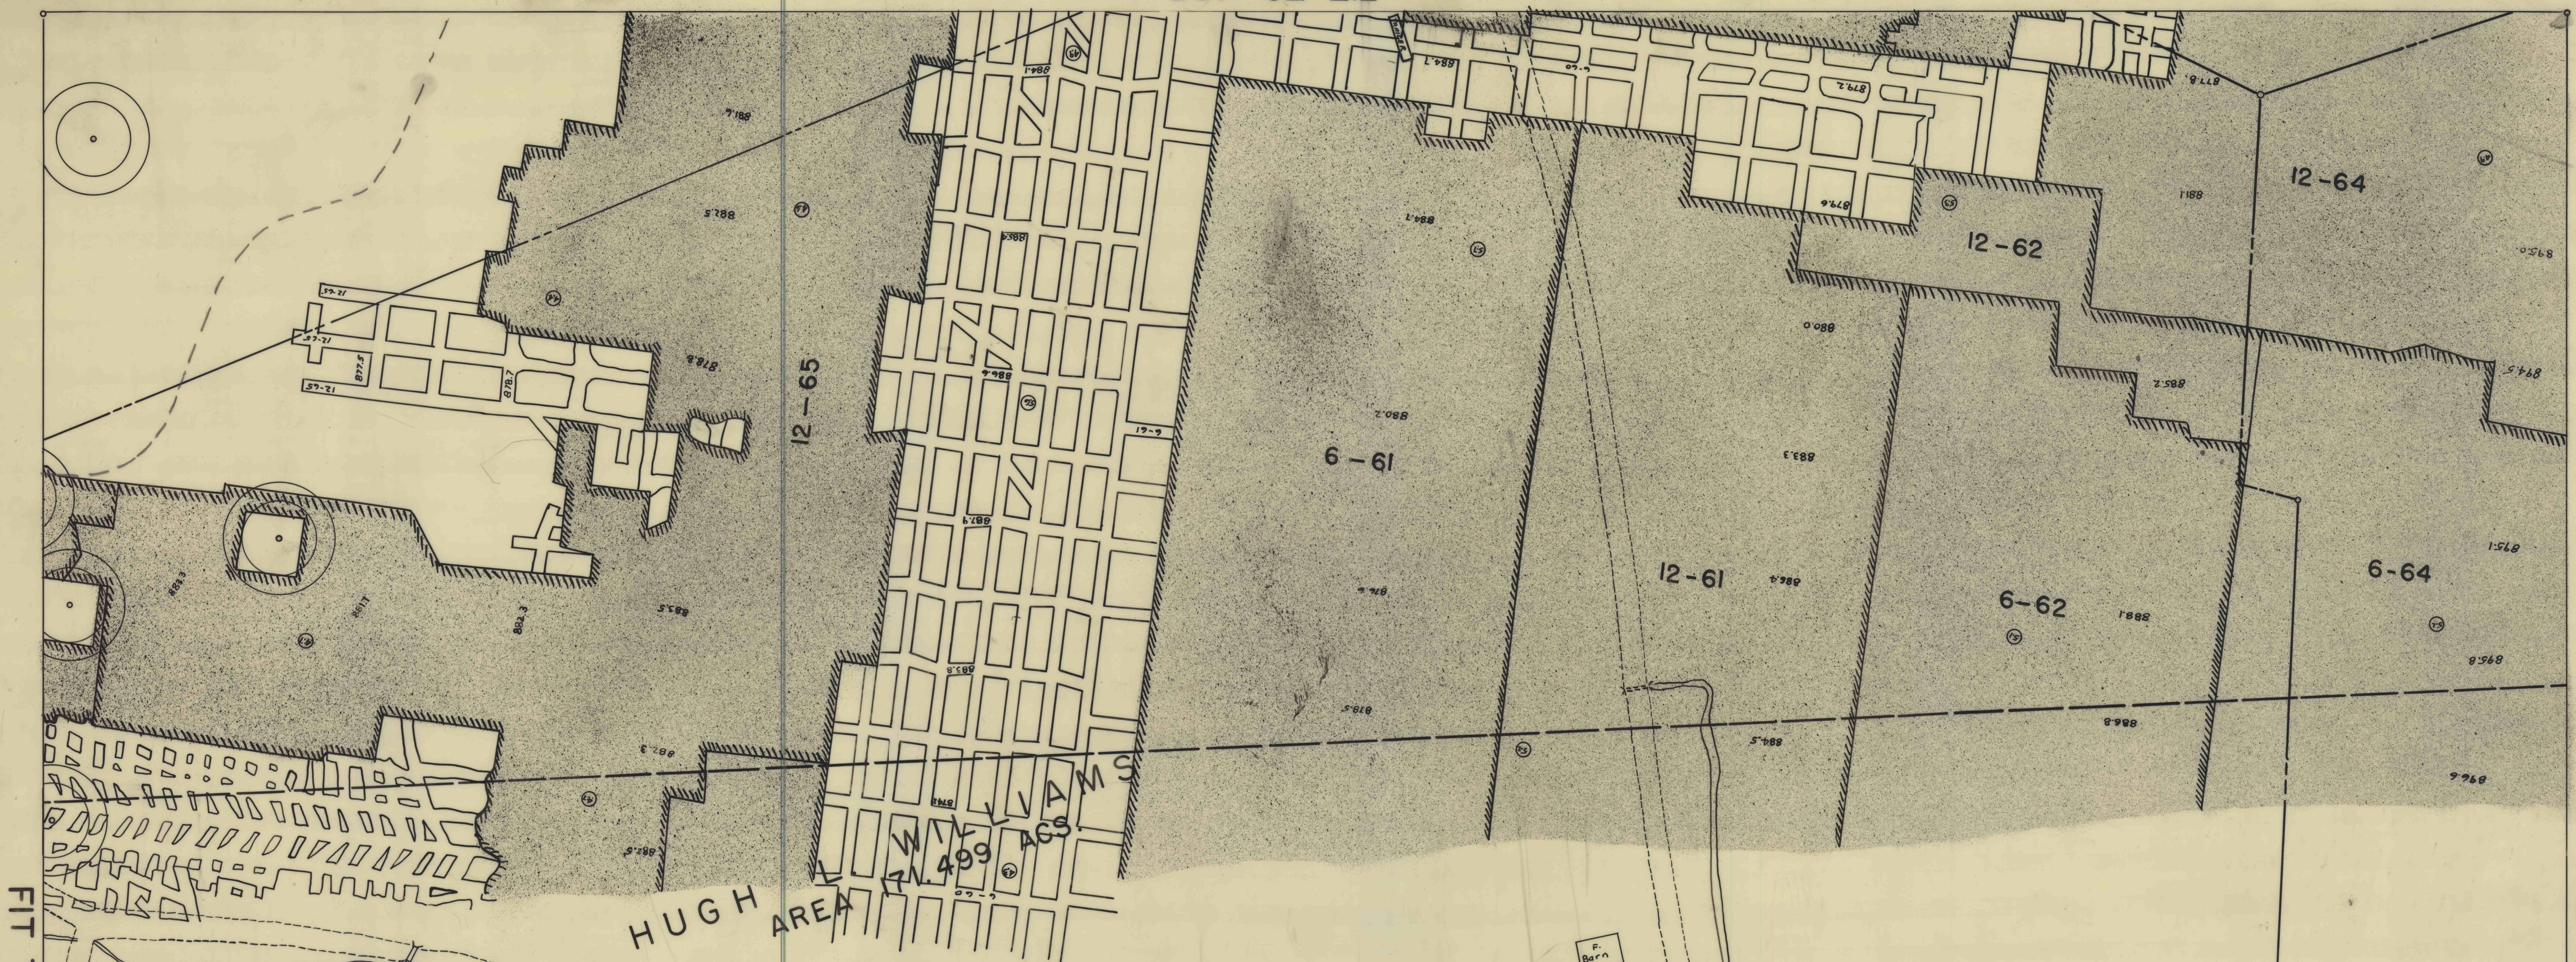

FIT TO 543

SEWICKLEY 519