
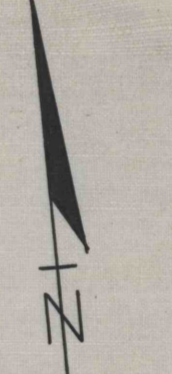


BENN AND SHAW

SCHRICKER EST.

SAMUEL HAGERTY

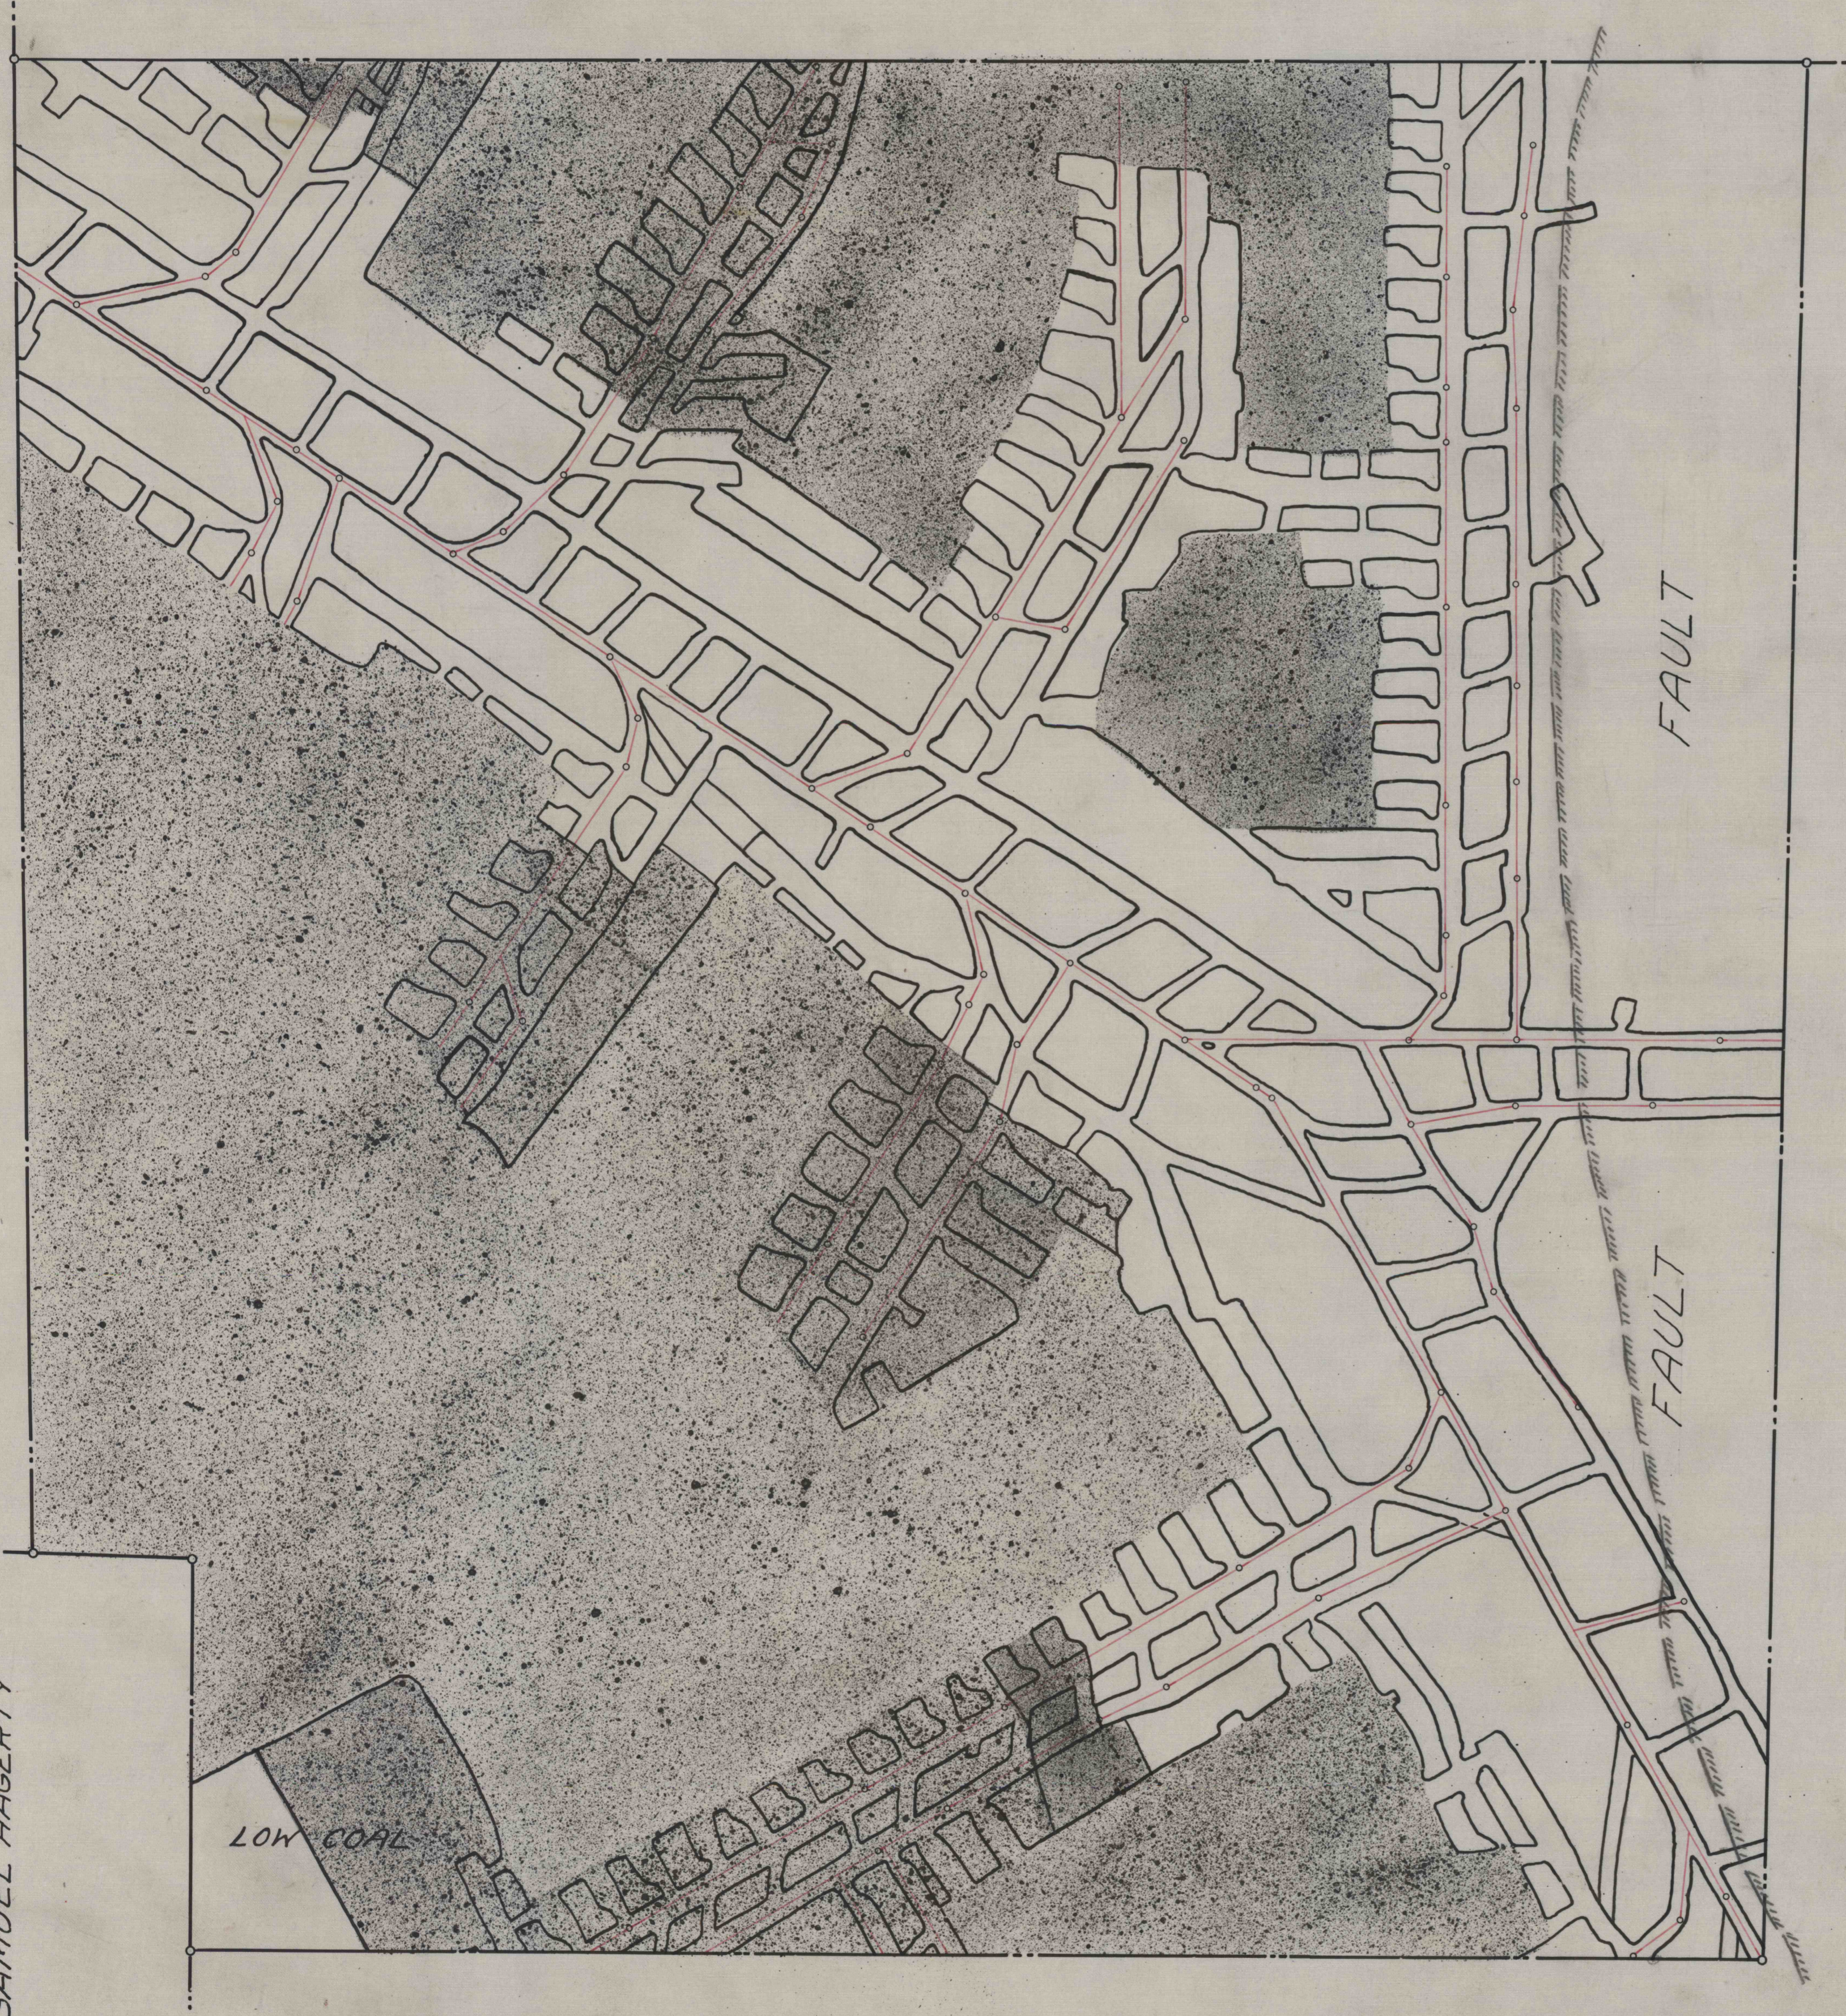

SCHRICKER EST.

SCHRICKER EST.

PROPERTY
LEASED BY
BENN AND SHAW
TO THE
IMPERIAL COAL CORPORATION
BECCARIA TWP. CLEARFIELD CO. PA.
SCALE - 1" = 100'