


029

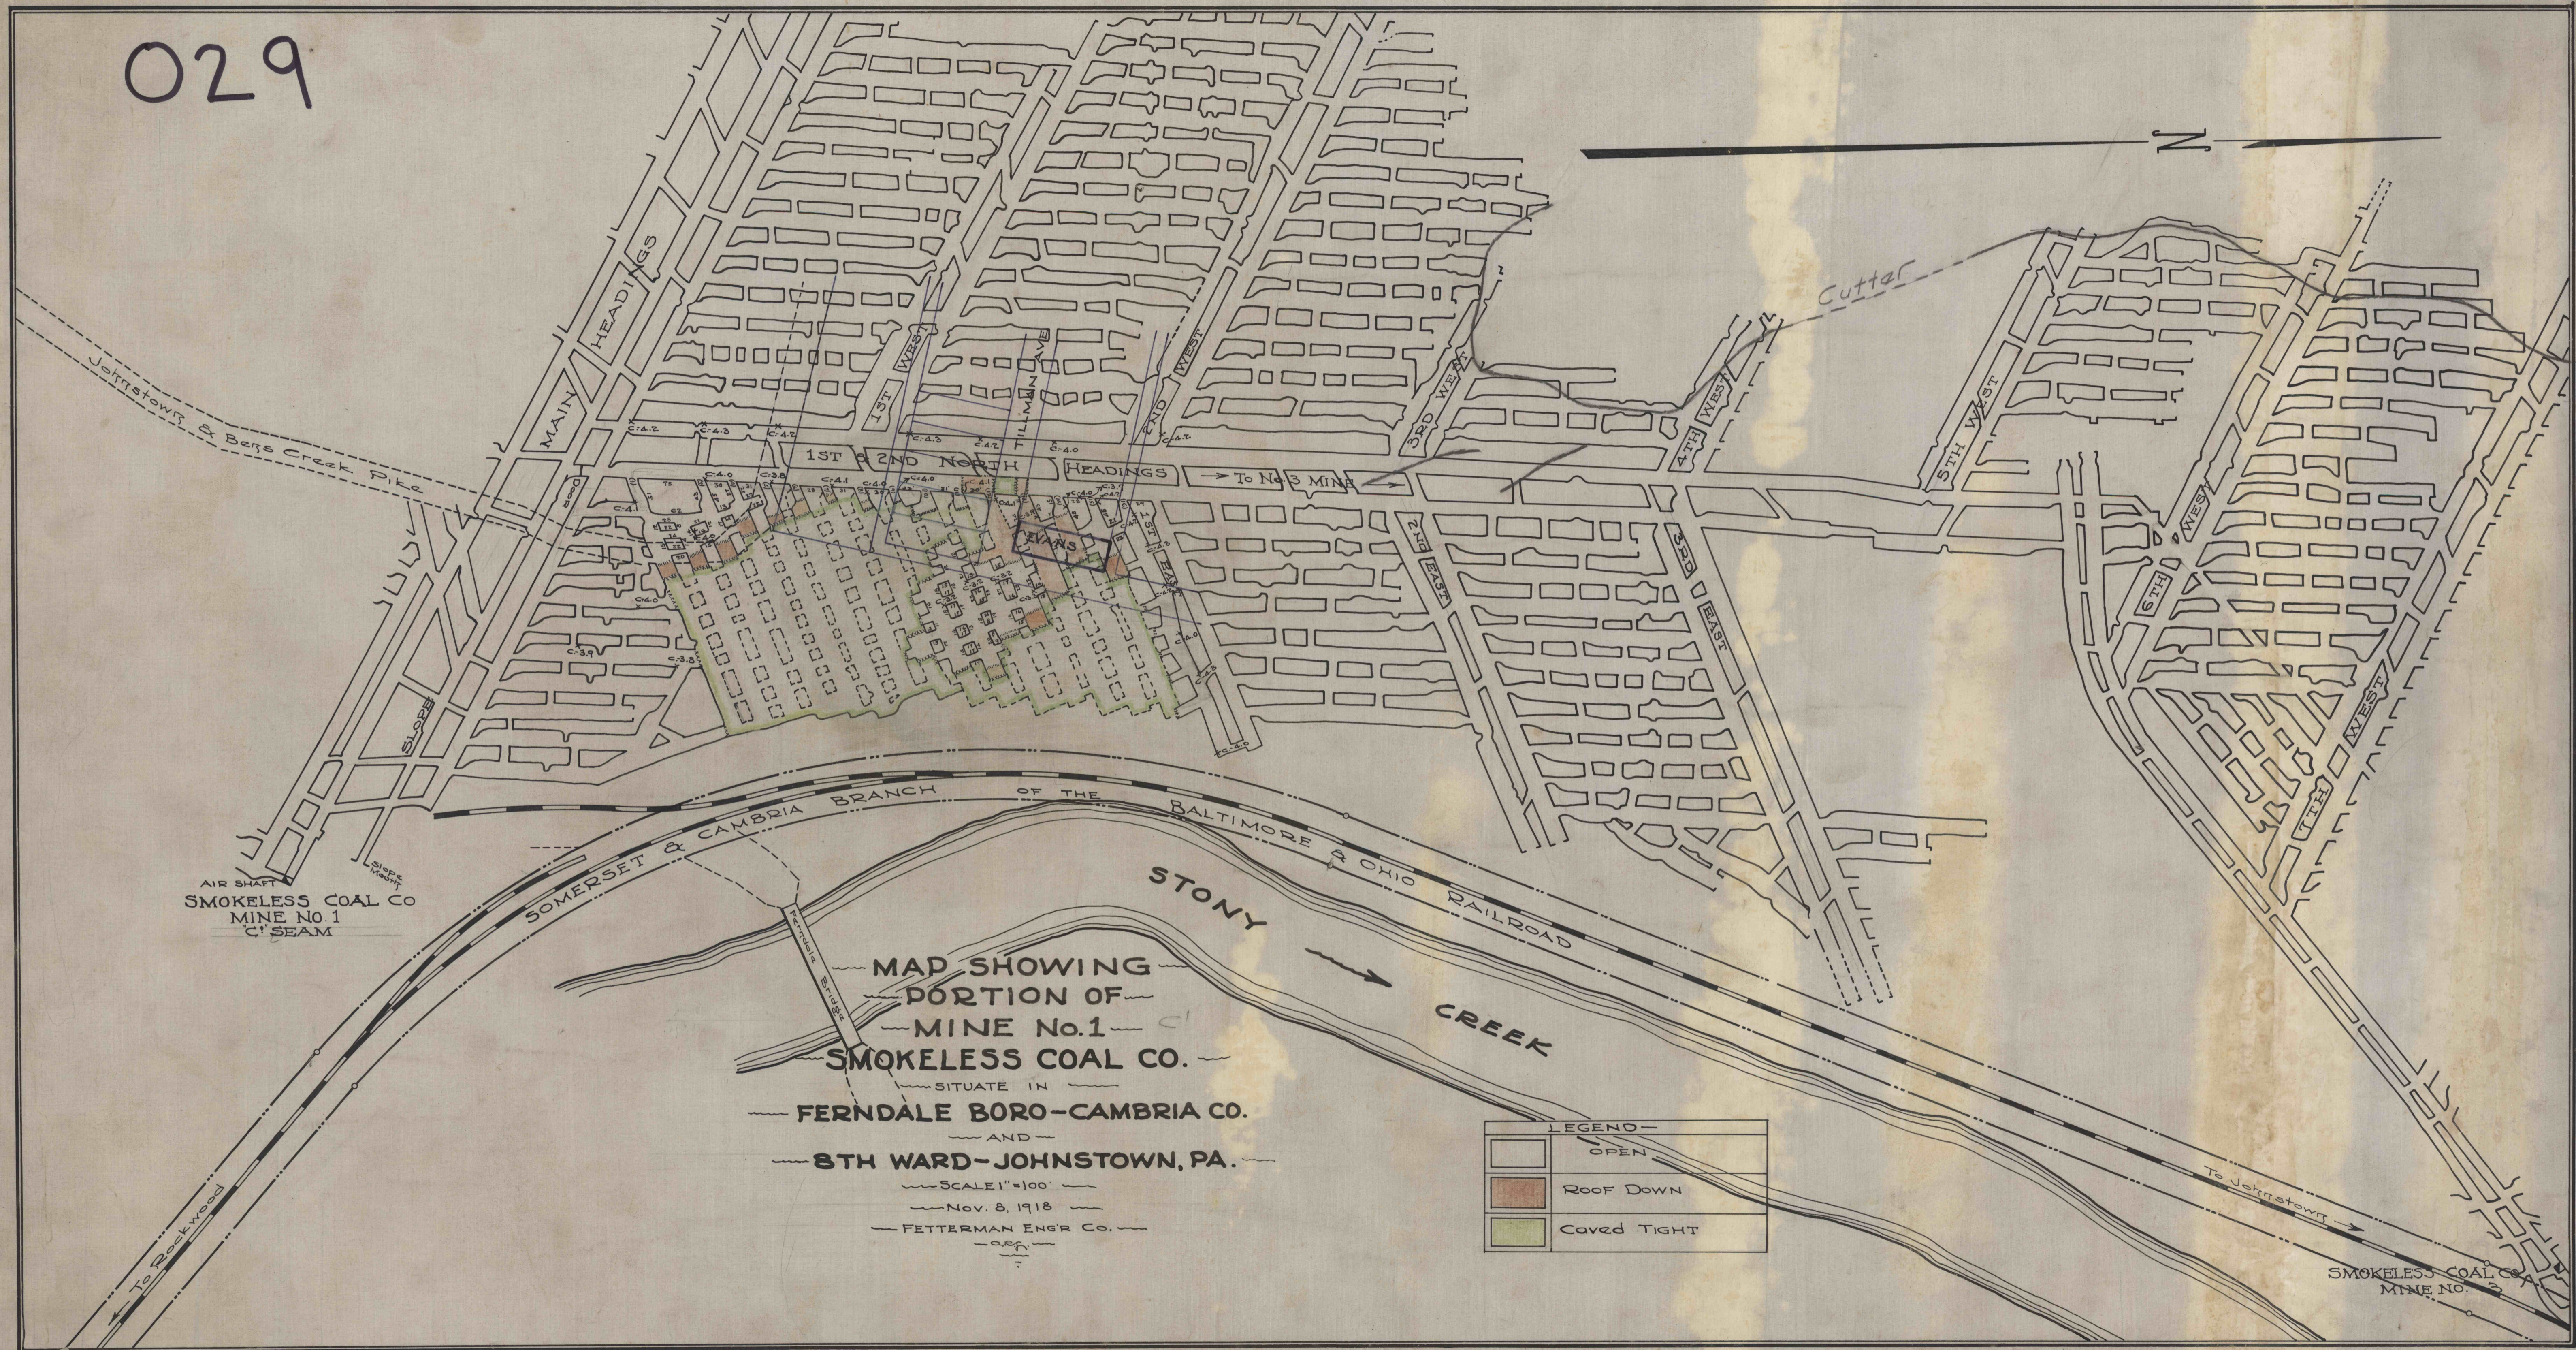

AIR SHAFT
SMOKELESS COAL CO
MINE No. 1
C SEAM

MAP SHOWING
PORTION OF
MINE No. 1
SMOKELESS COAL CO.

SITUATE IN
FERNDAL BORO-CAMBRIA CO.
AND
8TH WARD-JOHNSTOWN, PA.

SCALE 1"=100'
Nov. 8, 1918

FETTERMAN ENGR CO.

LEGEND-

	OPEN
	ROOF DOWN
	CAVED TIGHT

SMOKELESS COAL CO
MINE NO. 1