



EL. 1215

FRED MUSSER

WASHINGTON TWP?
ARMSTRONG TWP?

STEVEN HIGGINS

EUGENE BRICILLO

WALTER JOHNSTON

JAMES JOHNSTON

WILLIAM JOHNSTON

FRED MUSSER ETAL
Surface & Coal




David E. Youngling

POSTED
MAY 28, 1973

Contemplated Mining
From 7-73 To 11-94

Urling No. 1 Mine
36 04852
SHELOcta, INdIANA CO. PA.
Scale 1" = 100' Date _____

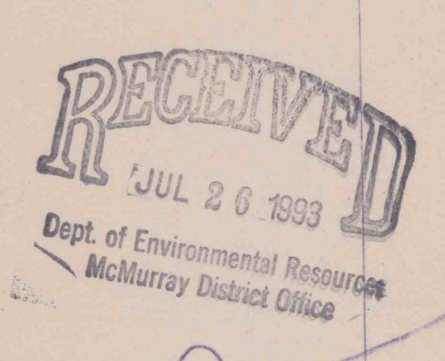

4" VENT HOLE
S.E. 1207.97
T.C. 826.76
D- 381.21

840

SPLIT SEAM

FIRST MINING

EUGENE BRICILLO

STEVE VOYTEK

50% MINING
50% MINING
50% MINING

JOSEPH BROCK

MINING

FIRST MINING

MINING

MINING

