

BUDDY R. ORR

LAWRENCE MARRA

WALTER HOUSER

JOHN W. JOHNSTON

JOHN SIMPSON

JACK L. WESTON

NICK BENCIC JR.

ARTHUR E. SPENCE

JOHN SIMPSON

ALLEGED ABANDONED WELL SITE
FIELD CHECKED FEBRUARY 1993
NO PHYSICAL EVIDENCE FOUND




JOHN L. WESTON
David E. Jungling

POSTED
MAY 28, 1993

Contemplated Mining
From 71-93 To 14-94

Urling No. 1 Mine
36 04852
SHELOCTA, INDIANA COUNTY, PA.
Scale 1" = 100' Date _____

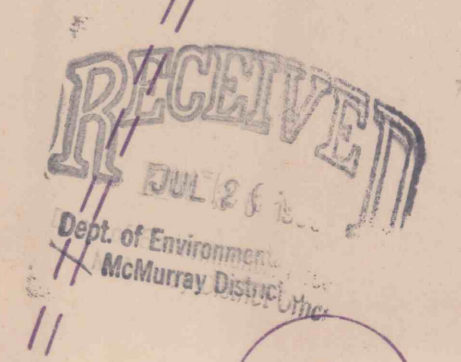

URLING NO. 1 MINE
KEYSTONE COAL MINING CORP.
WASHINGTON TWP. INDIANA CO. PA.

P87

880

870


860

840

850


830

840

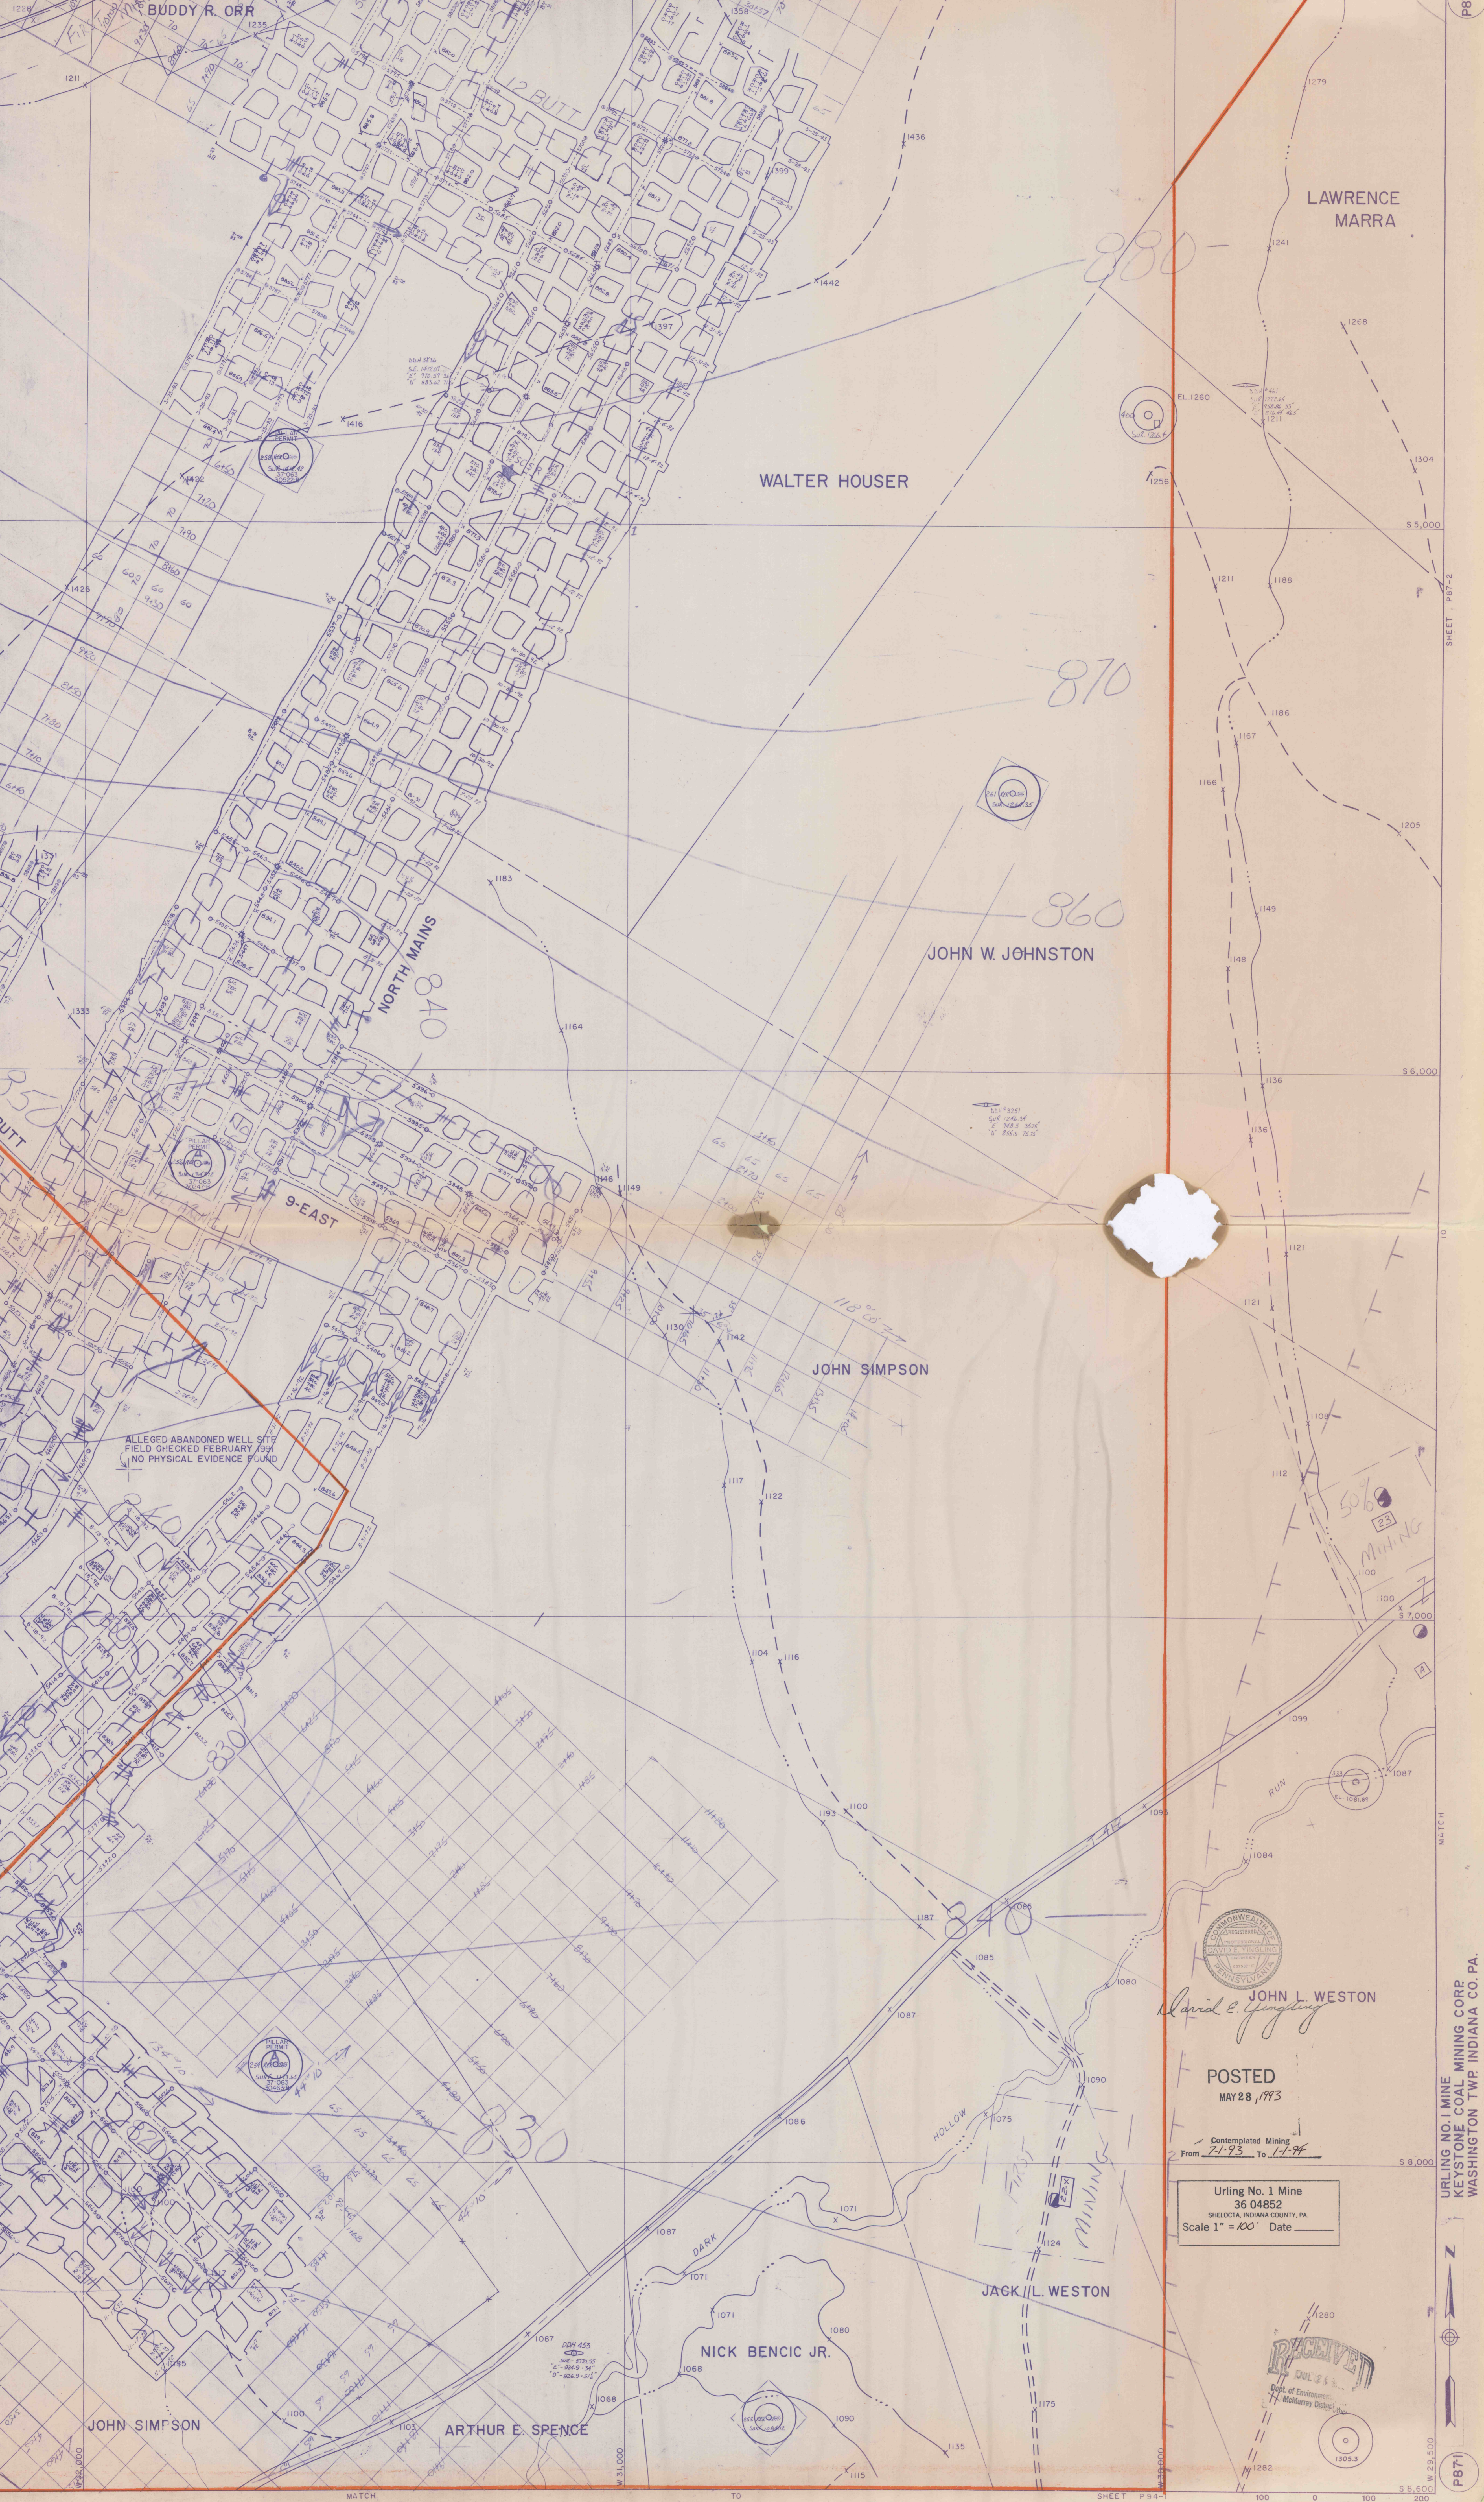

P87

P87

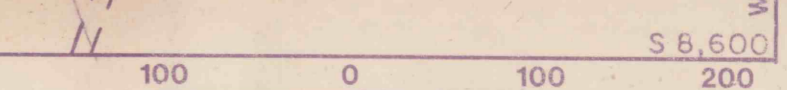

SHEET P 94

TO

MATCH

W 31,000
S 5,600
D. W. 29,500

MATCH

TO

SHEET P 87-2

S 4,000