

ARTHUR E. SPENCE

JACK L. WESTON

C. LEEROY VATTER

NICK BENCIC JR.

50% MINING

820

WASHINGTON TWP.
ARMSTRONGS TWP.




David E. Youngling

POSTED
MAY 28, 1993

From 7-1-93 To 1-1-94

Urling No. 1 Mine
36 04852
SHELOcta, INDIANA COUNTY, PA.
Scale 1" = 200' Date

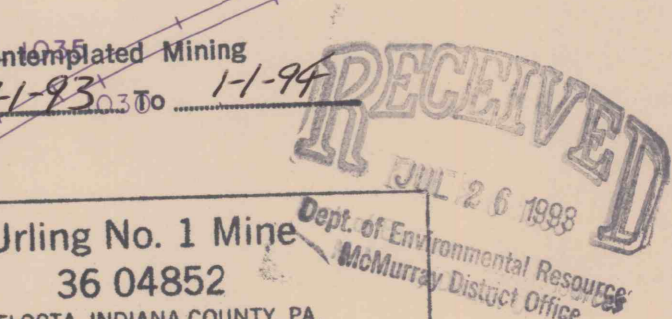

Urling No. 1 Mine
KEYSTONE COAL MINING CORP.
WASHINGTON TWP. INDIANA CO. PA.