

E-1691,000

E-1692,000

E-1693,000

E-1694,000

N-457,000


N-457,000

JAMES O. FISHER
86.50 A.

DUTCH RUN

MARY E. CLOWES
85.87 A.

NO. 2-60
S=1775.5
D=1460.6 C=46"
B=1299.6 C=39"

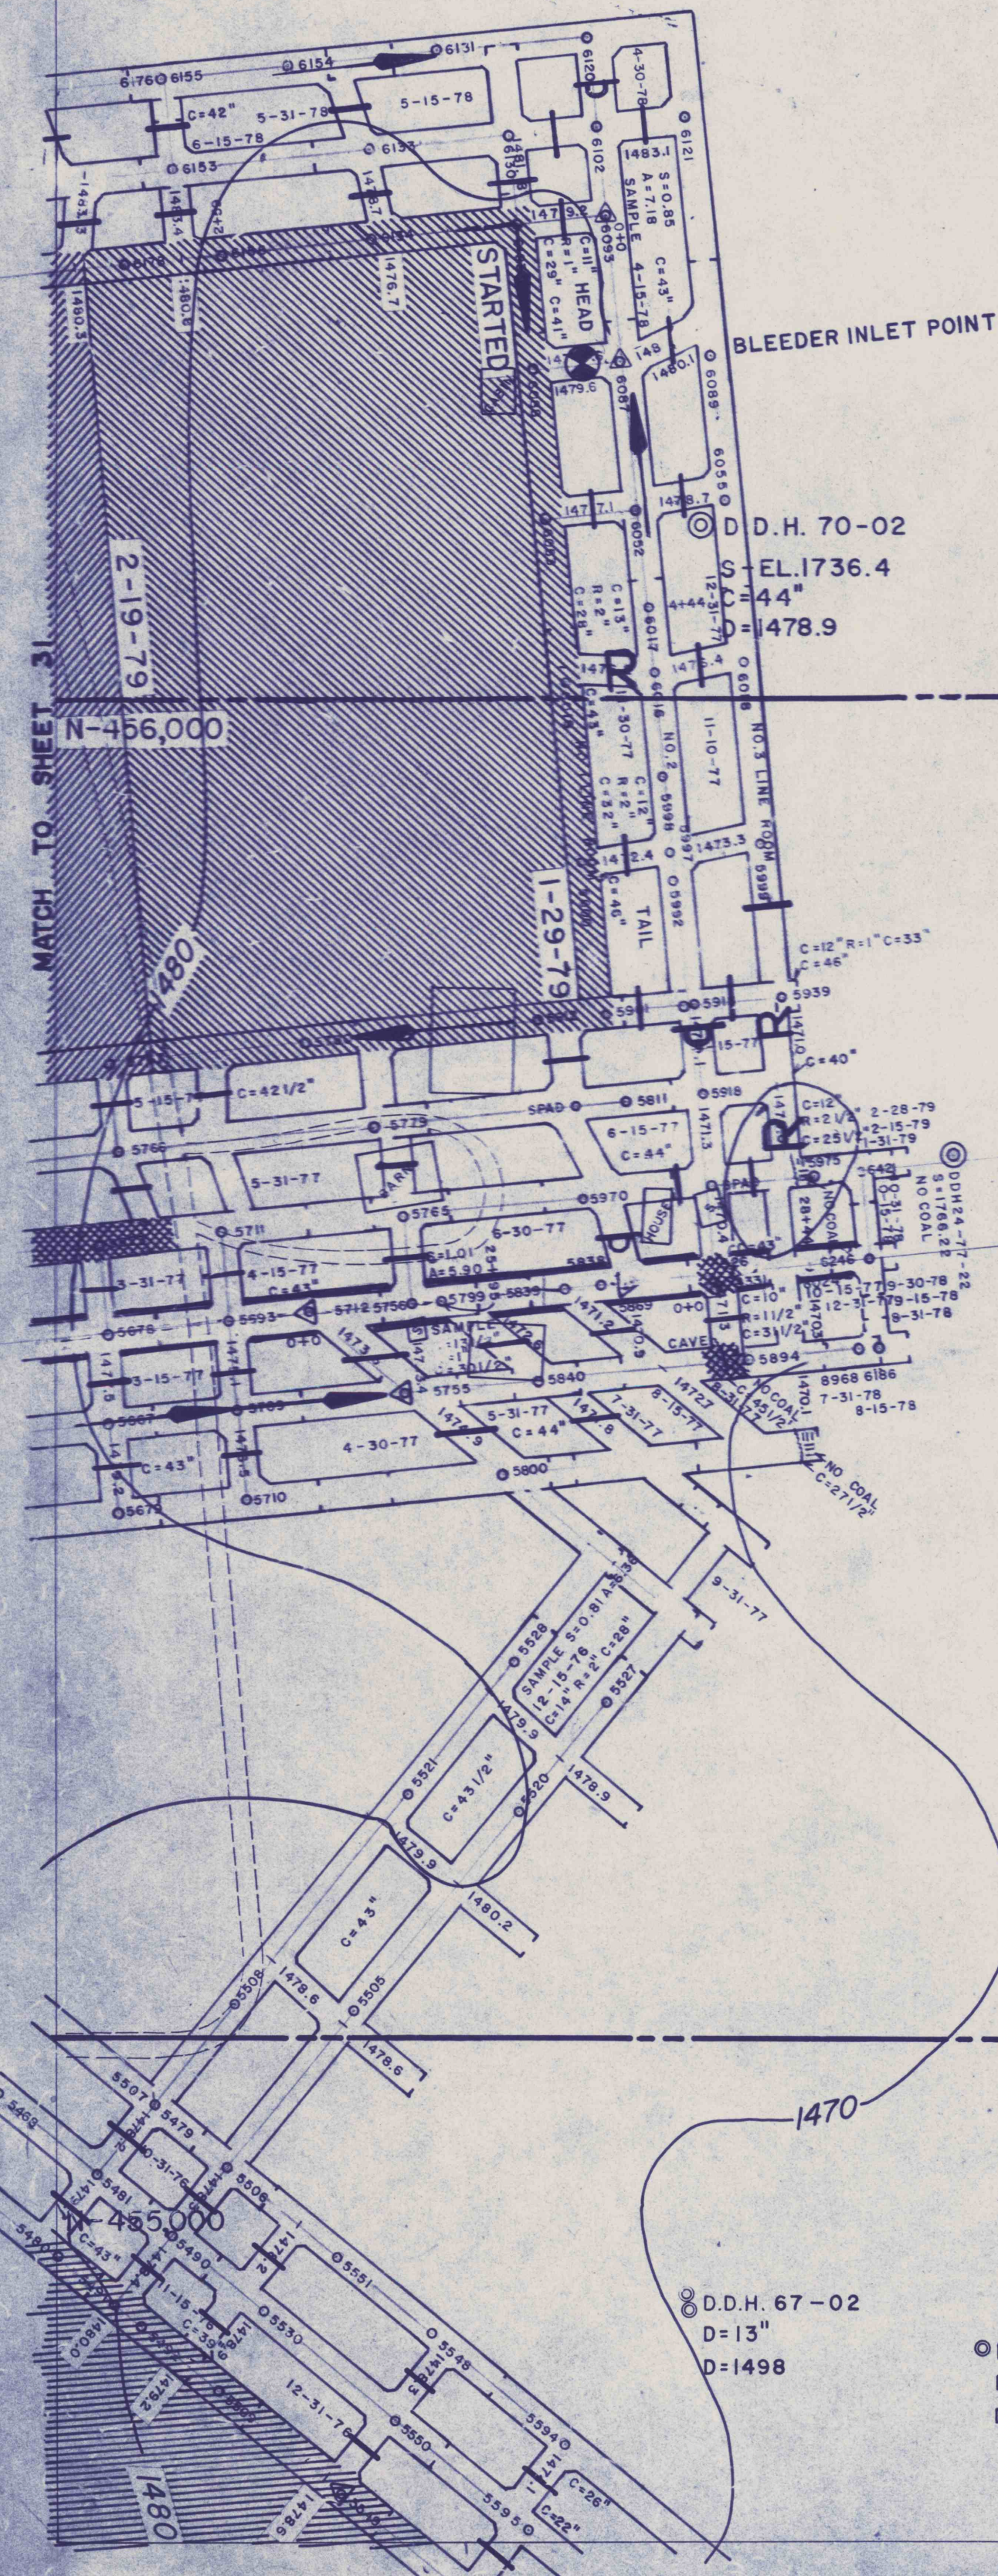

JOHN A. MAKIN
55.62 A.

JAMES A. MARSH
34.02 A.



DUTCH RUN

D.D.H. 67-02
D=13"
D=1498

D.D.H. 67-04
D=46 1/2"
D=1494.5

E-1691,000

E-1692,000

E-1693,000

E-1694,000

MATCH TO SHEET 31

MATCH TO SHEET 33

MATCH TO SHEET 39

MATCH TO SHEET 40

CLOSING DATE: 6-30-85

NO 24 "D" SEAM