


FIT TO F-2

- YELLOW - STOPPING TO BE REMOVED
- RED - RETURN ESCAPEWAY
- D - STOPPING WITH DOOR
- BLACK - FALL
- BLUE - WATER
- R - REGULATOR
- STOPPING
- = BULKHEAD

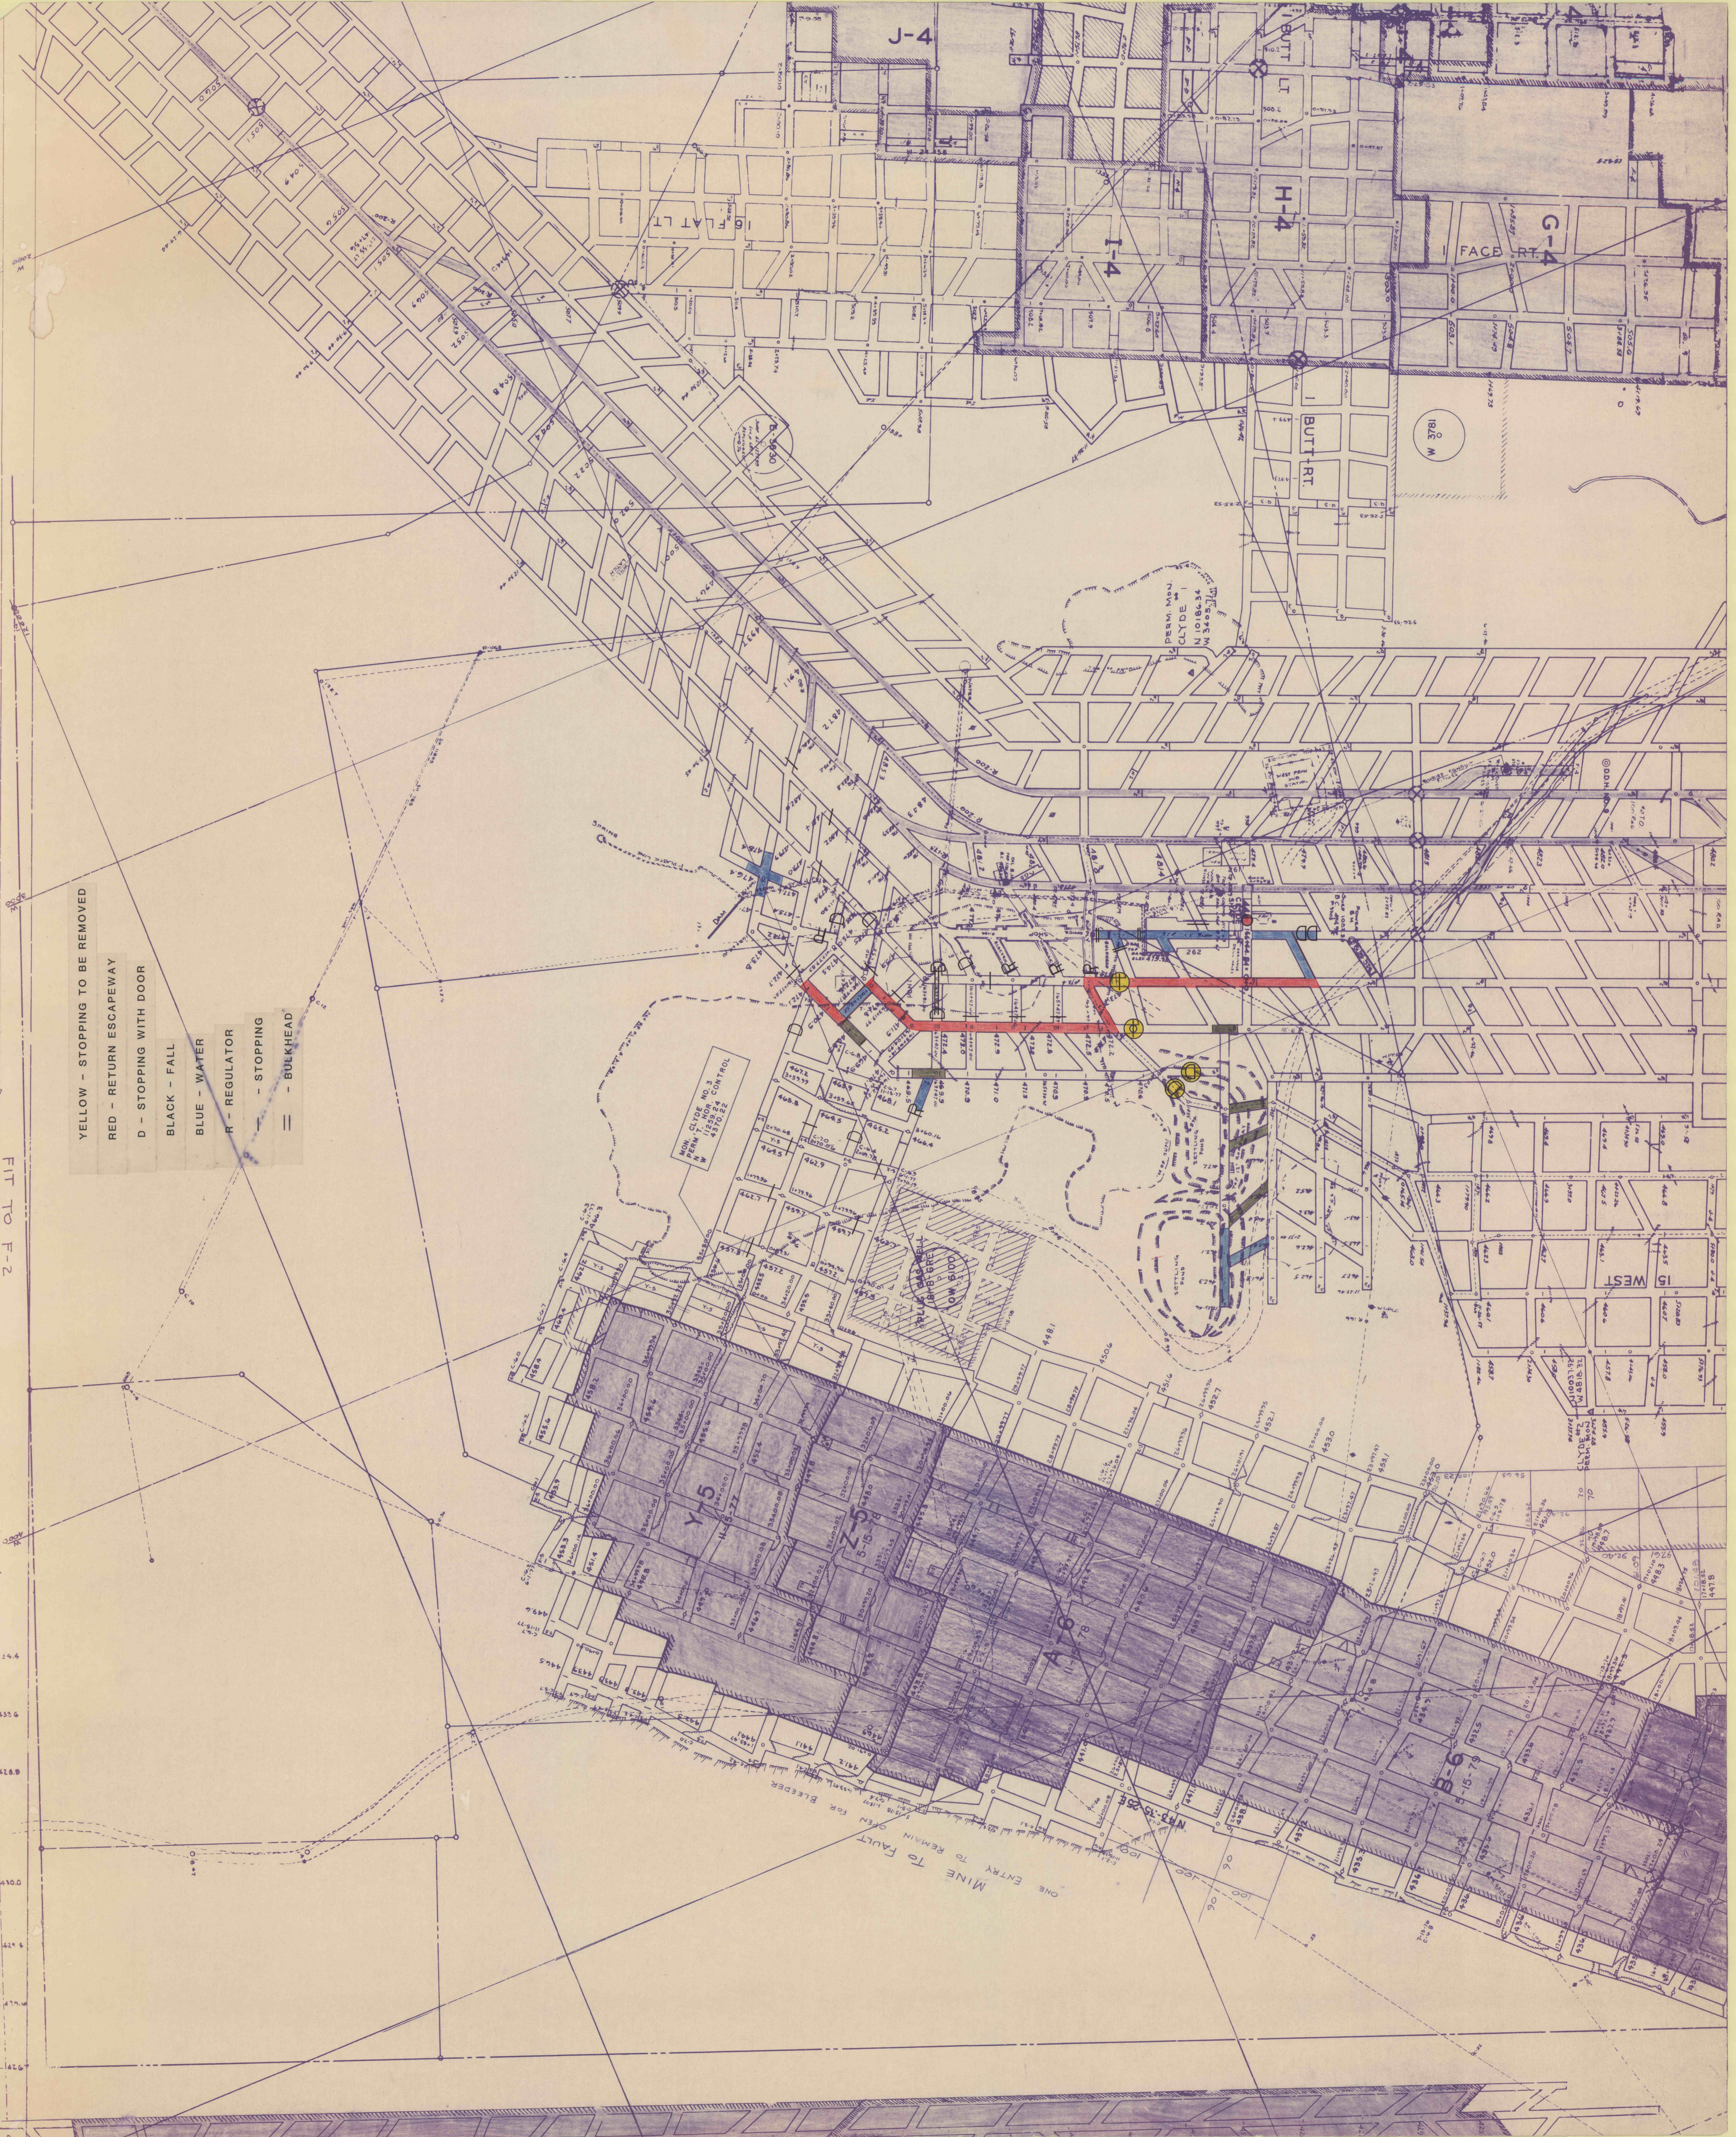

NOW CLYDE NO. 3 CONTROL
 M. PERM. MAJ. CLYDE I. N. 1018434
 M. 34053

MINE TO FAULT
 ONE ENTRY TO REMAIN OPEN
 FOR BLEEDER

1812 M

15 WEST