


005

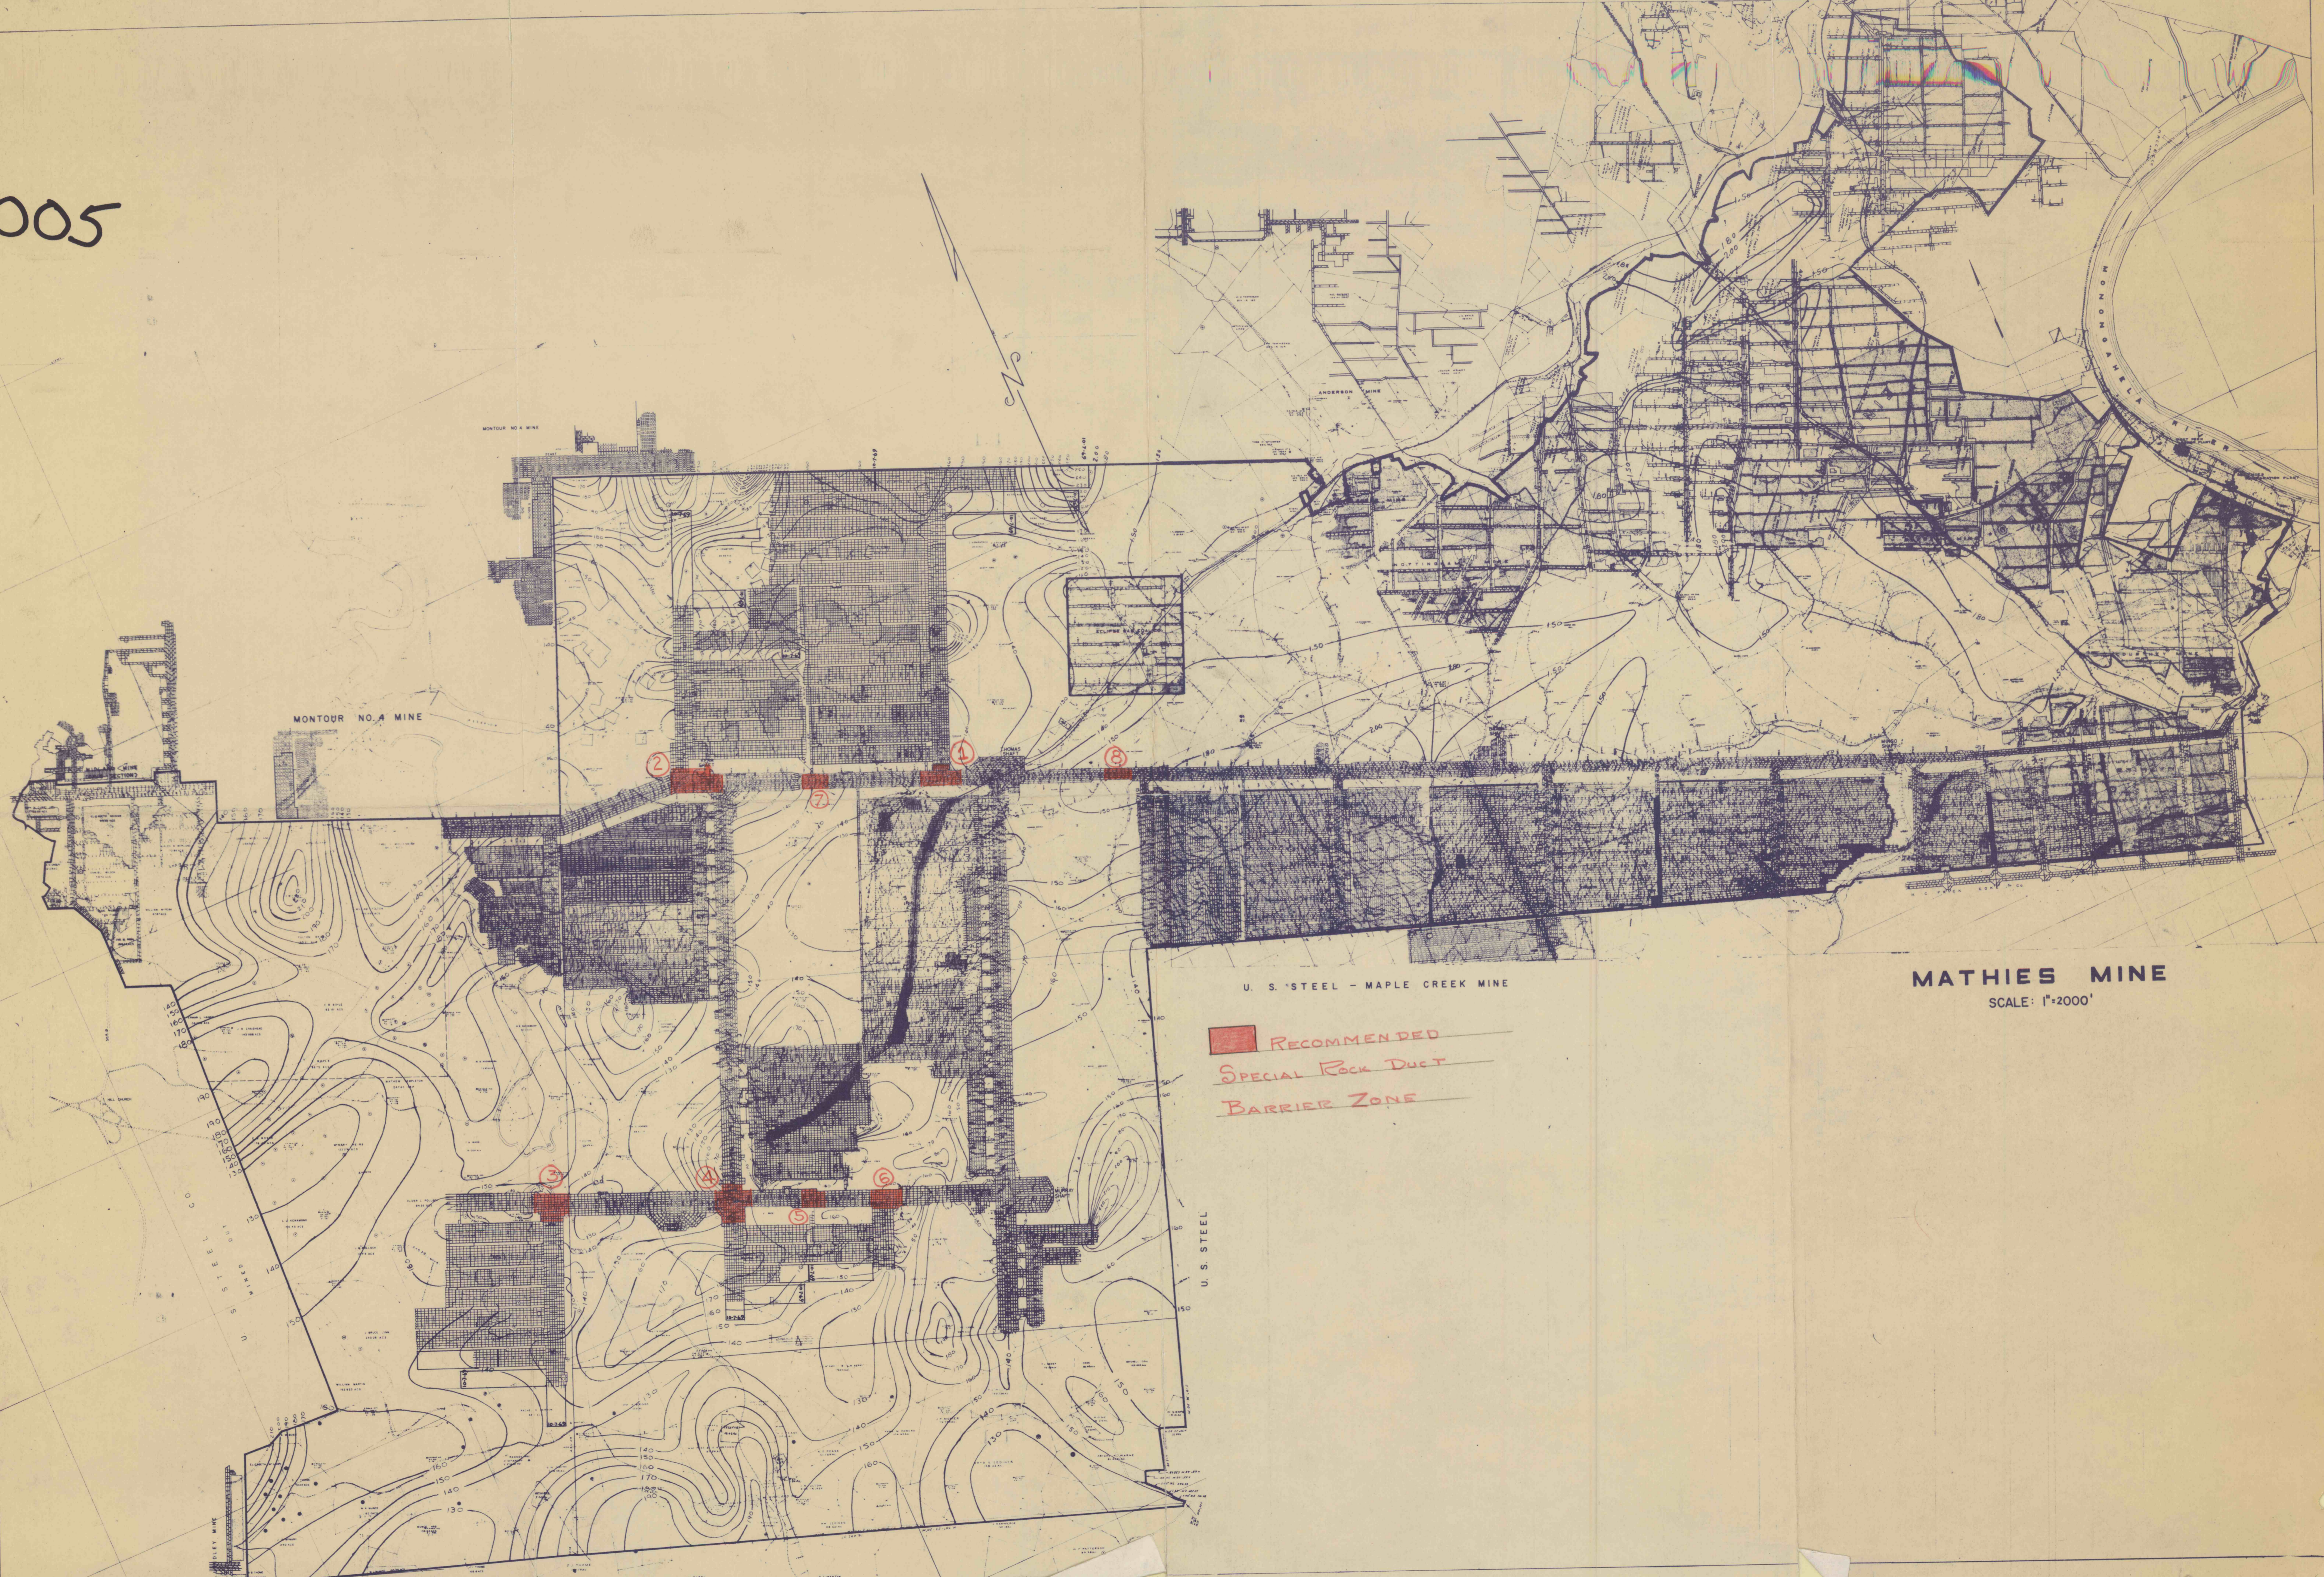


MONTOUR NO. 4 MINE

U. S. STEEL - MAPLE CREEK MINE

MATHIES MINE

SCALE: 1"=2000'

 RECOMMENDED  
SPECIAL ROCK DUCT  
BARRIER ZONE

U. S. STEEL