


JACOB NYLAND

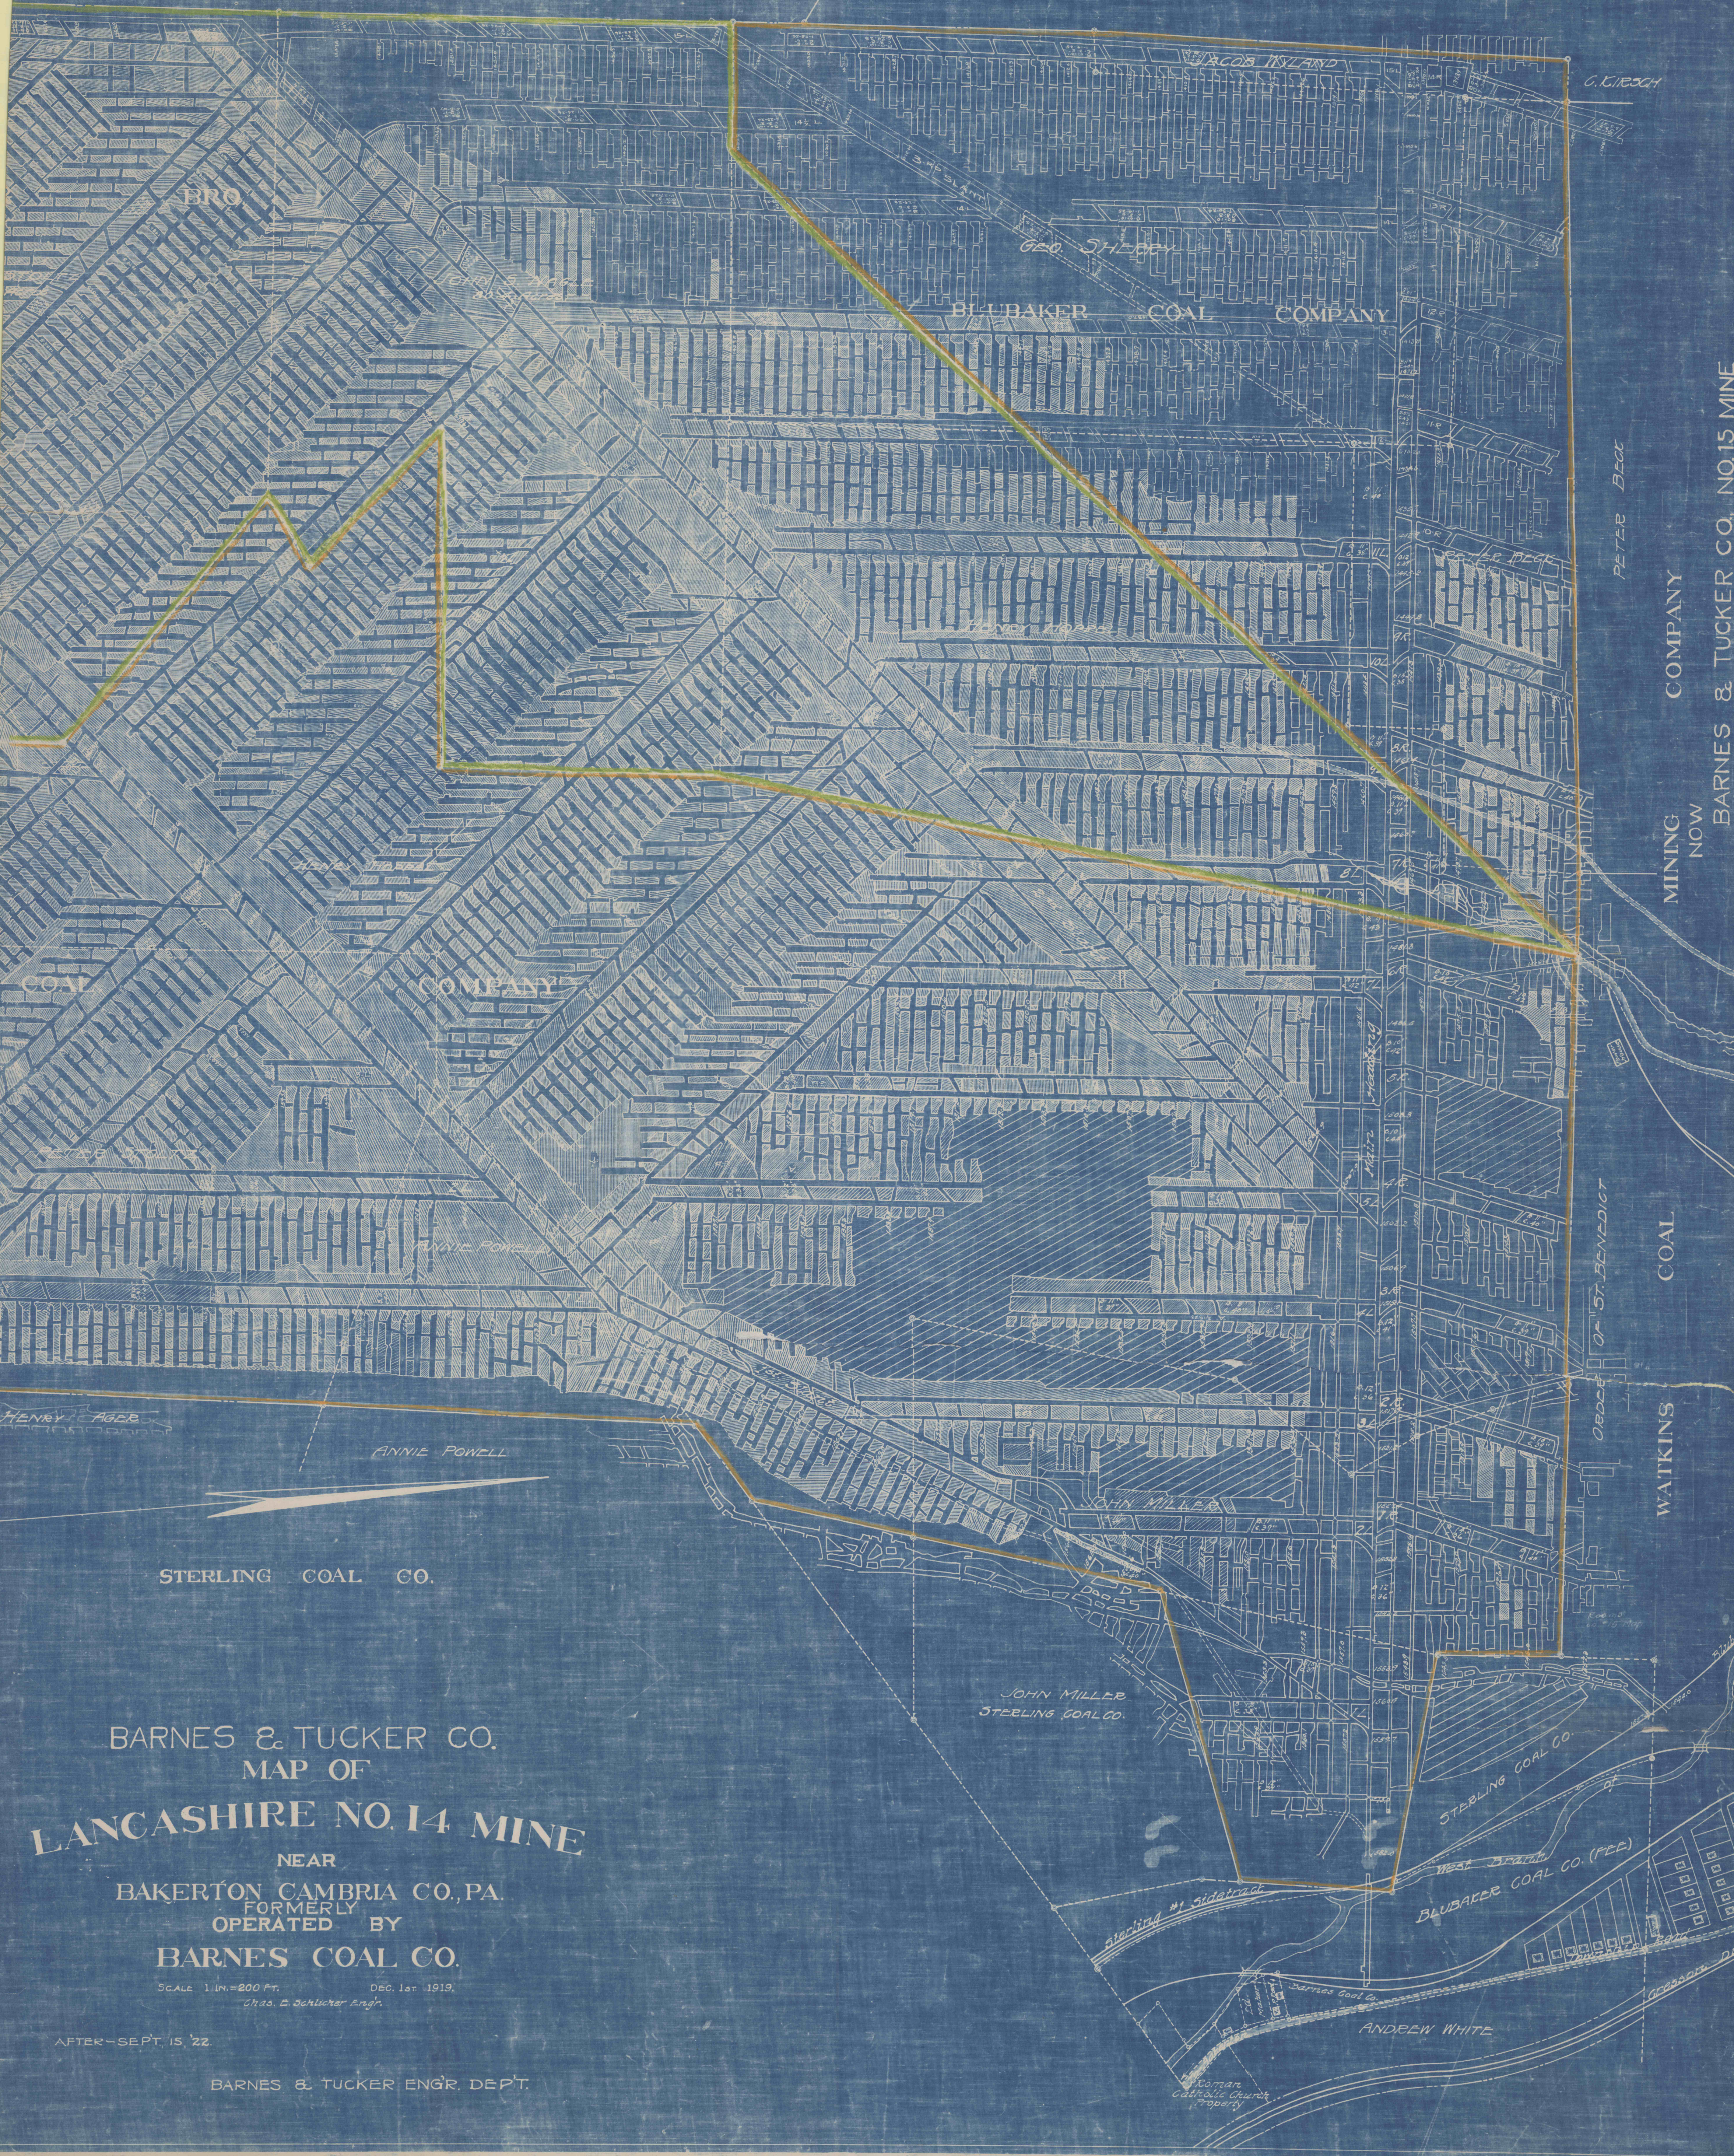

C. GIESCH

BRO

GEO. STEELEN

BILBAKER COAL COMPANY

PETER BEAC

MINING COMPANY NOW

BARNES & TUCKER CO., NO. 15 MINE

COAL COMPANY

COAL

WATKINS

STERLING COAL CO.

ANNIE POWELL

JOHN MILLER  
STERLING COAL CO.

STERLING COAL CO.

BLUBAKER COAL CO. (P.L.L.)

ANDREW WHITE

BARNES & TUCKER CO.  
 MAP OF  
**LANCASHIRE NO. 14 MINE**  
 NEAR  
 BAKERTON CAMBRIA CO., PA.  
 FORMERLY  
 OPERATED BY  
**BARNES COAL CO.**

SCALE 1 IN. = 200 FT. DEC. 1st 1919.  
Chas. L. Schlichter Engr.

AFTER-SEPT. 15, '22.

BARNES & TUCKER ENGR. DEPT.

Roman Catholic Church Property