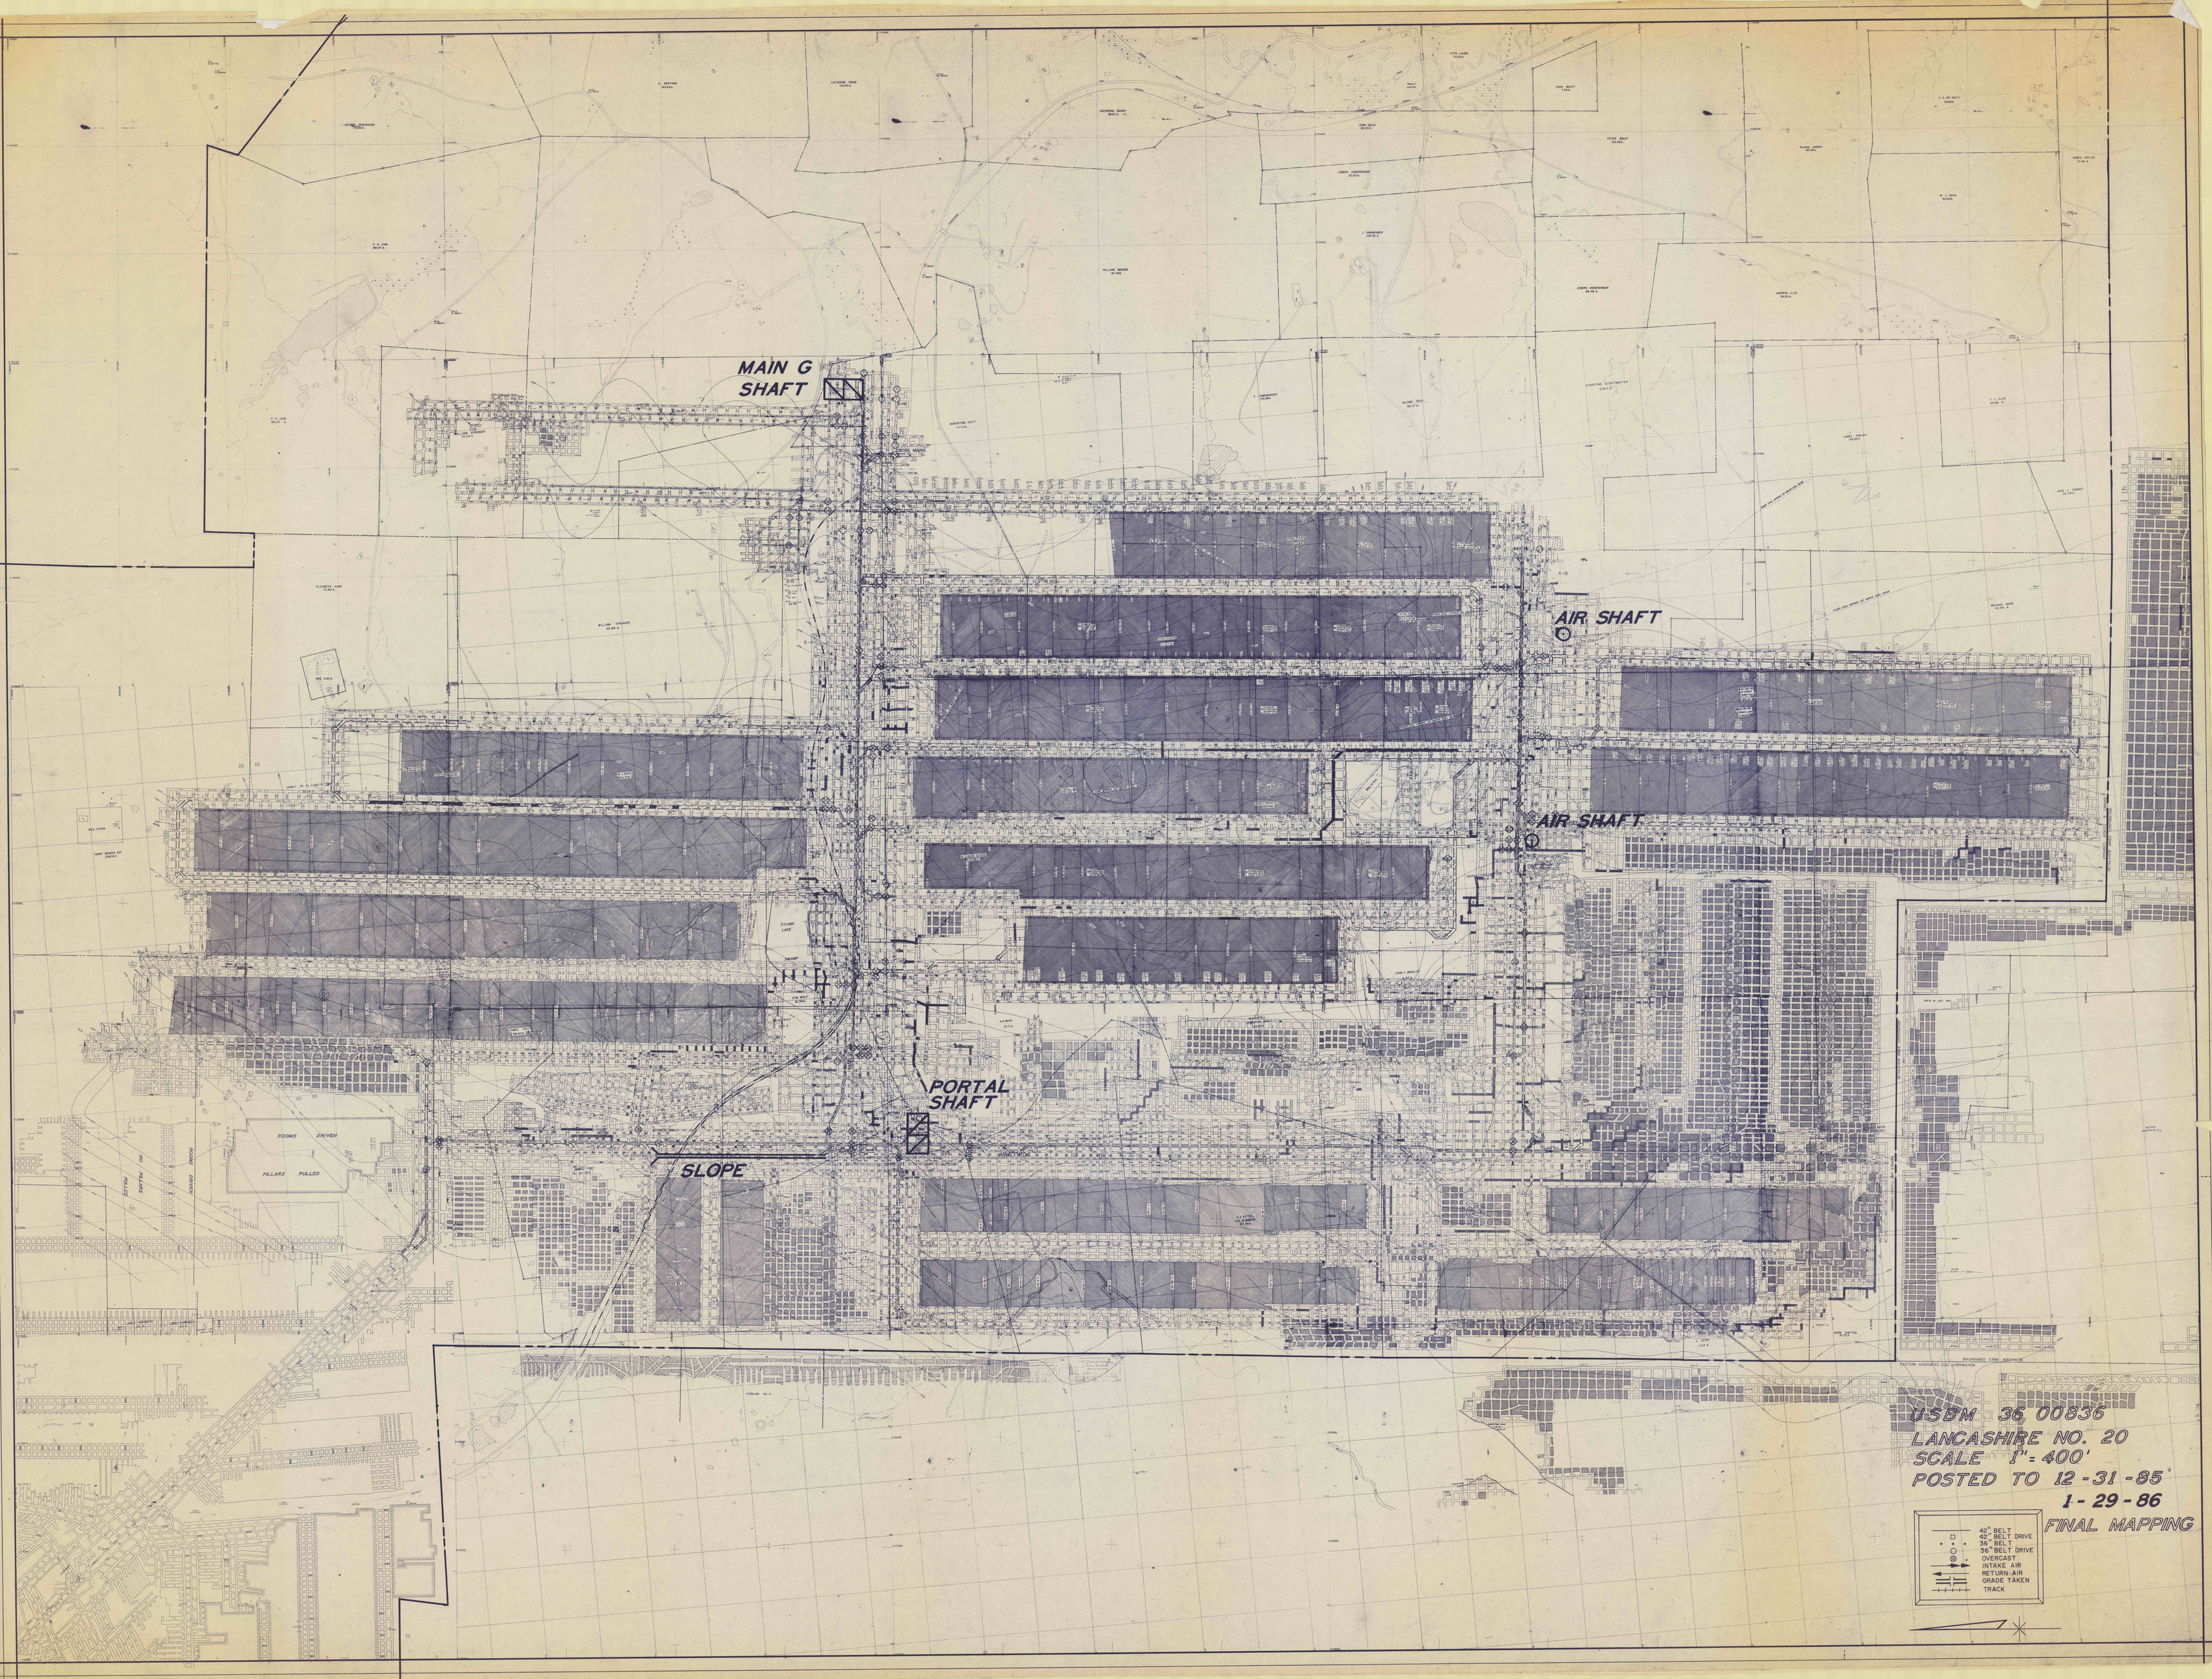
MAIN G SHAFT
AIR SHAFT
AIR SHAFT
PORTAL SHAFT
SLOPE
ROOMS DRIVEN
PILLARS PULLED
USBM 36 00836
LANCASHIRE NO. 20
SCALE 1" = 400'
POSTED TO 12-31-85
1-29-86
FINAL MAPPING
42" BELT
42" BELT DRIVE
36" BELT
36" BELT DRIVE
OVERCAST
INTAKE AIR
RETURN AIR
GRADE TAKEN
TRACK