1"=400'

OLD
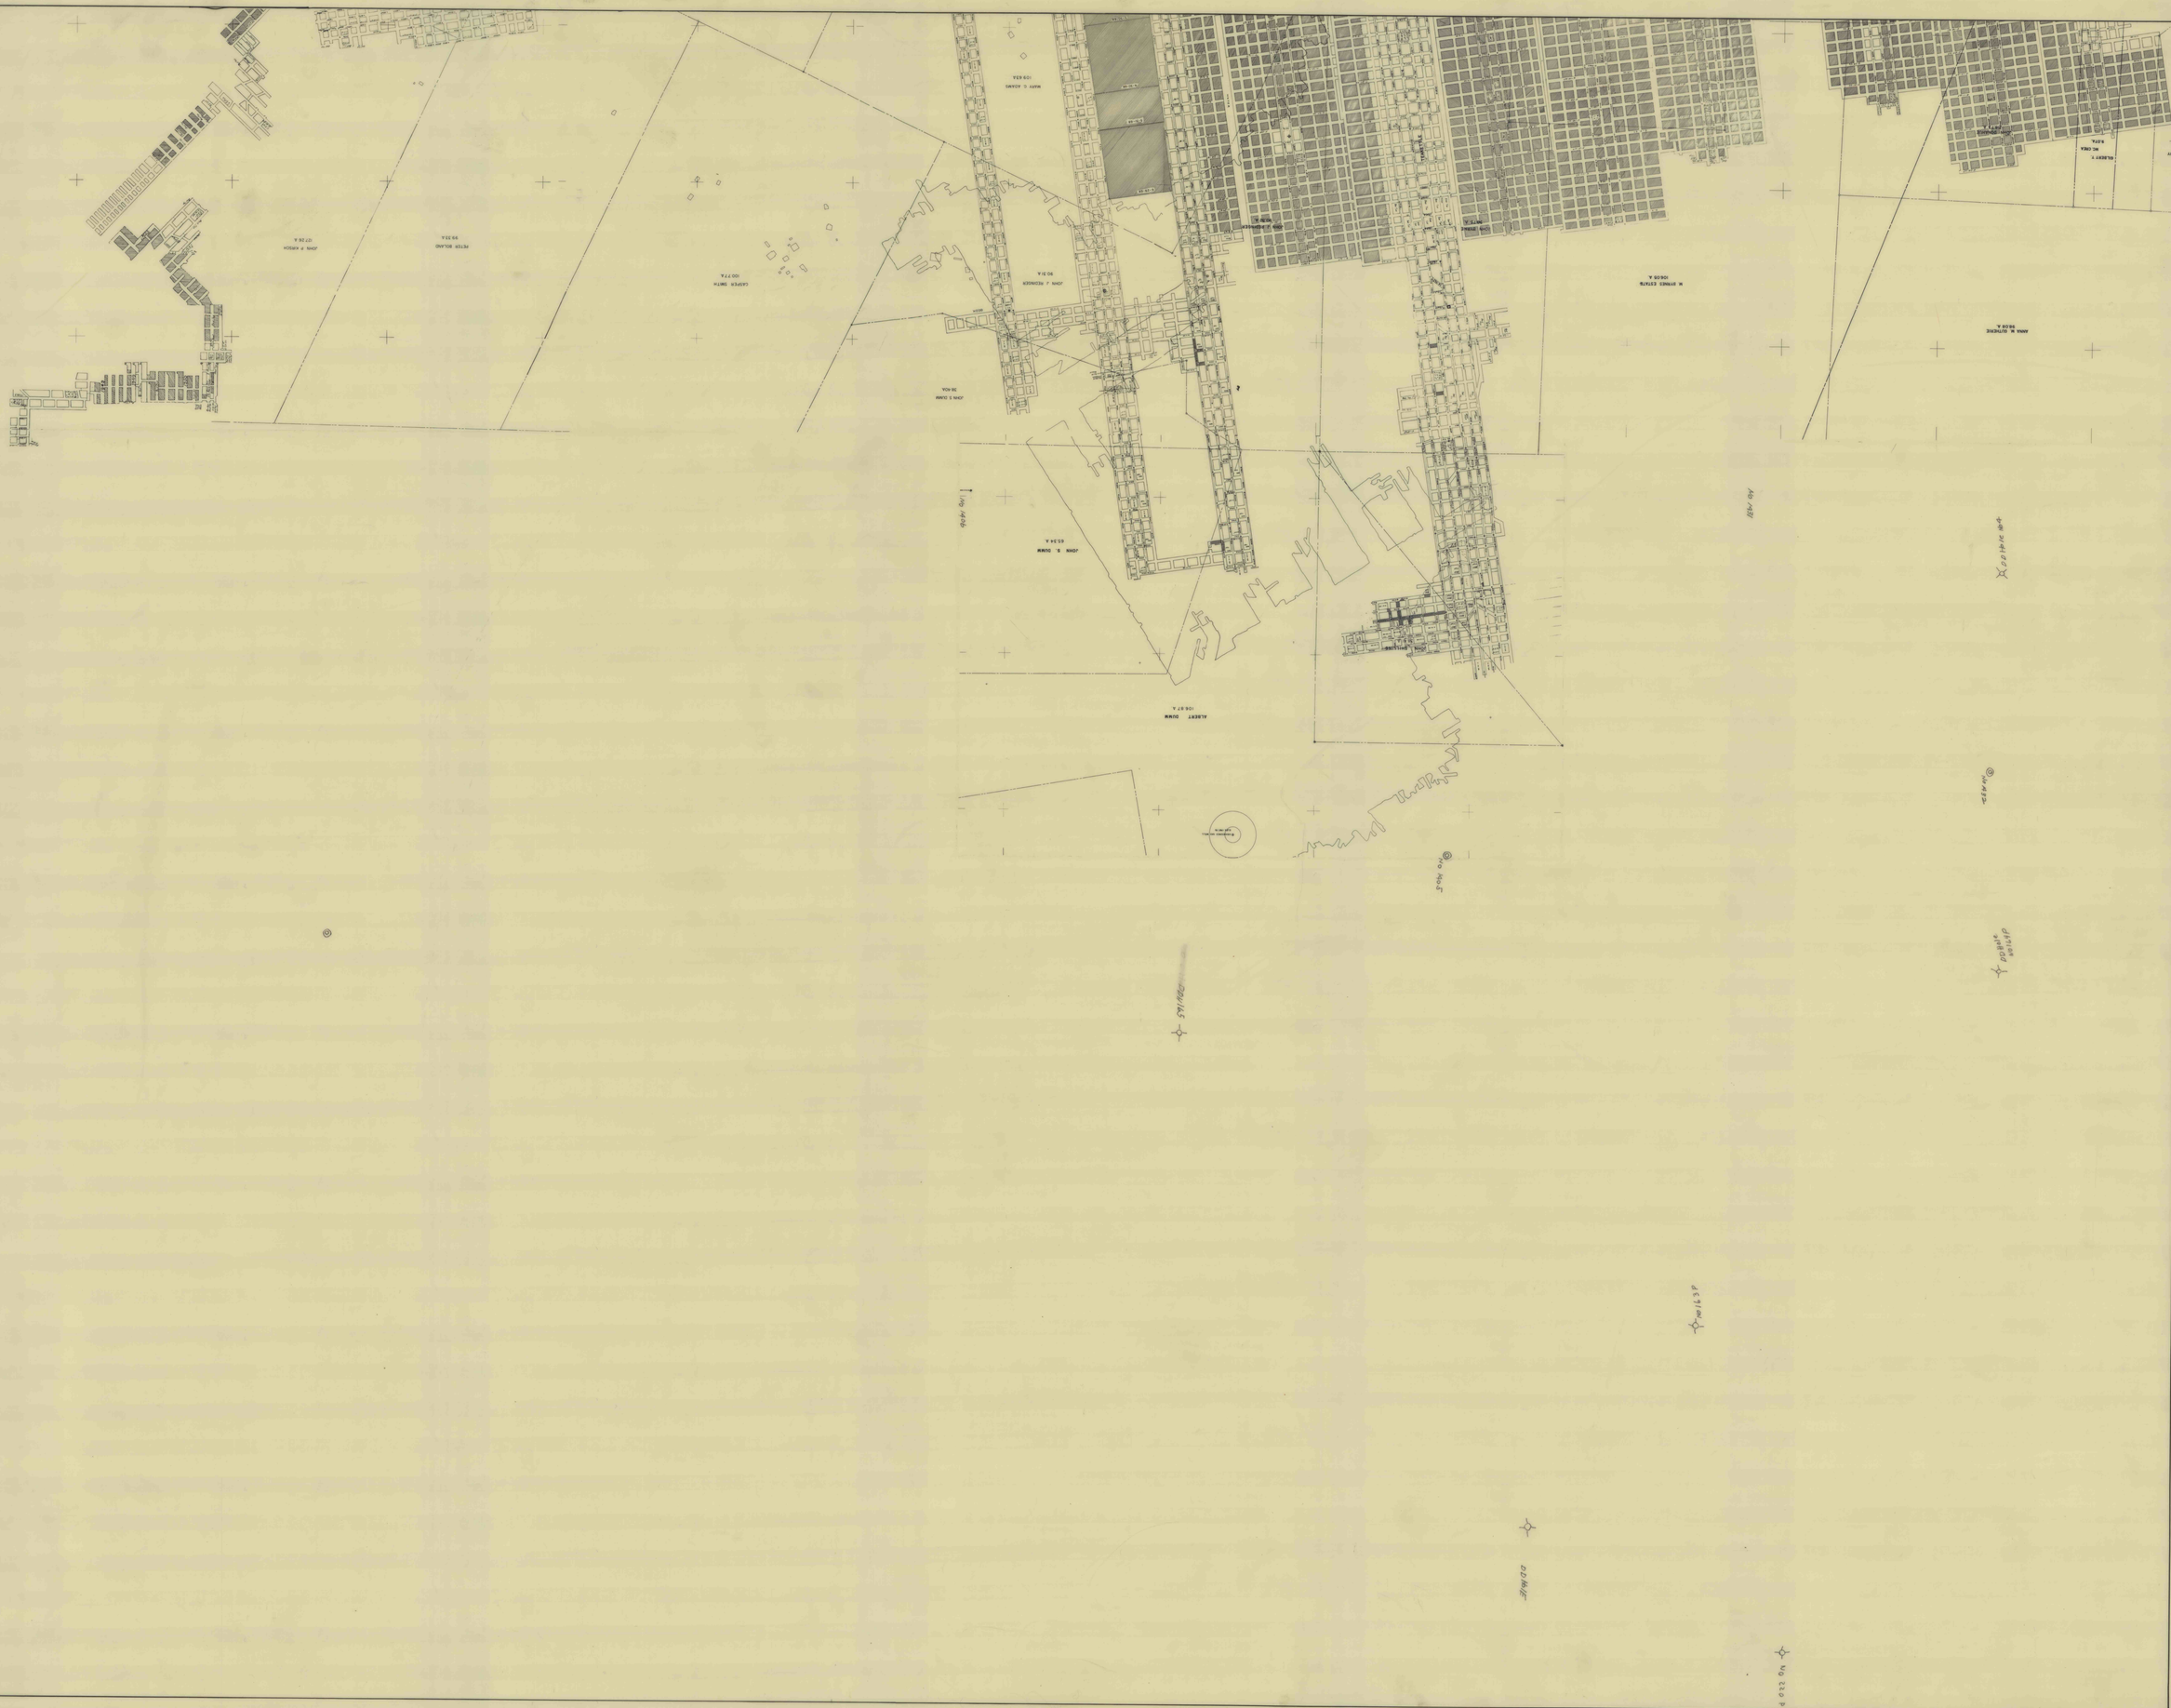
8 SIDM