


049

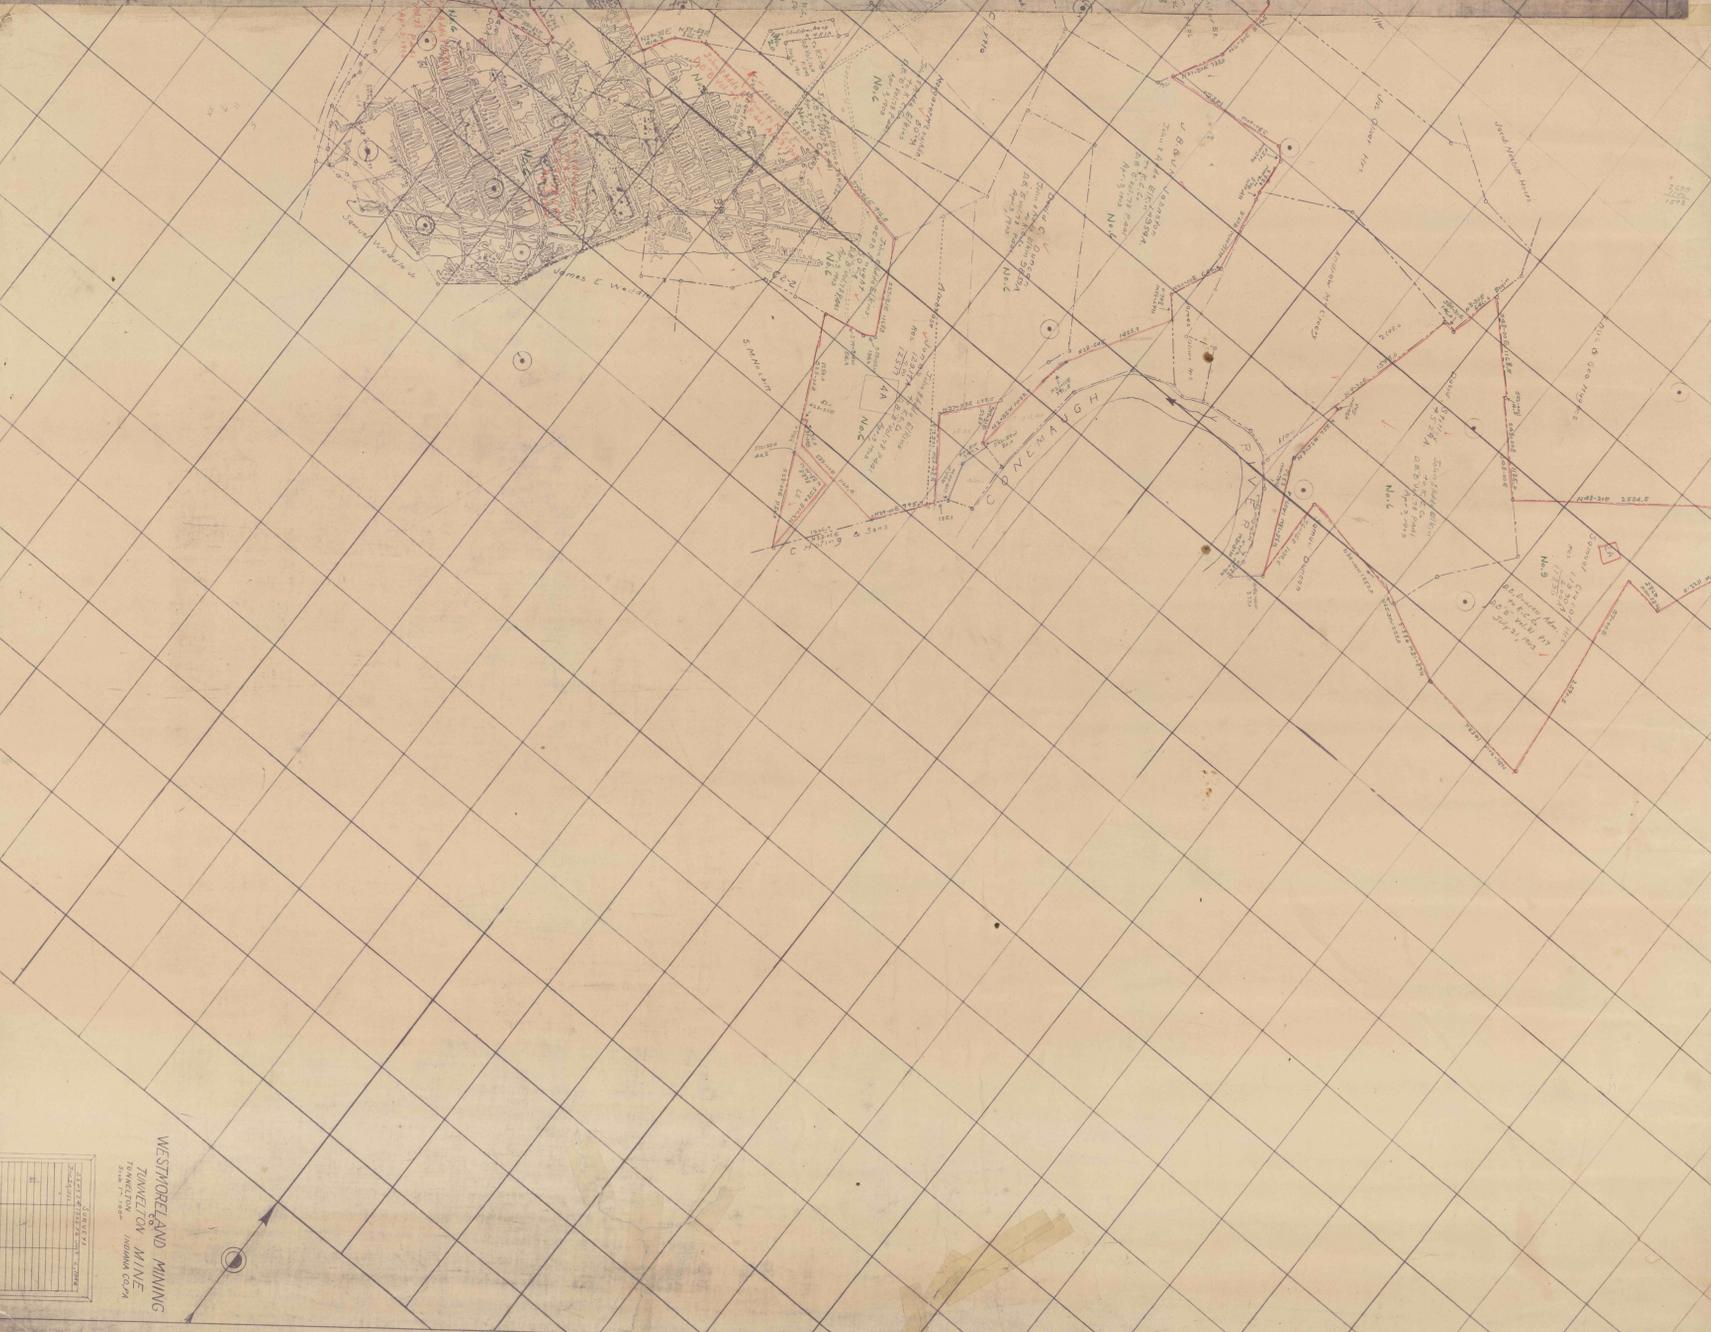

