


POLAND MINE
 DUNKARD MINING CO
 LARRY J. CHESSEBEE
 MONONGAHELA CO., GREENE CO.
 SCALE 1" = 200 FEET 2-22-67
 William H. Threlkover
 25-1770E

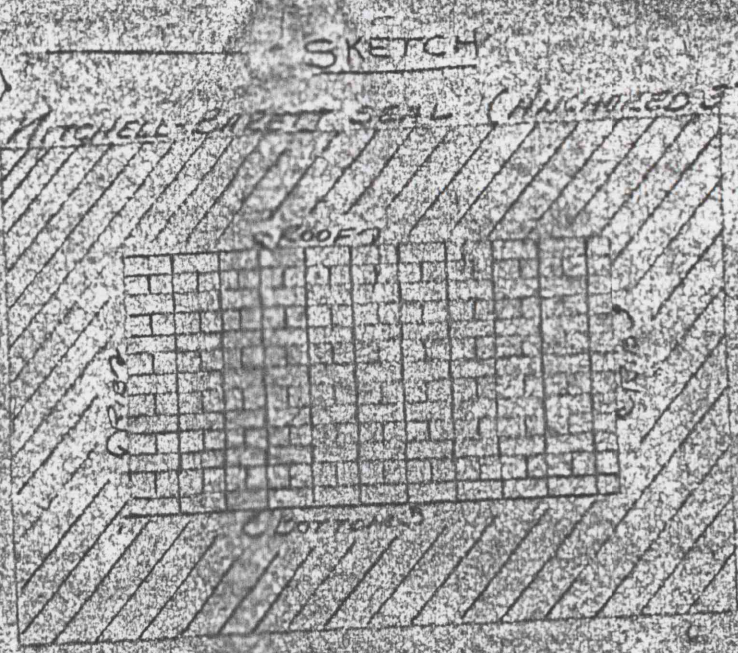

SKETCH
 SEALS ARE 16" THICK
 COMPLETED BY 5000 CUB. YDS.

