

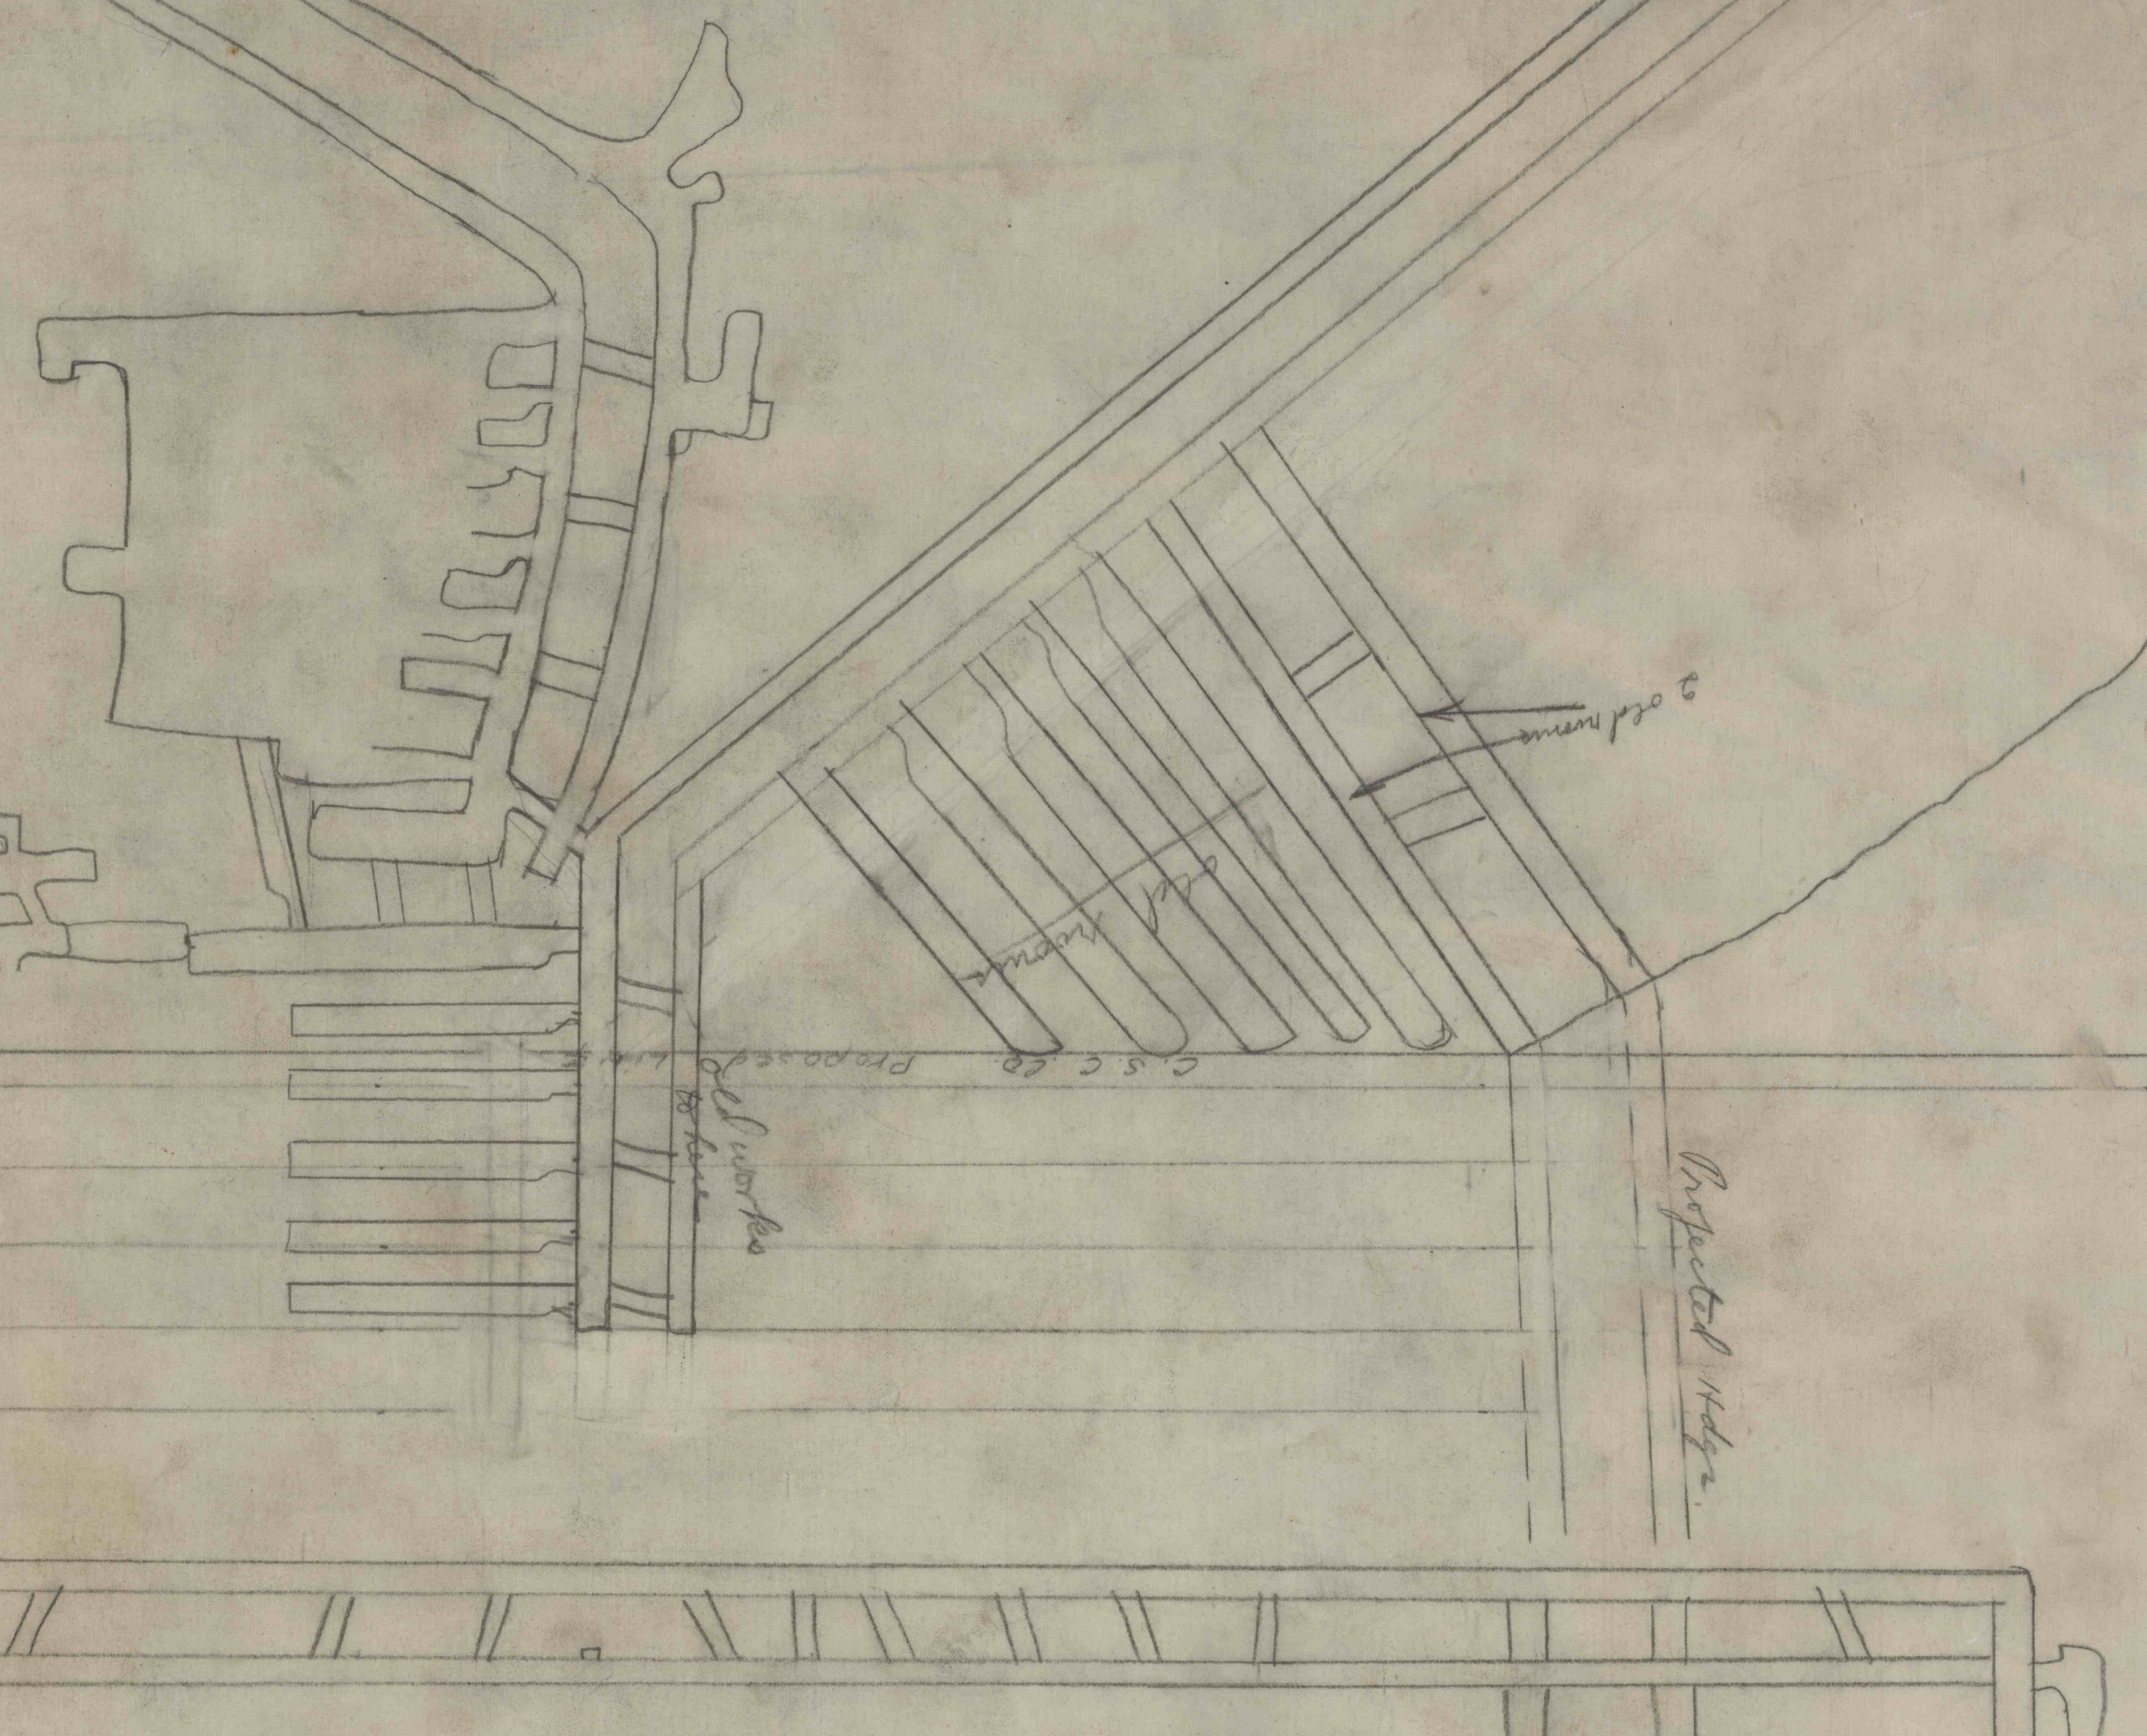
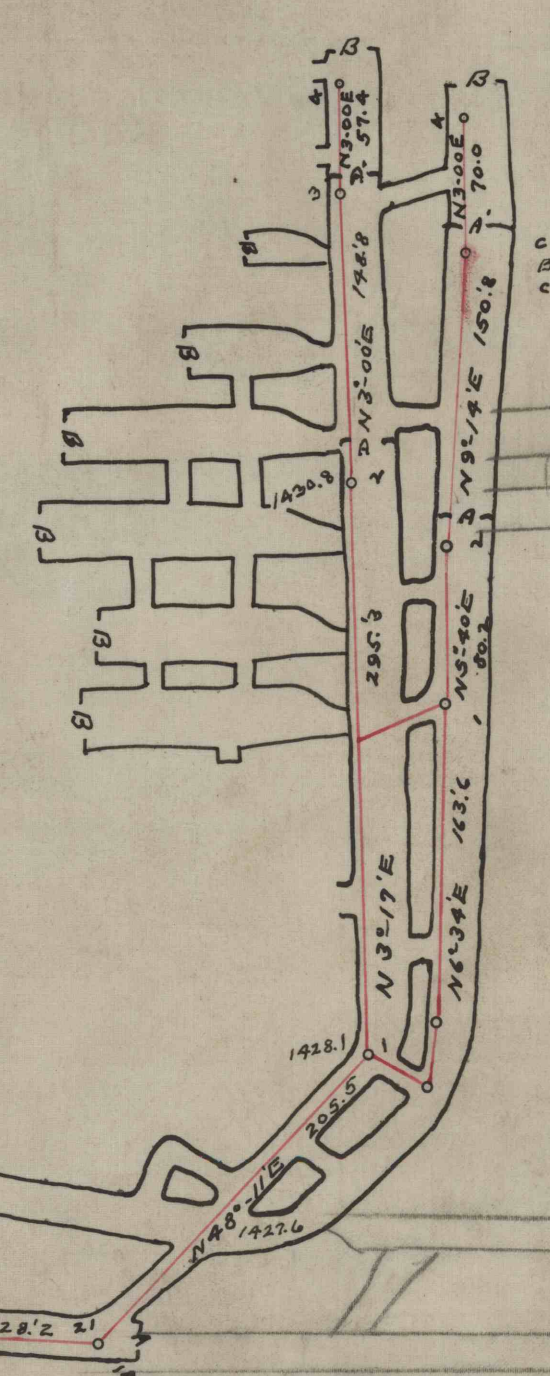
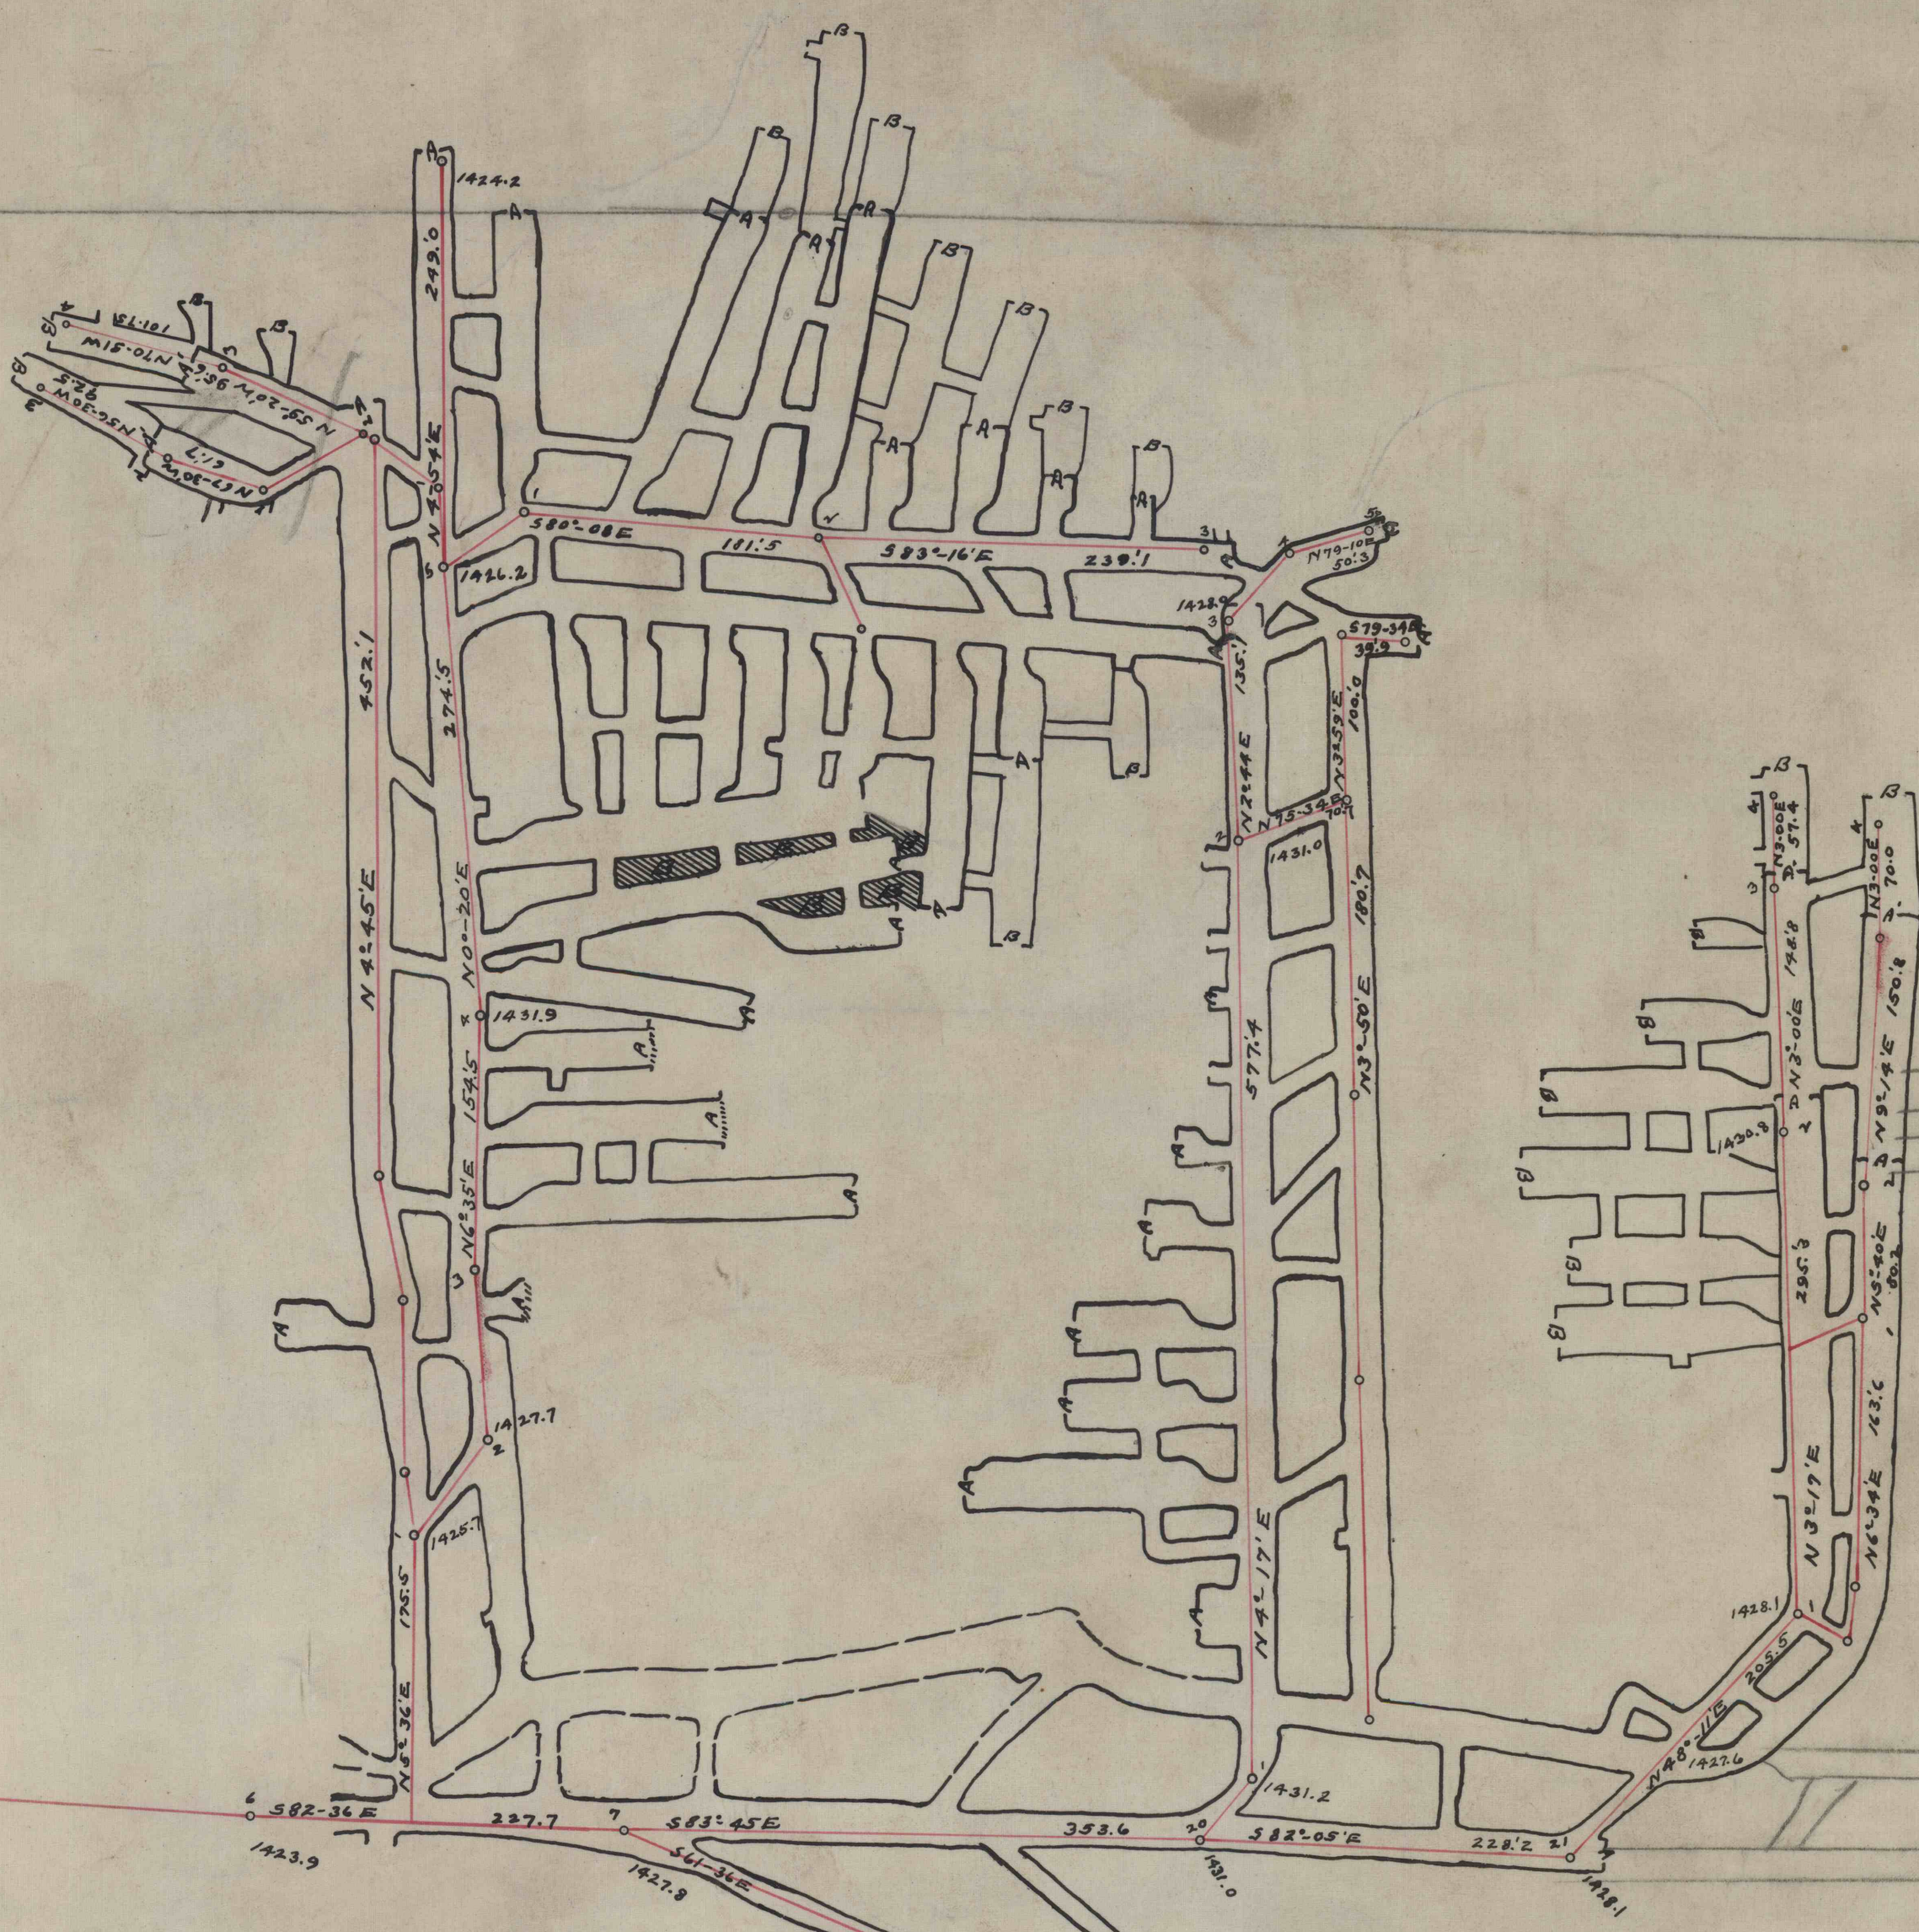
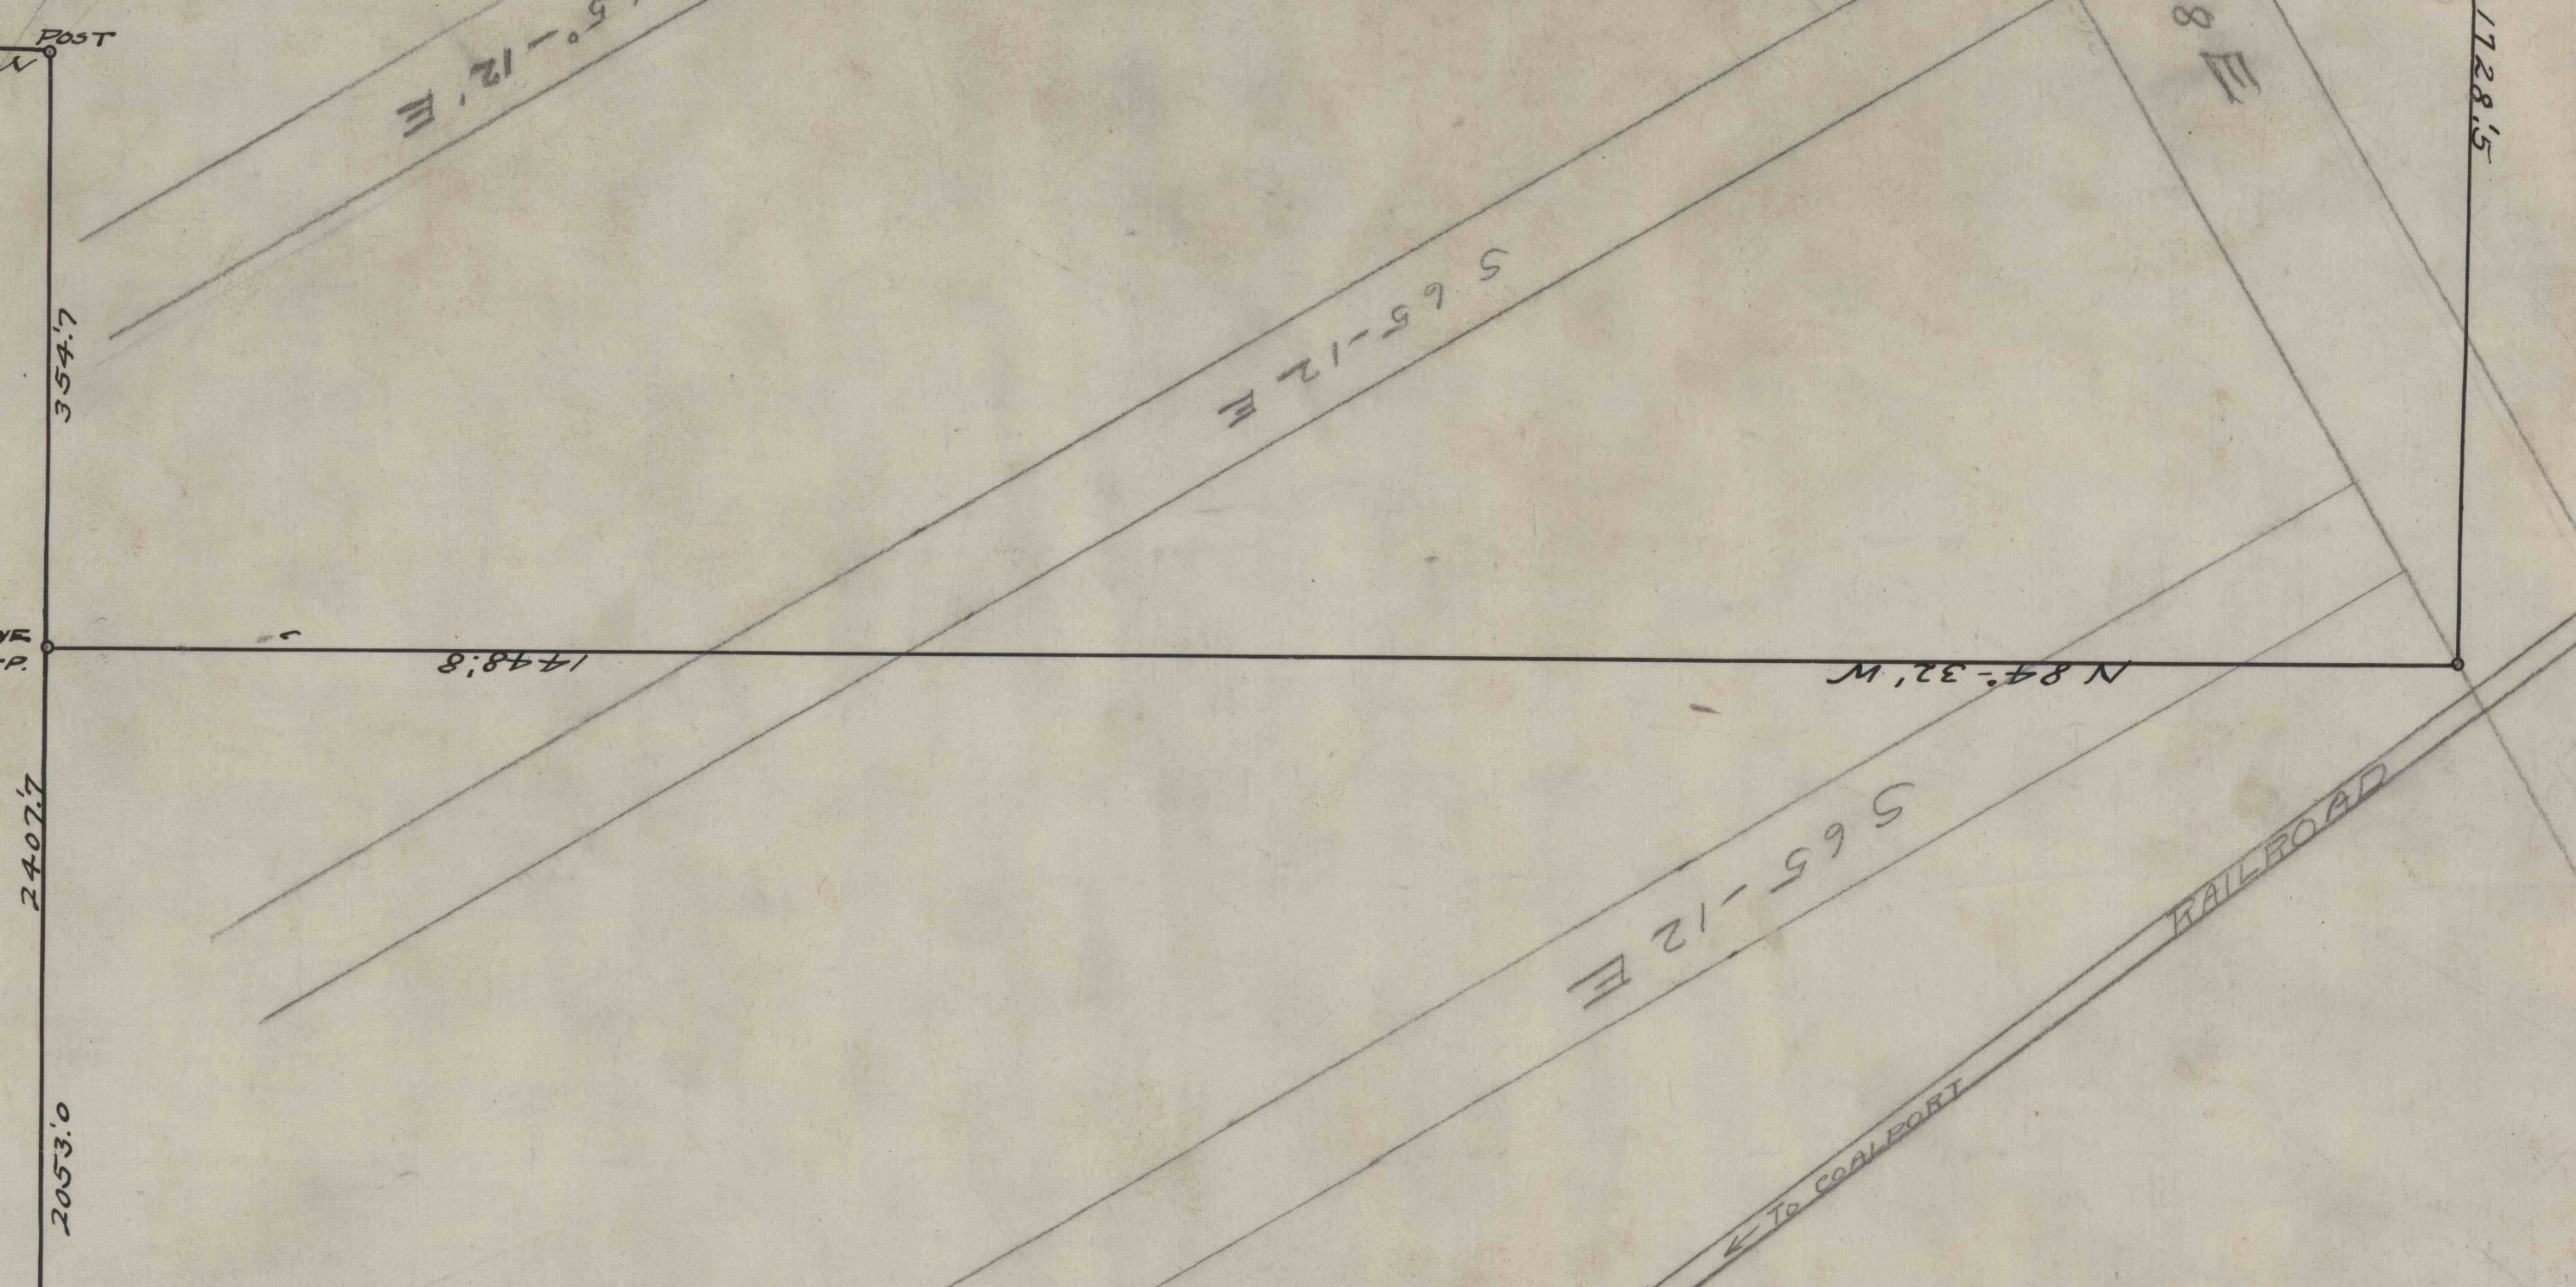


300
200
100
0

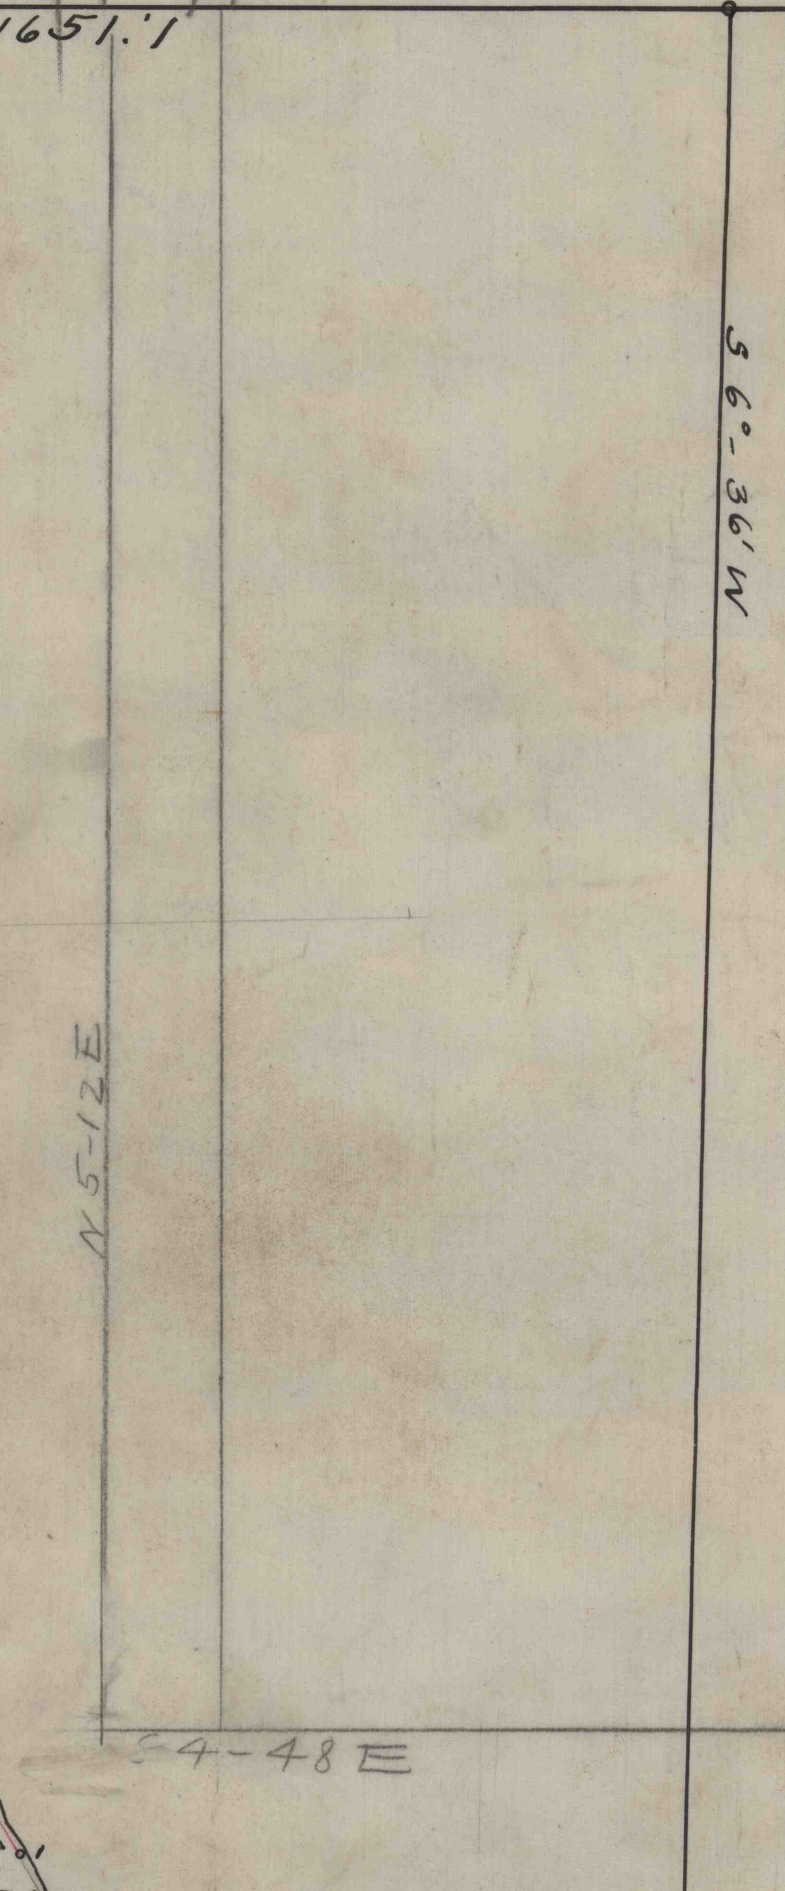

unfilled road

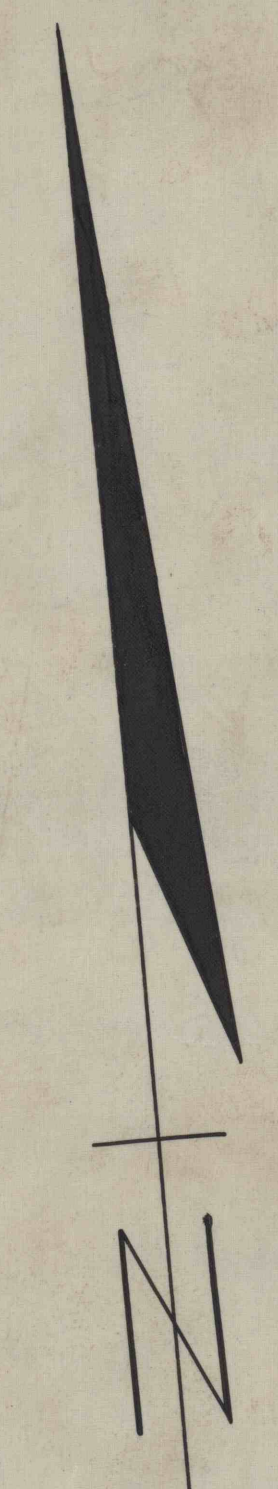

STONES

2000.0

N 82.55 W