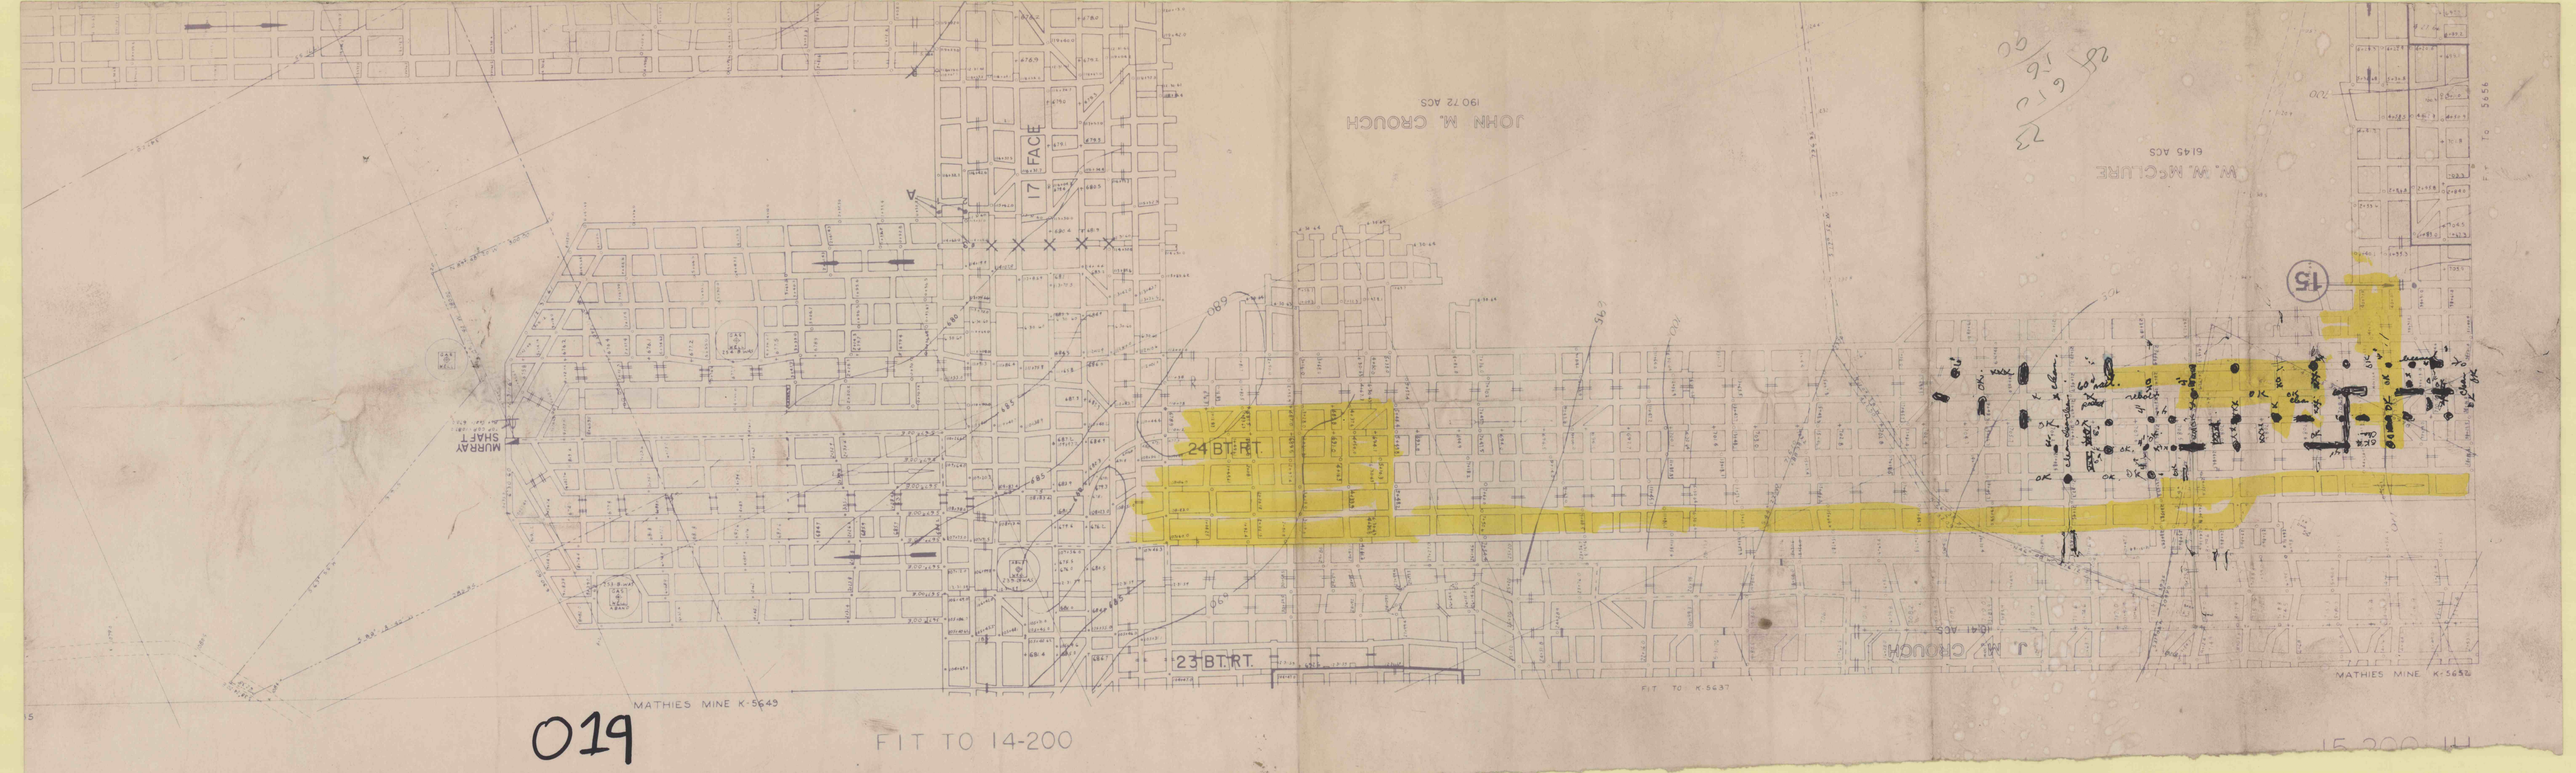
17 FACE
24 BT. RT.
23 BT. RT.
MURRAY SHAFT
JOHN M. CROUCH
1972 ACS
W. W. McCLURE
6145 ACS
J. M. CROUCH
1041 ACS
15
MATHIES MINE K-5649
FIT TO K-5637
MATHIES MINE K-5652
FIT TO 14-200
019