

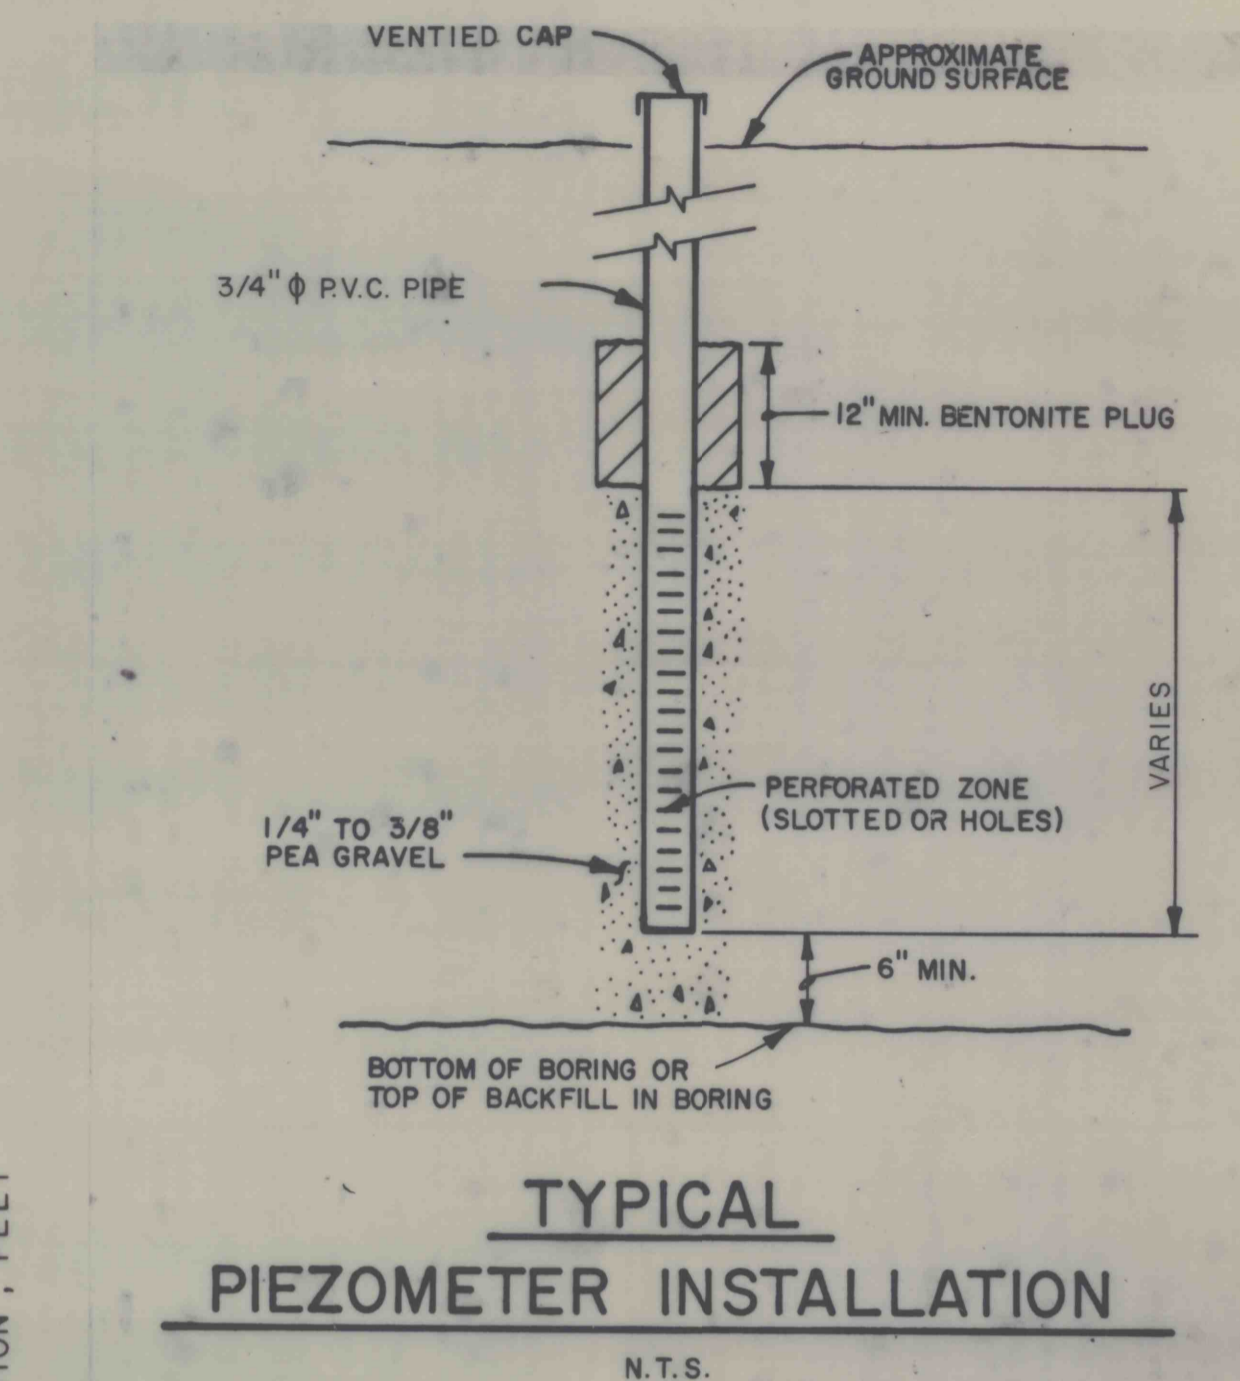


DRAWING NUMBER B77-801-E15  
 DRAWN BY RAL 3-9-81  
 CHECKED BY ZGC  
 APPROVED BY JSD

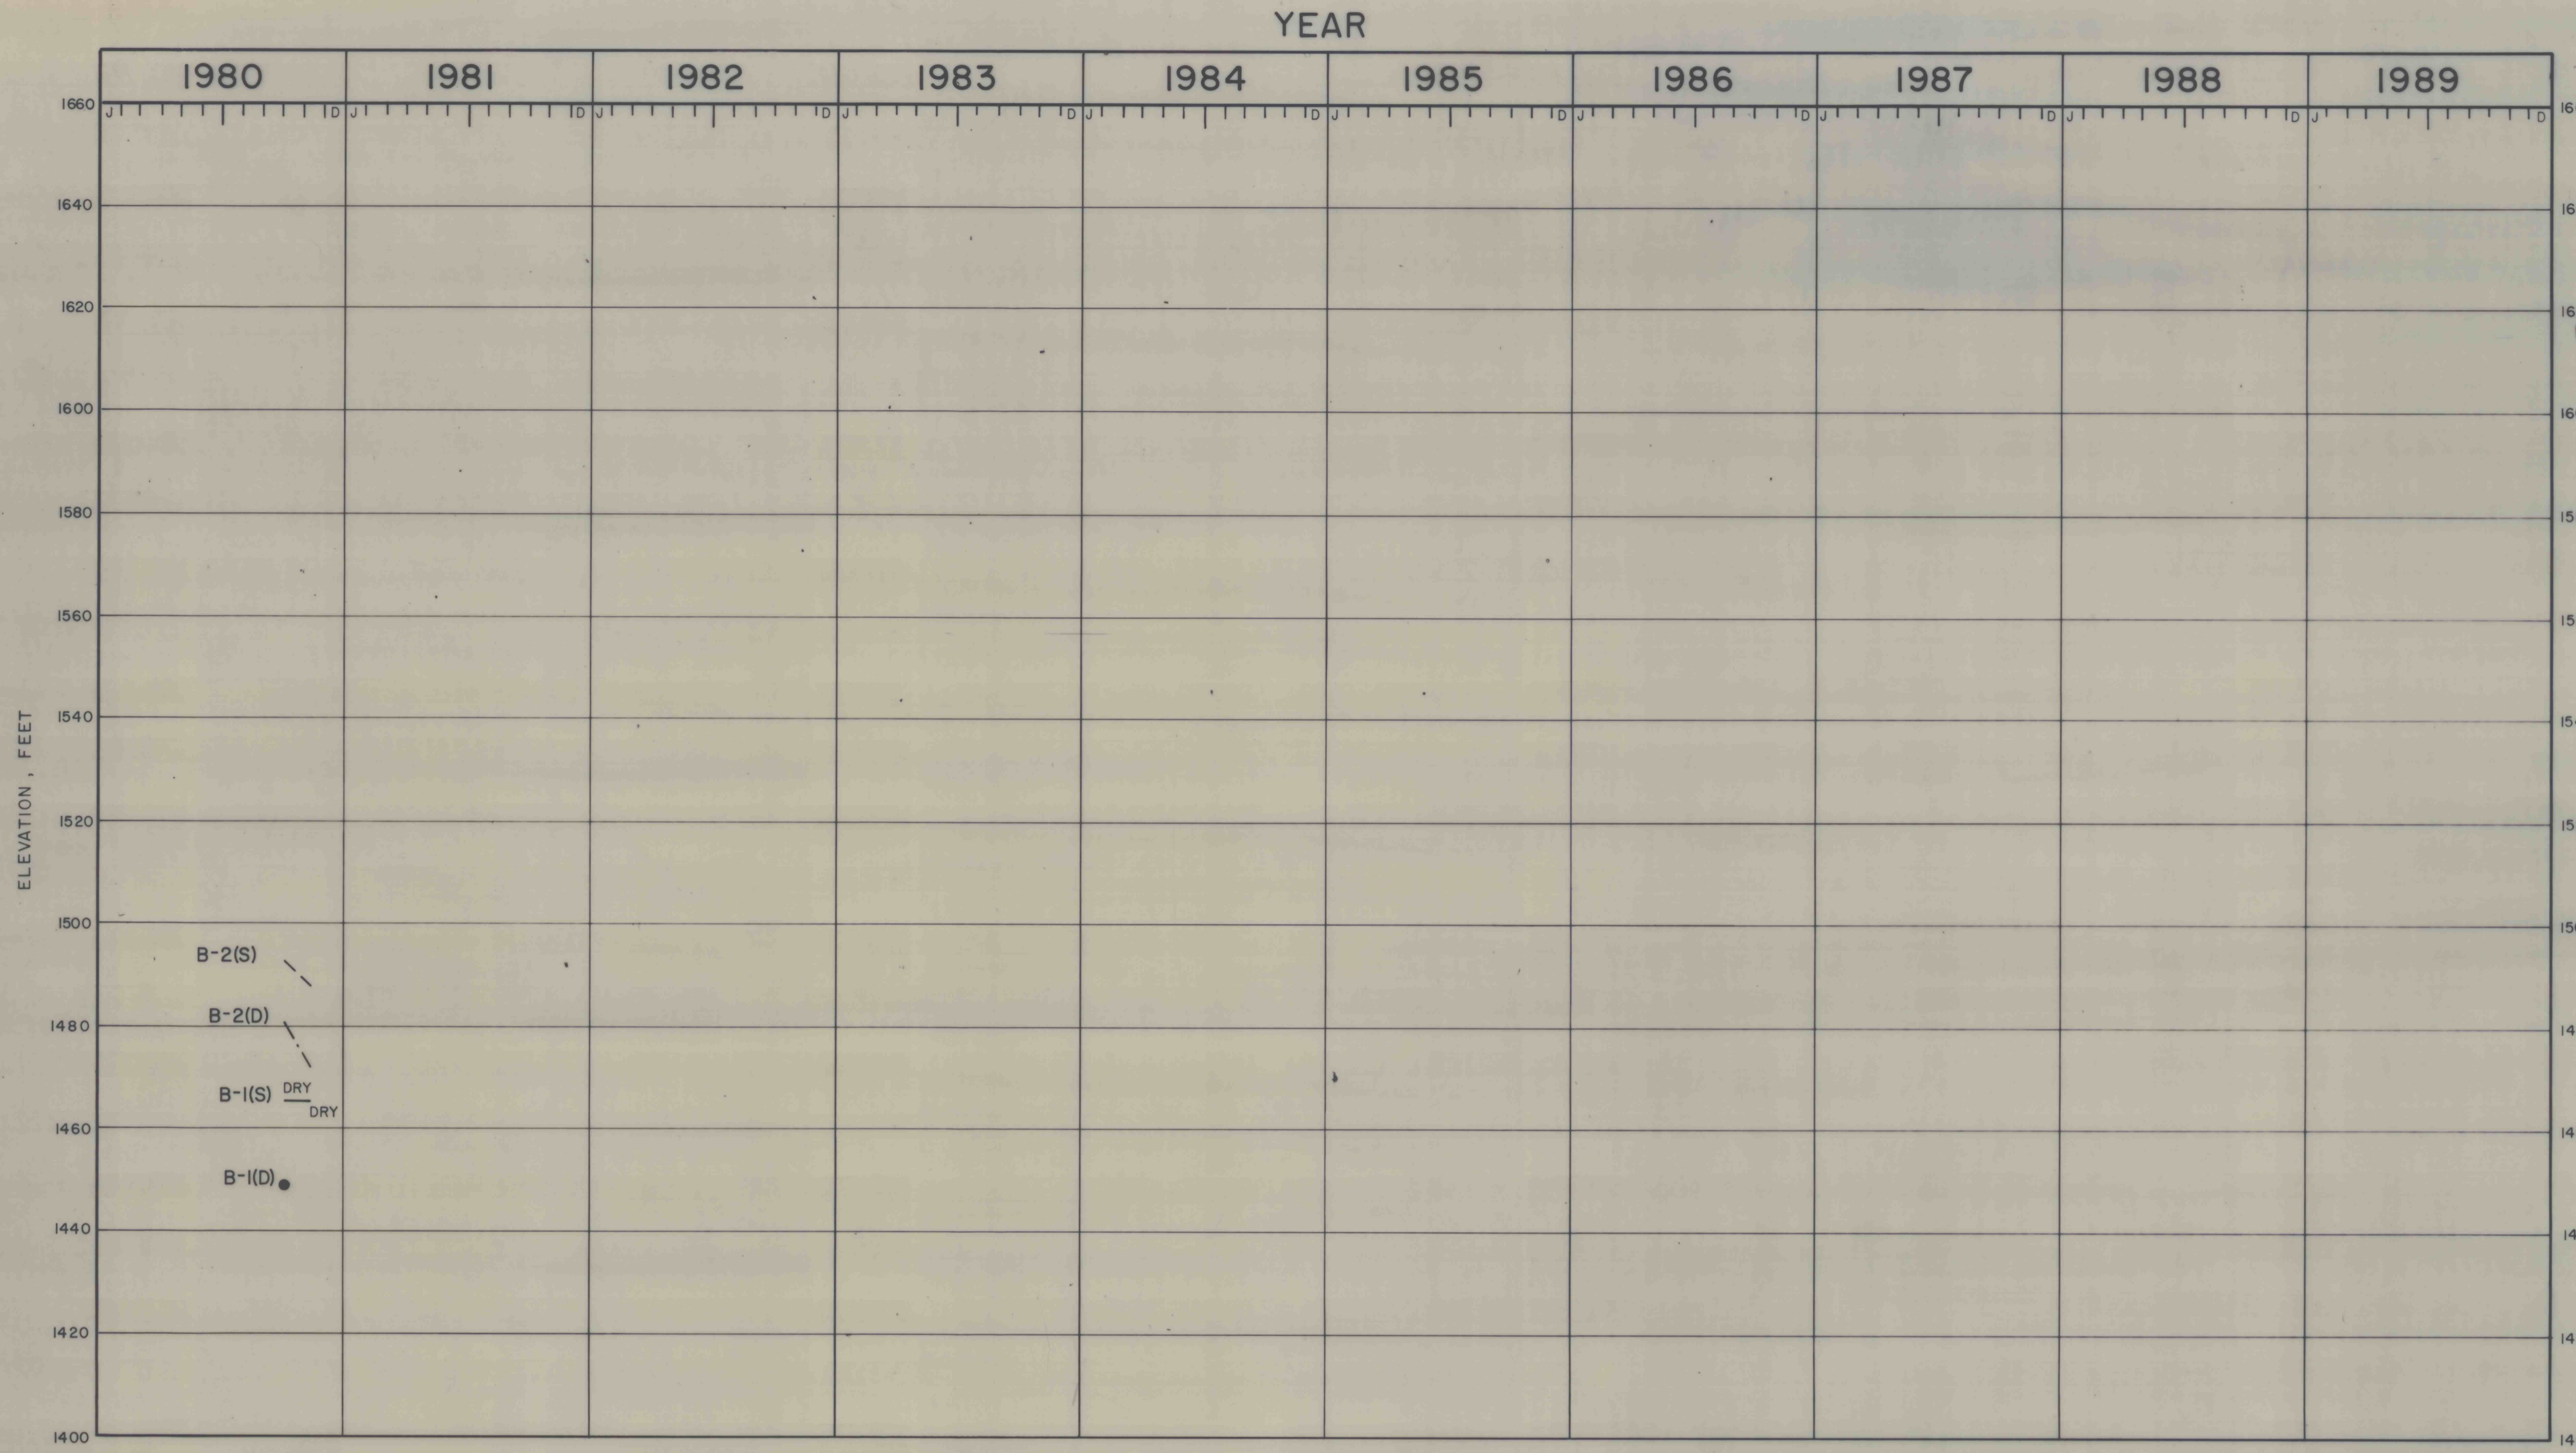

PIEZOMETER INSTALLATION DATA			
PIEZOMETER NO.	ELEVATION, FEET		
	TOP OF PIPE	TIP	BOTTOM OF BORING
B-1S	1525.0	1465.7	1421.8
B-1D	1525.1	1436.5	1421.8
B-2S	1532.9	1493.4	1461.9
B-2D	1530.9	1467.9	1461.9

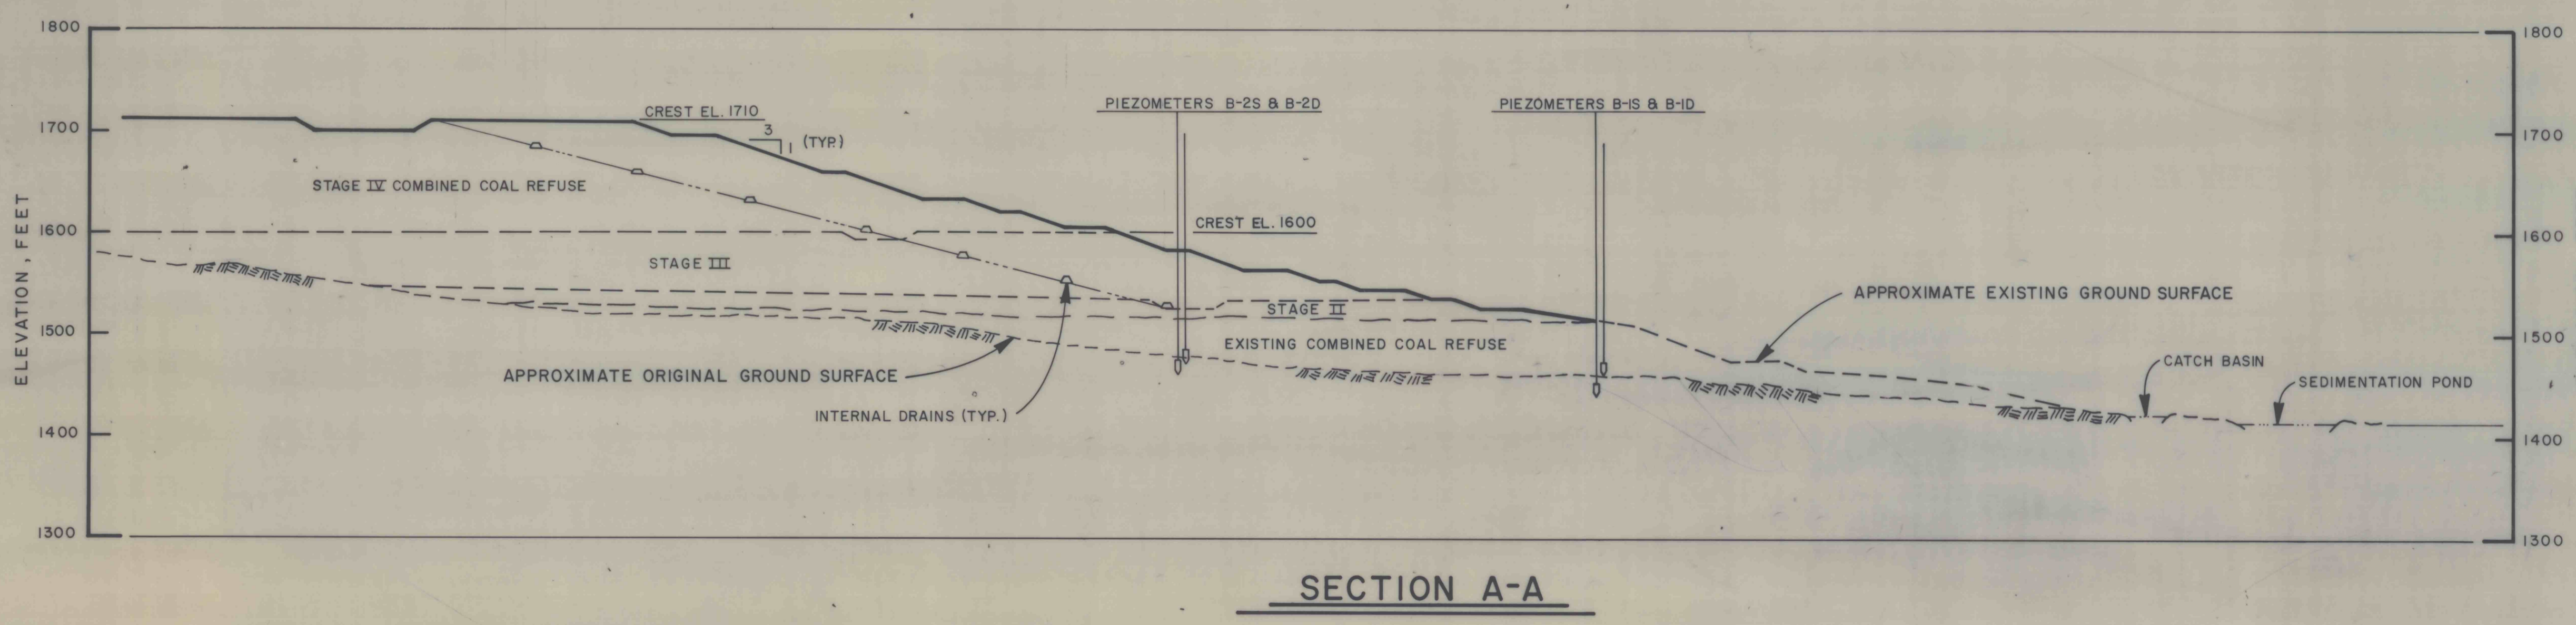

VERTICAL SCALE  
20 0 20 40 FEET

DRAWING NO. <b>B77-801-E15</b>	SHEET NO. <b>9 OF 12</b>	FIGURE NO. <b>5</b>
-----------------------------------	-----------------------------	------------------------

**PIEZOMETER READINGS: YEARS 1980 - 1989**  
 COAL REFUSE DISPOSAL FACILITY  
 MINE NO. 81  
 BETHLEHEM MINES CORPORATION  
 DRENNEN, WEST VIRGINIA  
 PREPARED FOR  
 BETHLEHEM MINES CORPORATION  
 NICHOLAS DIVISION  
 CHARLESTON, WEST VIRGINIA  
**D'APPOLONIA**