


MINE NO. 31

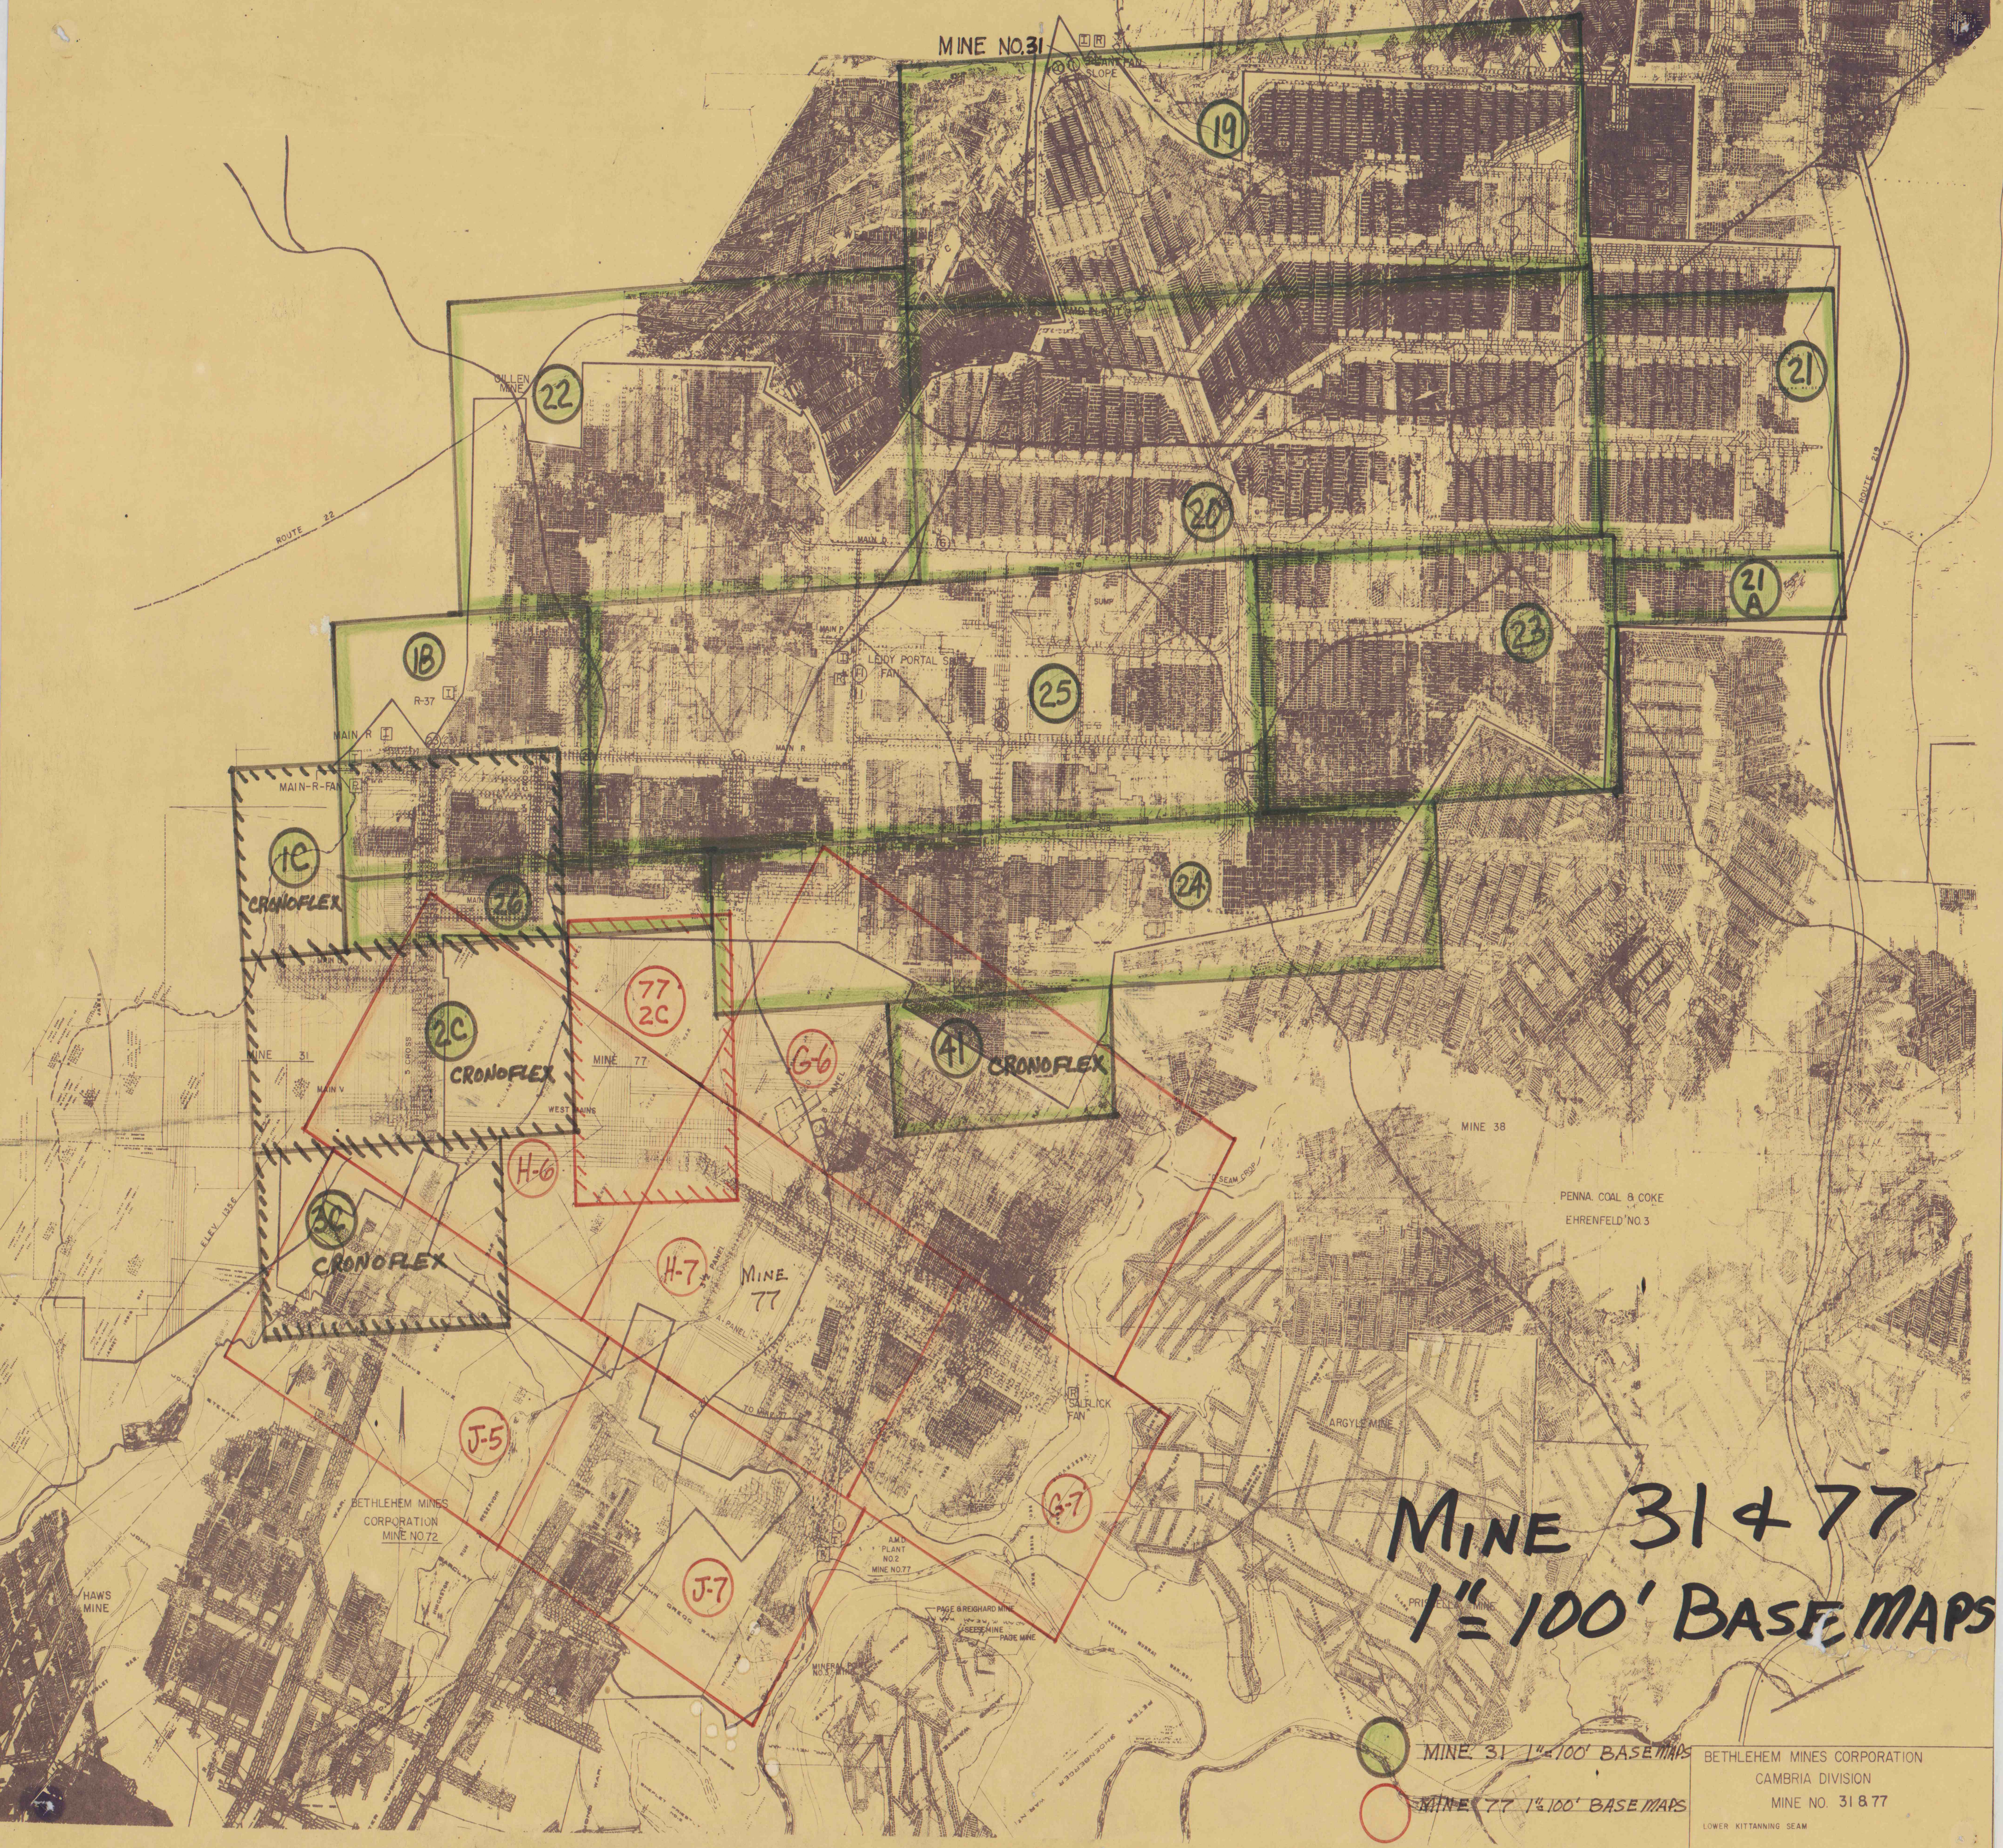

MINE 31 & 77  
1" = 100' BASE MAPS

MINE 31 1/4" 100' BASE MAPS  
MINE 77 1/4" 100' BASE MAPS

BETHLEHEM MINES CORPORATION  
CAMBRIA DIVISION  
MINE NO. 31 & 77  
LOWER KITTINGAN SEAM  
SCALE: 1" = 2000'  
DATE: 2-8-80 MINE 77 FINAL SURVEY  
4-30-80 MINE 31