





REQUIRED LIST								
NO.	NAME	MC.	NO. PCS.	DESCRIPTION	LGTH.	PC. MC.	REMARKS	WT.



PLAN OF PIPELINE
1" = 500'

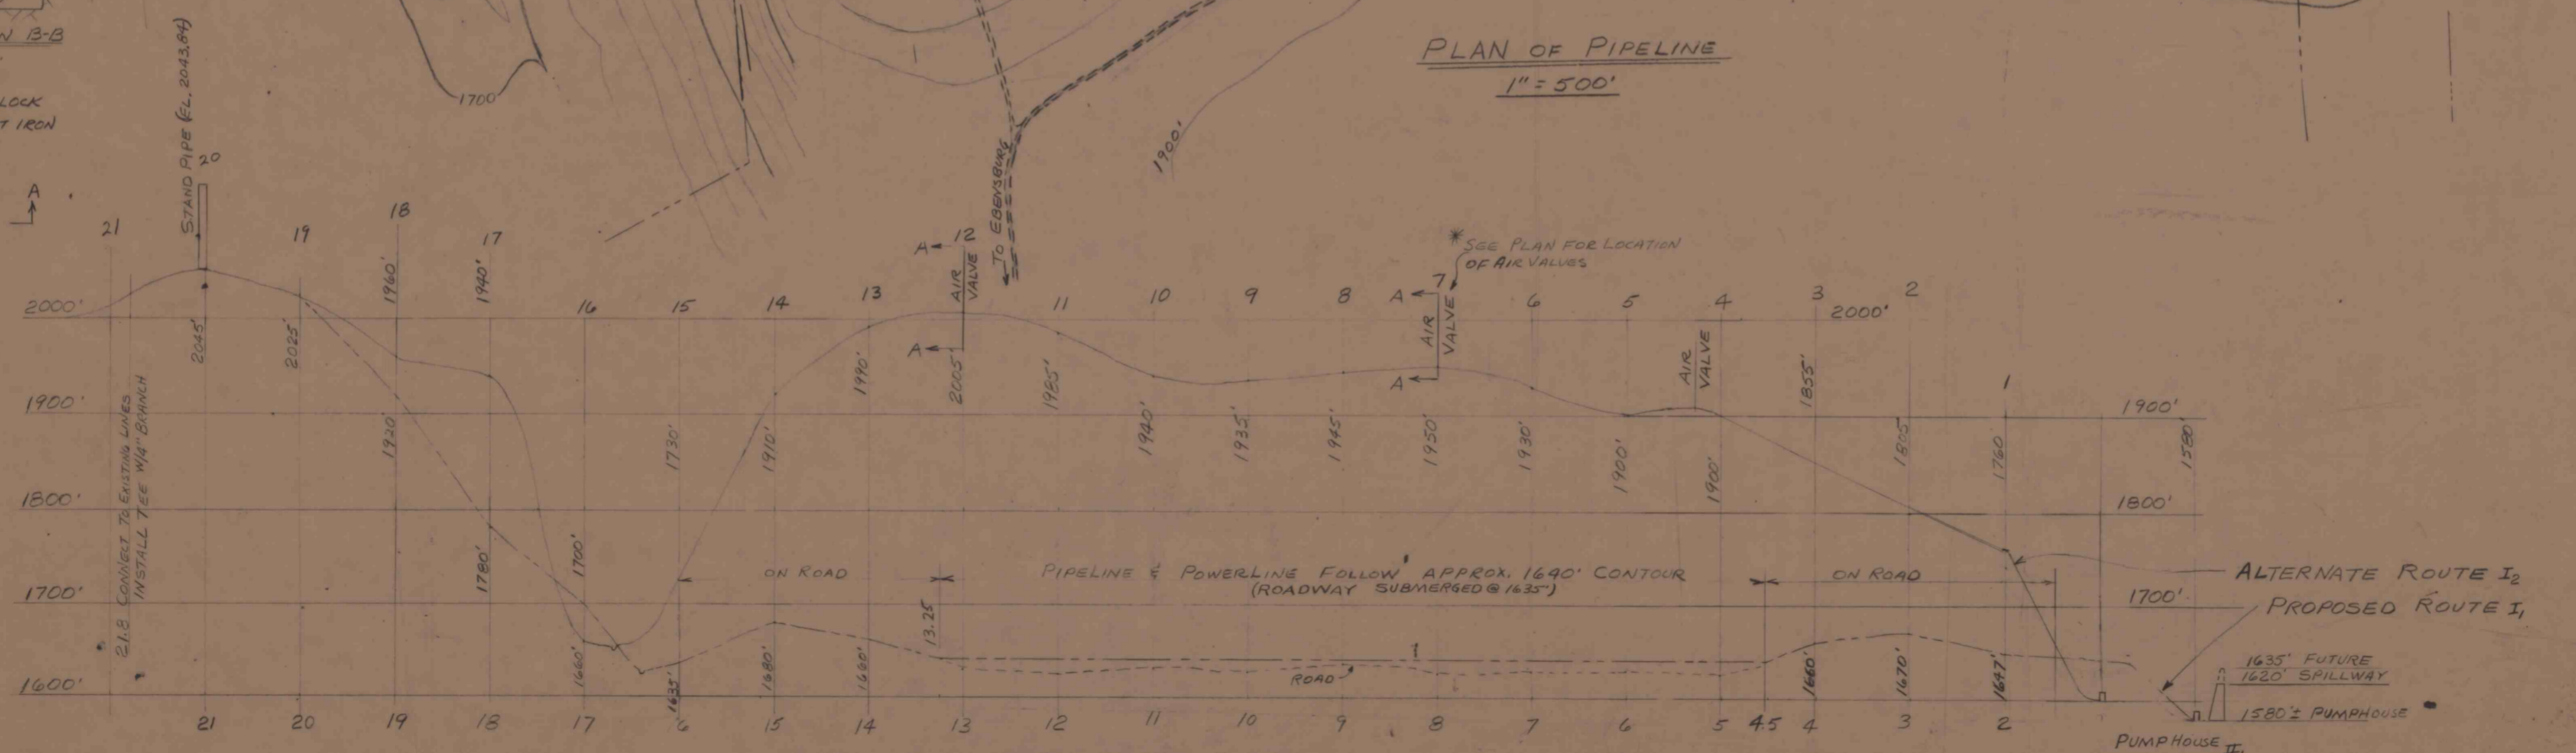

PROFILE OF PIPELINE
VERTICAL: 1" = 100'
SCALE: HORIZONTAL: 1" = 1000'

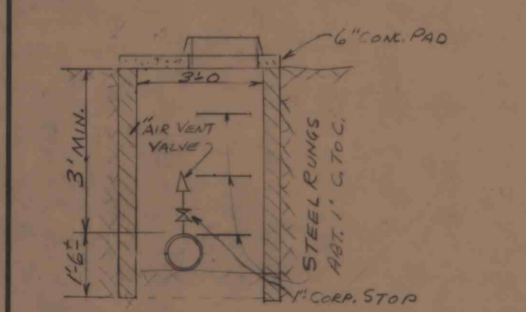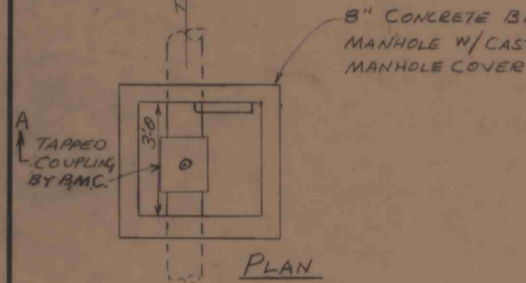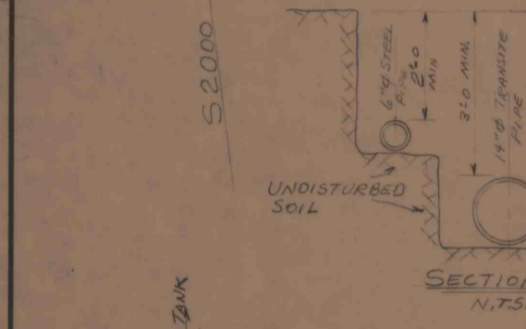

ALL MATERIAL EXCEPT TAPPED COUPLING TO BE FURNISHED BY CONTRACTOR

DWG. NO.	REFERENCE	NO.	DATE	BY

REVISIONS	
II	8/28 FJS
III	8/14 FJS
II	8/9 FJS
I	4/27 FJS

PIPELINE	
CAMBRIA SLOPE WATER SUPPLY	
DIVISION CAMBRIA	MINE NO. 32 - SLOPE
BETHLEHEM MINES CORPORATION	
ENGINEERING DEPARTMENT - JOHNSTOWN, PA.	
DRAWN F.J.S.	DATE 6-62
CHECKED	DATE
APPROVED	DATE
ORDER NO.	SCALE AS NOTED
DWG. NO. 32M2-262	

NOT INSTALLED WHERE SHOWN
 REVISION II - ADDED 6" GAS LINE
 REVISION III - ADDED SUCTION LINE
 REVISION II₂ - RELOCATED PUMPHOUSE
 REVISION I₁ - ADDED "PROPOSED ROUTE"
 I₂ - CHANGED ORIGINAL ROUTE TO "ALTERNATE ROUTE"