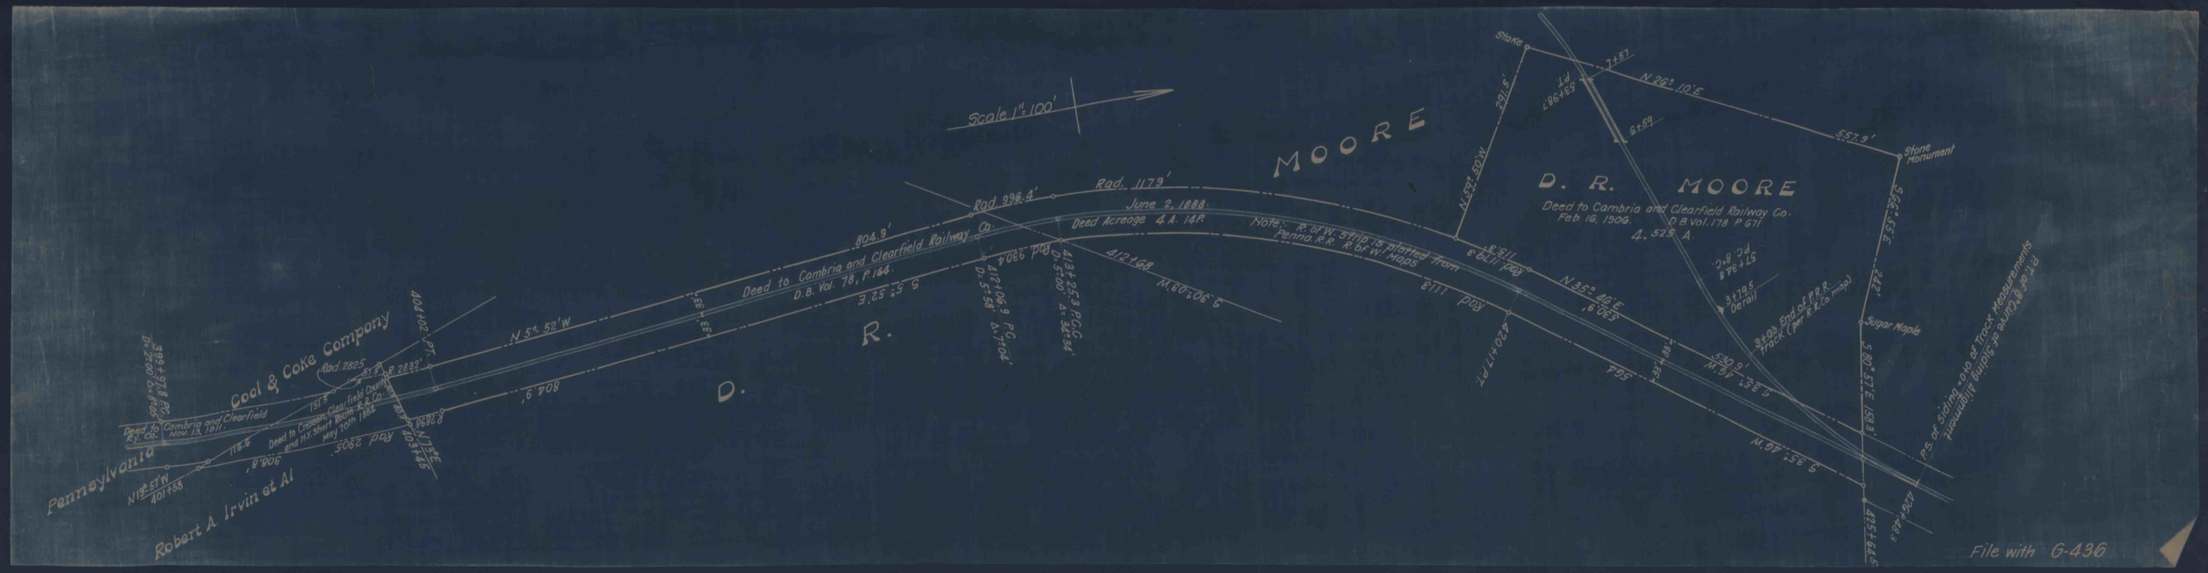
Scale 1" = 100'
MOORE
D. R. MOORE
Deed to Cambria and Clearfield Railway Co.
Stake
Stone Monument
Sugar Maple
N. 26° 10' E.
557.9'
N. 52° 30' W.
281.5'
N. 36° 40' E.
530.9'
M. 97° 35.5'
S. 53° 39.5'
372'
S. 80° 51' E. 198.3'
S. 45° 44.5'
N. 43° 47'
P.S. of Siding as per Track Measurements
Plat of Curve & Siding Alignment
Rad. 1179'
Rad. 996.4'
Rad. 2825'
804.9'
Deed to Cambria and Clearfield Railway Co.
D.B. Vol. 78, P. 164.
June 2, 1888.
Deed Acreage 4 A. 14 P.
Note: R. of W. Strip is Plotted from Penna. R.R. R. of W. Maps
Deed to Cambria Clearfield Coal & Coke Co. and N.Y. Short Route R.R. Co. May 20th 1888
Pennsylvania Coal & Coke Company
Robert A. Irvin et Al
N. 5° 52' W
S. 25° 15' E
D. R.
