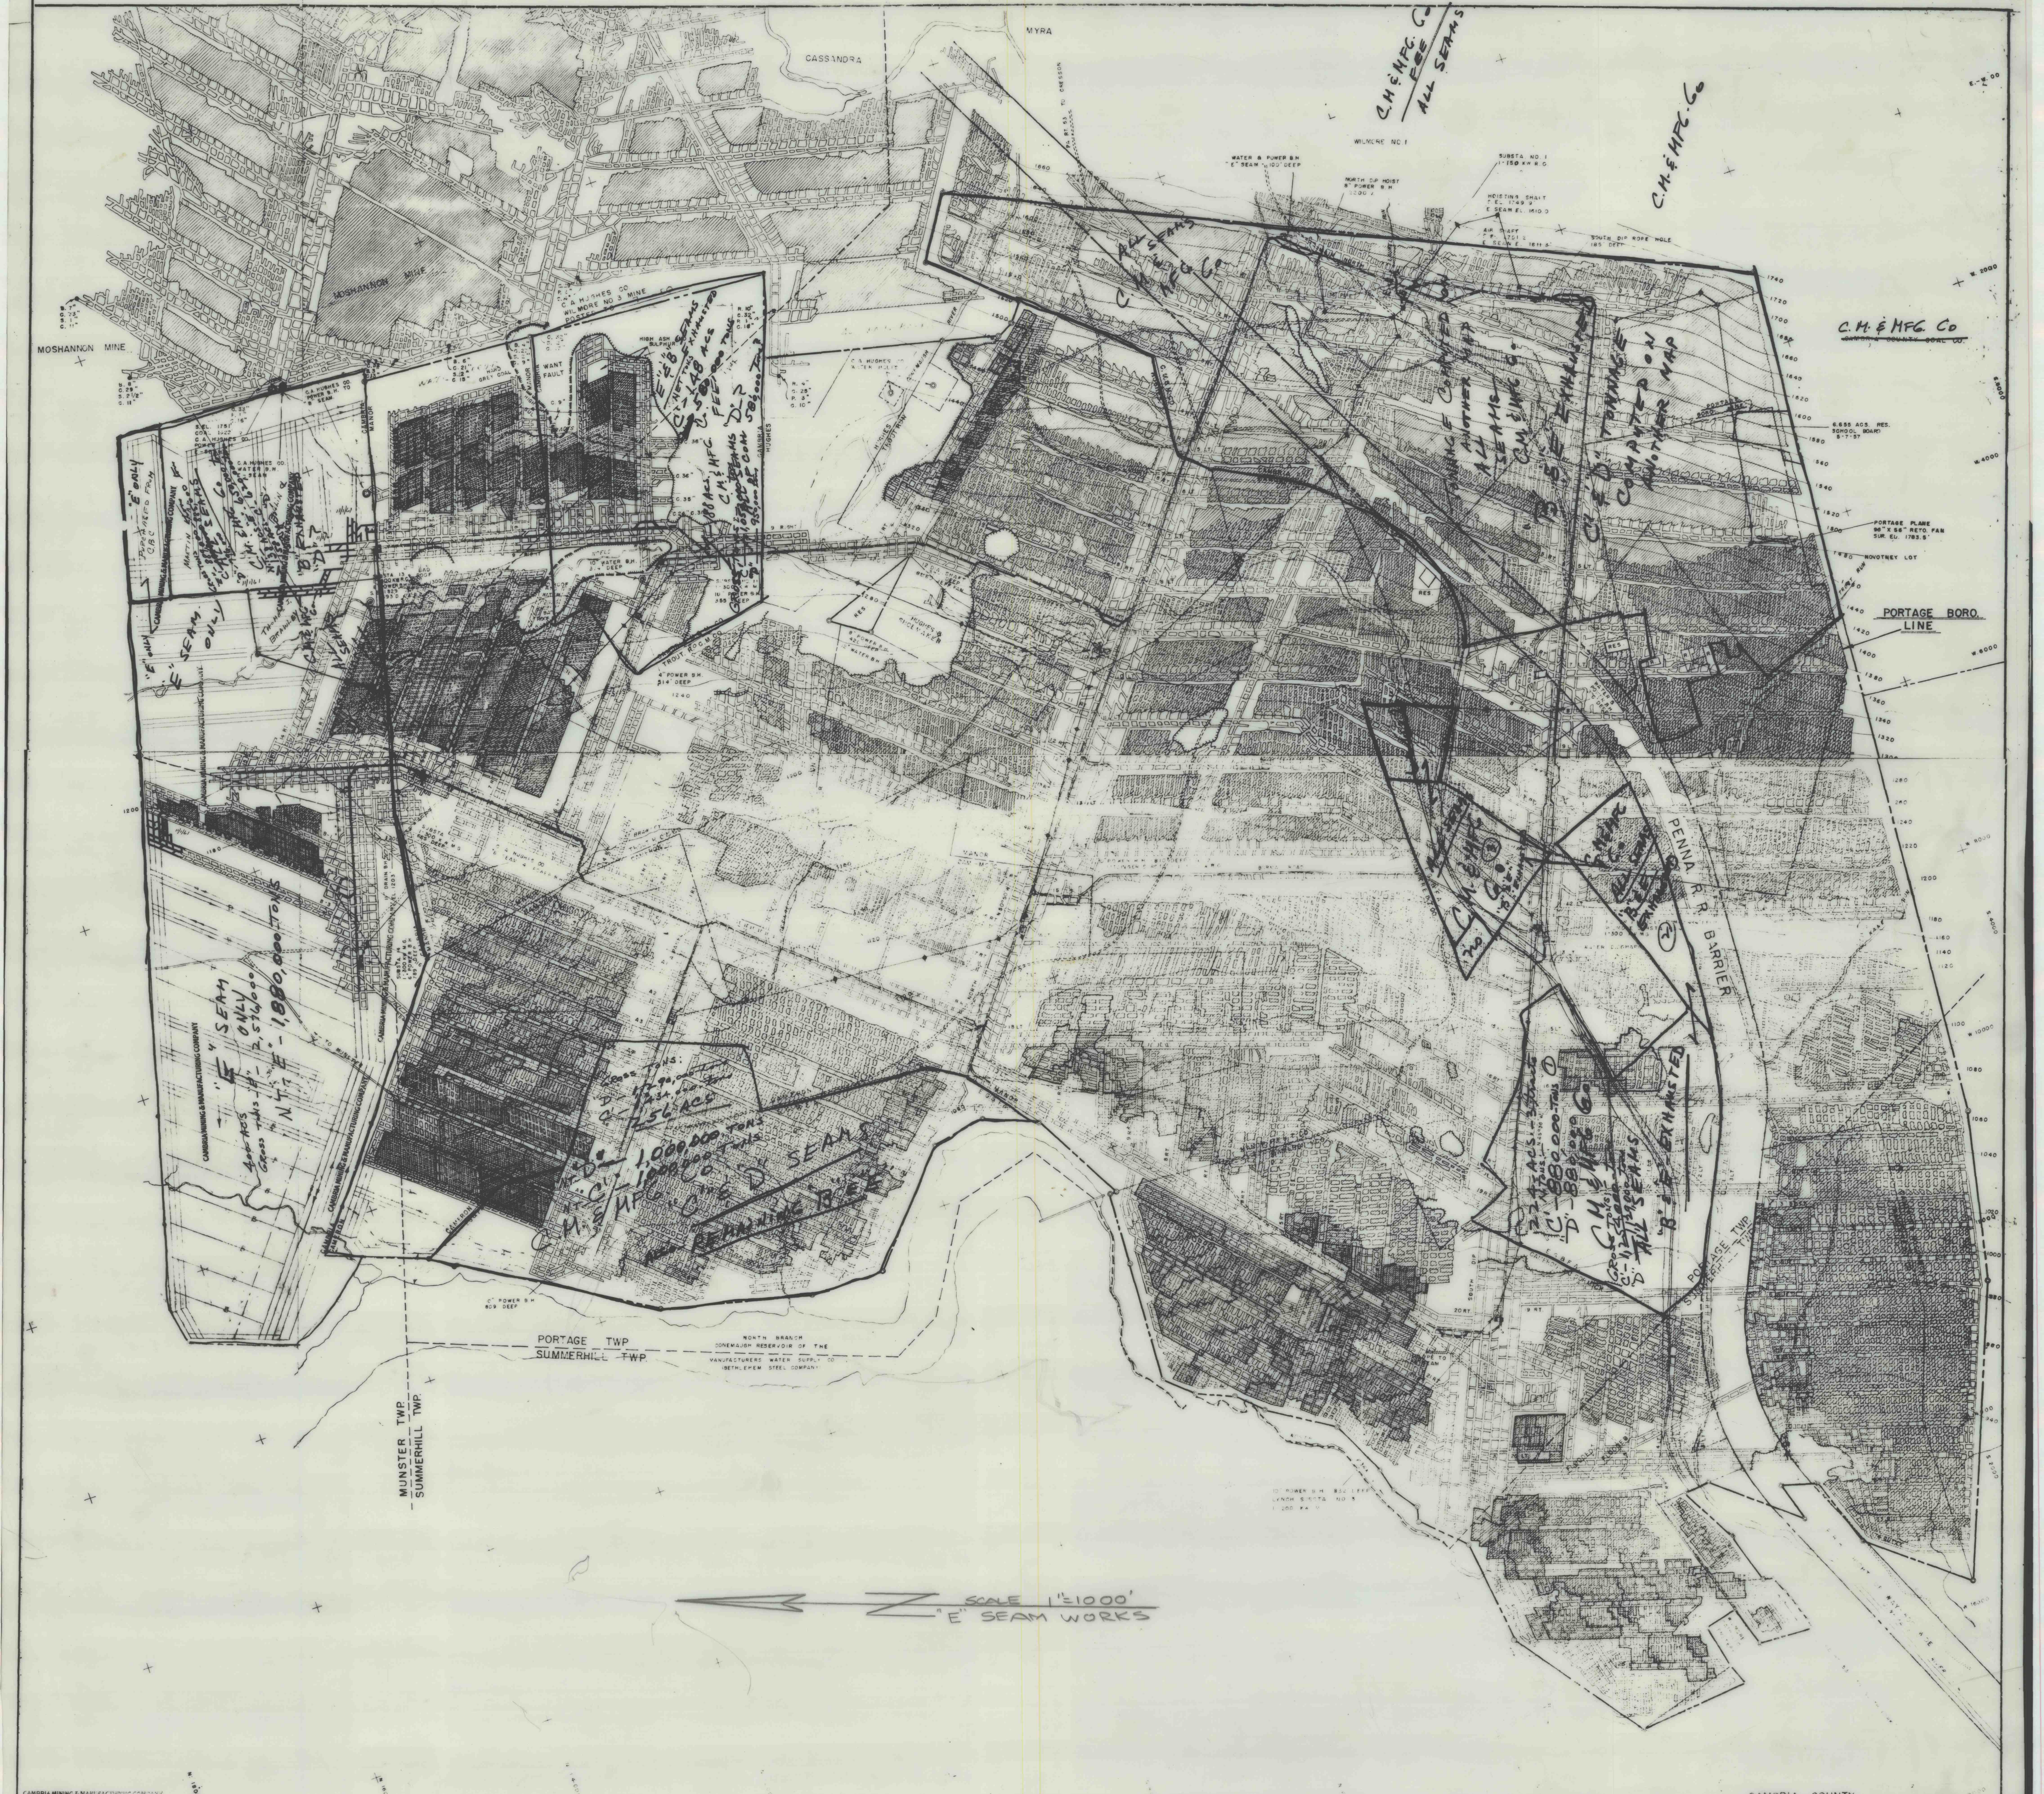

CAMBRIA MINING & MANUFACTURING COMPANY

SONMAN SLOPE MINE CAMBRIA MINING & MANUFACTURING COMPANY PROJECTION IN "E" UPPER FREEPORT SEAM	SCALE	B M NO		
L-5-262 SHEET NO 3 OF 3 SHEETS	REFERENCES			

POSTED TO 11-1-61 W.A.S.

0 500 1000 1500 2000 2500

EASTERN GAS AND FUEL ASSOCIATES
COAL DIVISION

L-5-262