


Now:- CAMBRIA MINING & MANUFACTURING COMPANY
UPPER FREEPORT SEAM MINES
PORTAGE, SUMMERHILL, ADAMS, CROYLE
SCALE 1"=1000'

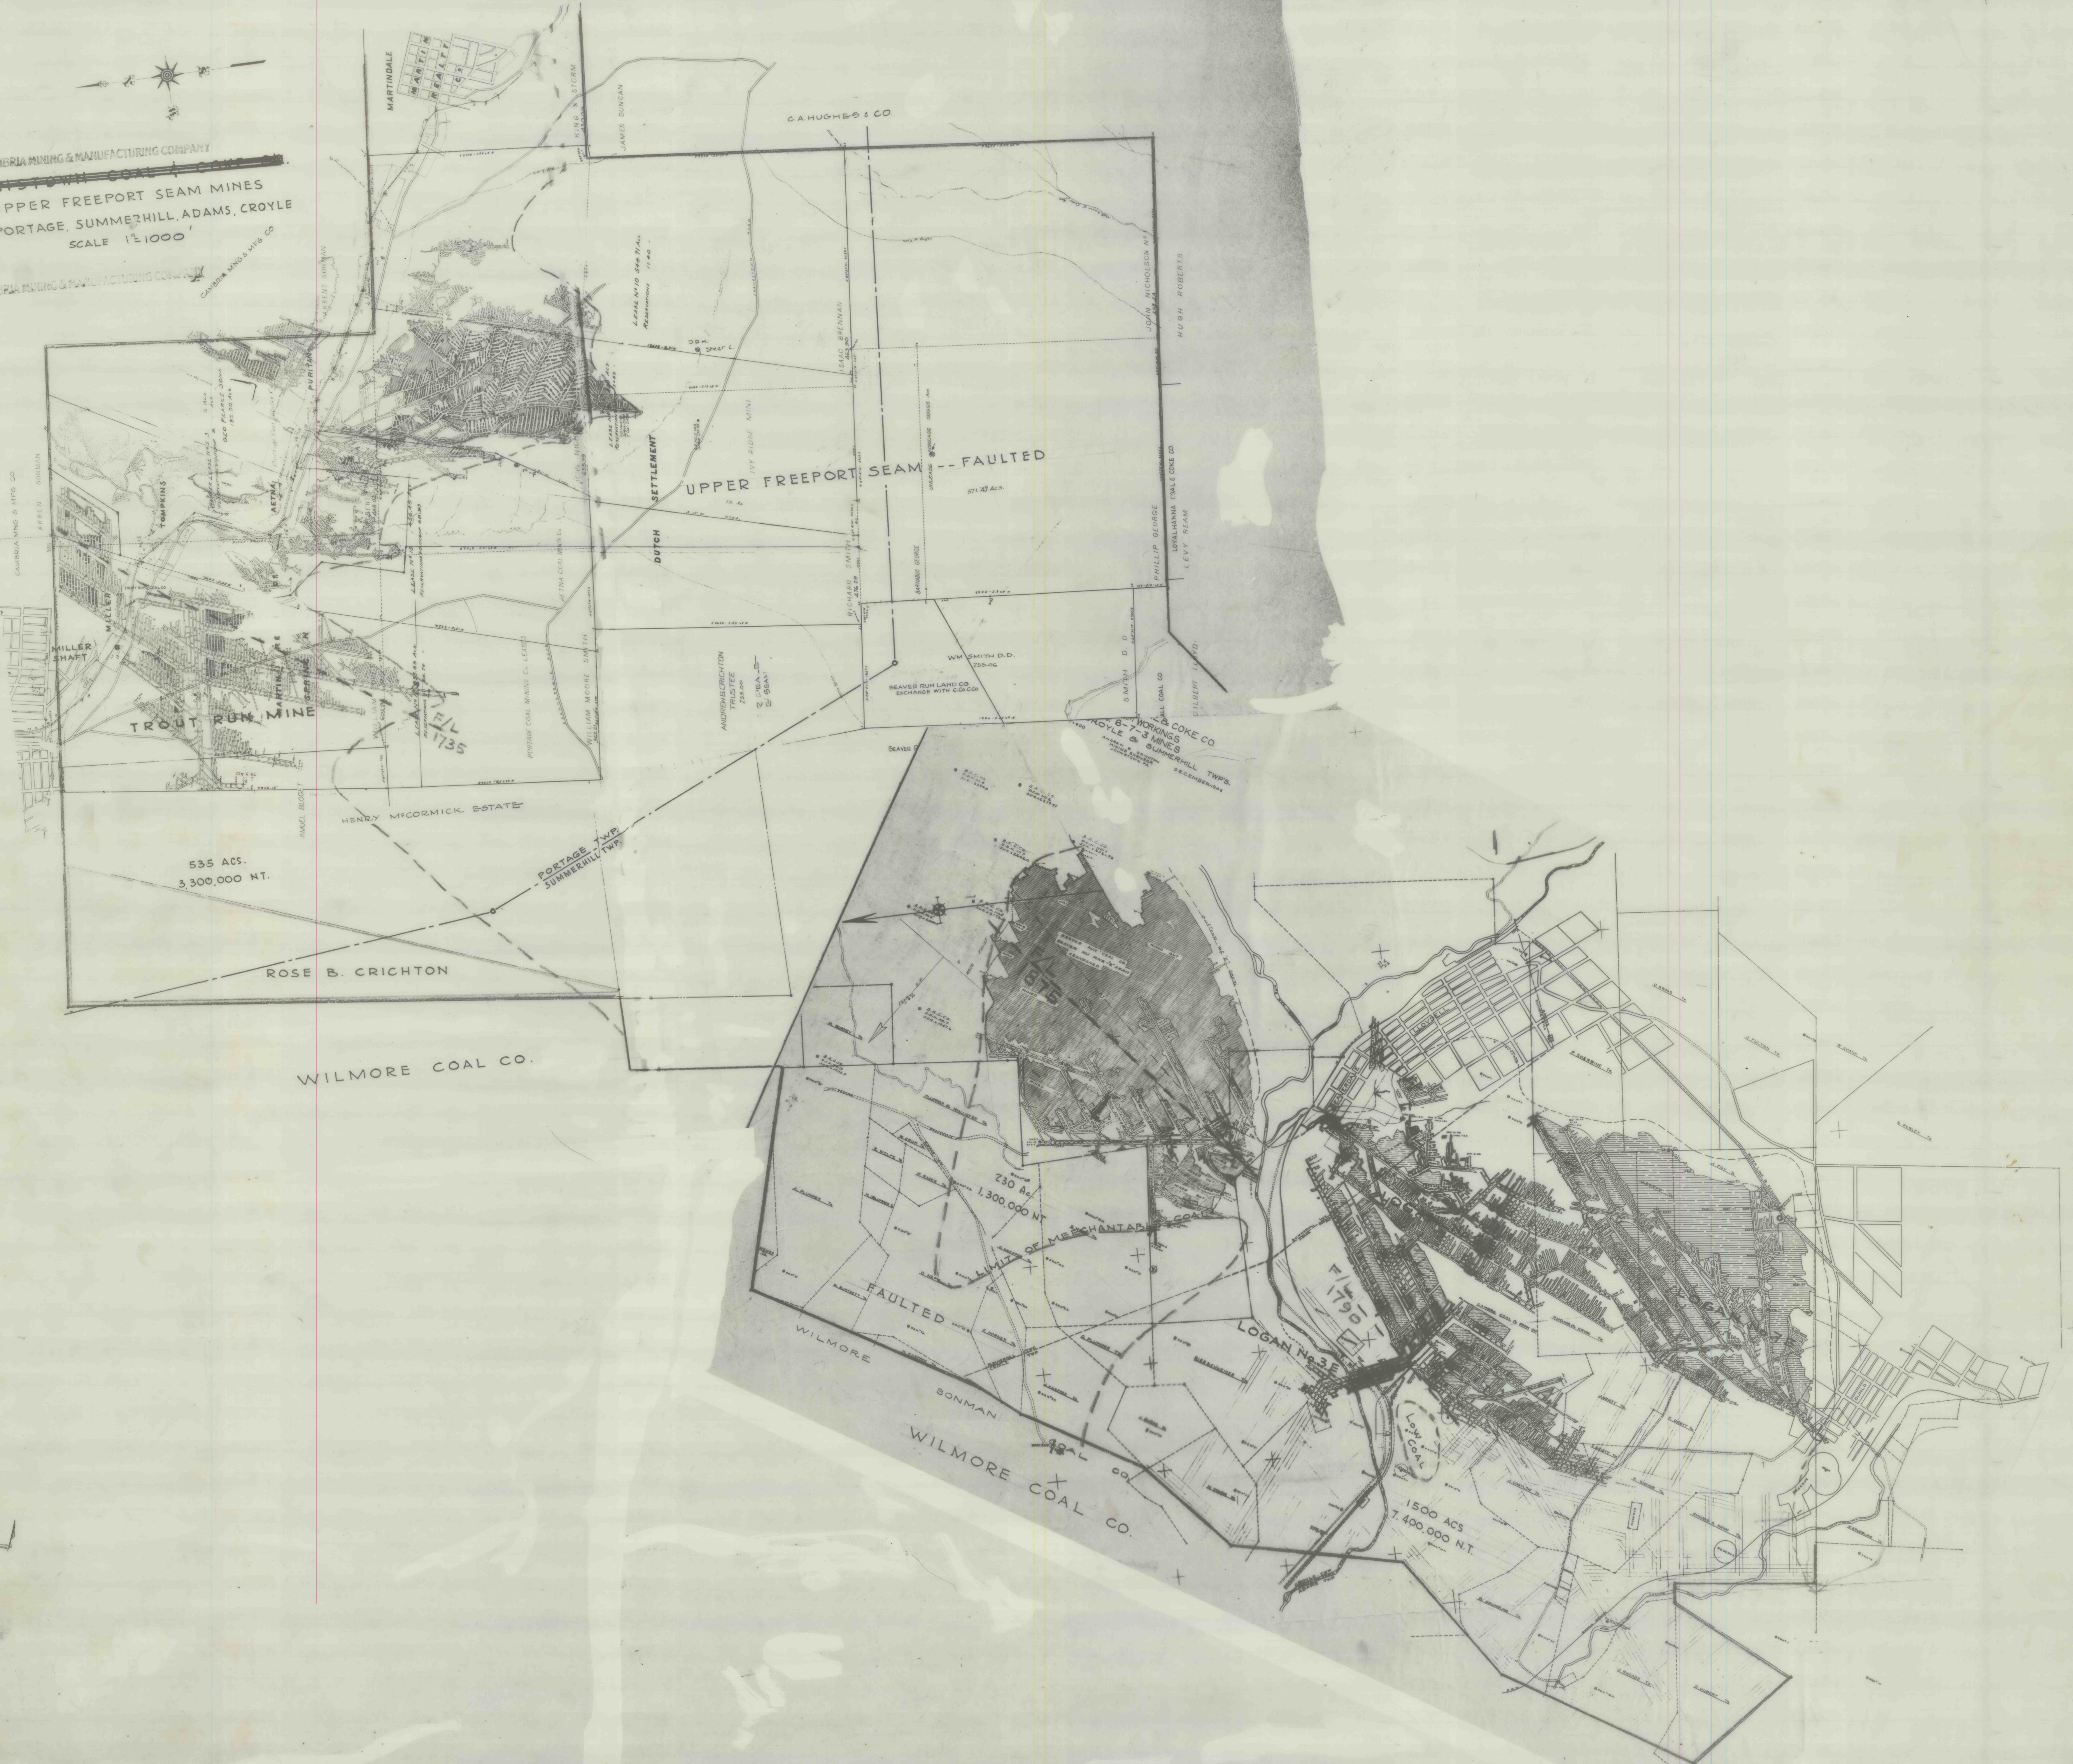

535 ACS.
3,300,000 NT.

ROSE B. CRICHTON

WILMORE COAL CO.

UPPER FREEPORT SEAM -- FAULTED

WILMORE COAL CO.

1500 ACS
7,400,000 N.T.