


C.A. HUGHES & CO.  
HUGHES NO. 2 & LILLY NO. 3 MINES  
THE  
B in LOWER KITTANNING SEAM  
WITH ADJACENT MINES AND PROPERTIES  
SCALE 1" = 100'

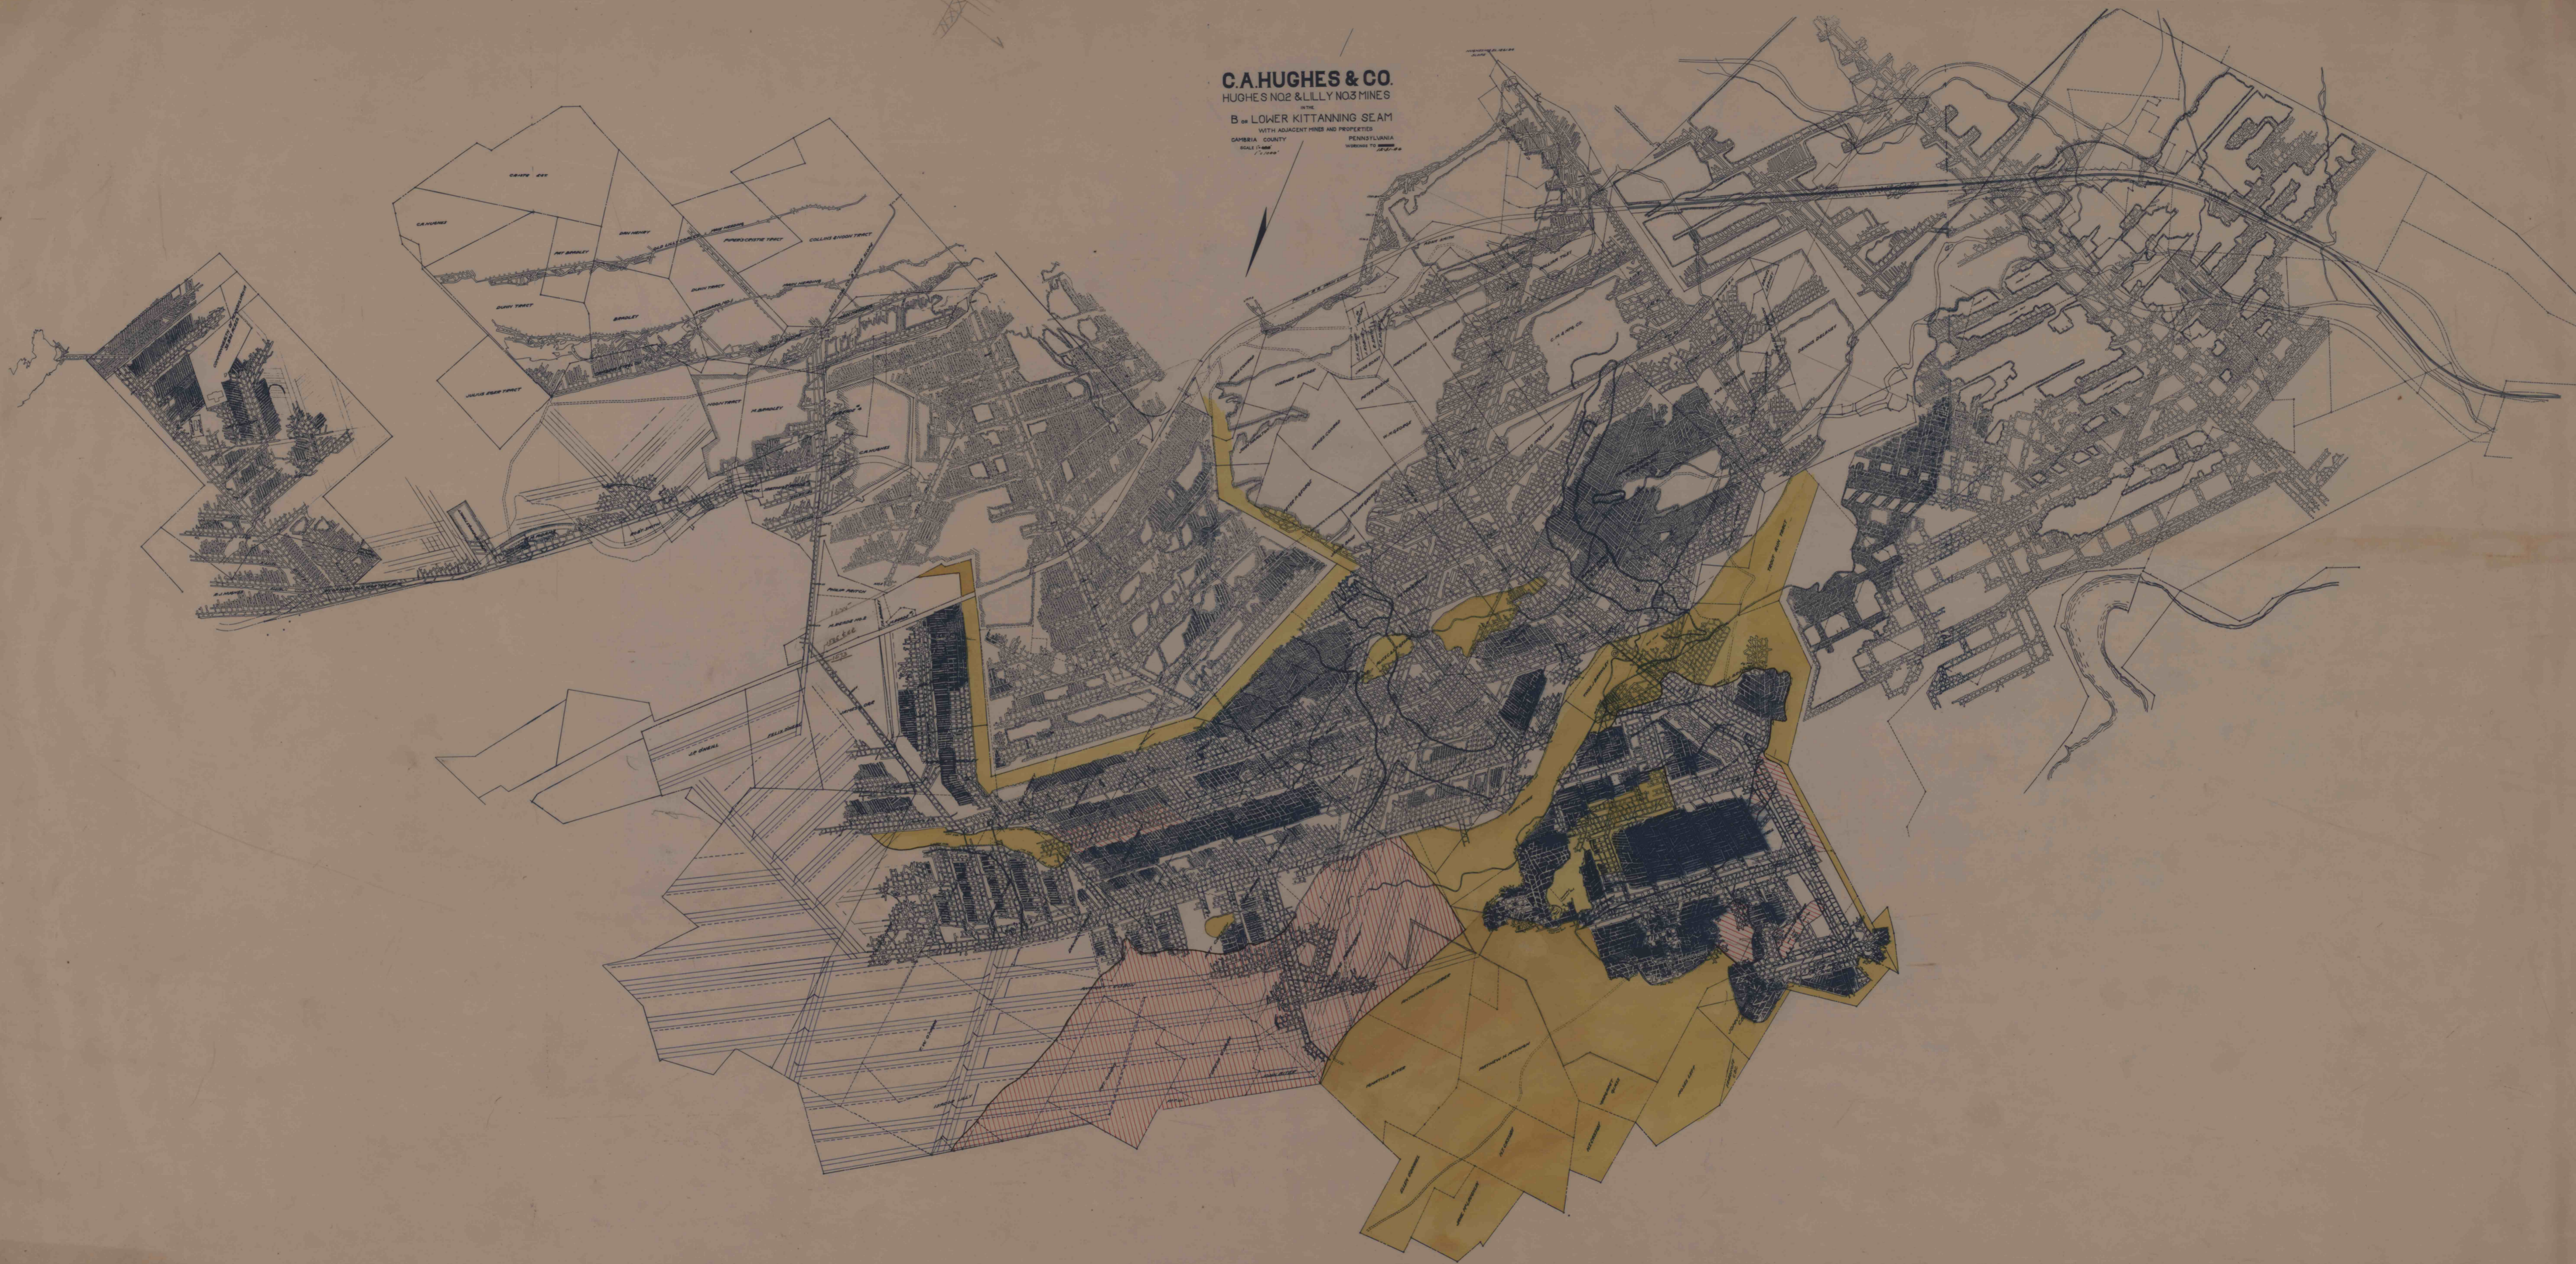

D129