


**C.A. HUGHES & CO.**  
 HUGHES NO. 2 & LILLY NO. 3 MINES  
 IN THE  
 B OF LOWER KITTANNING SEAM  
 WITH ADJACENT MINES AND PROPERTIES  
 CAMBRIA COUNTY PENNSYLVANIA  
 SCALE: 1"=400'

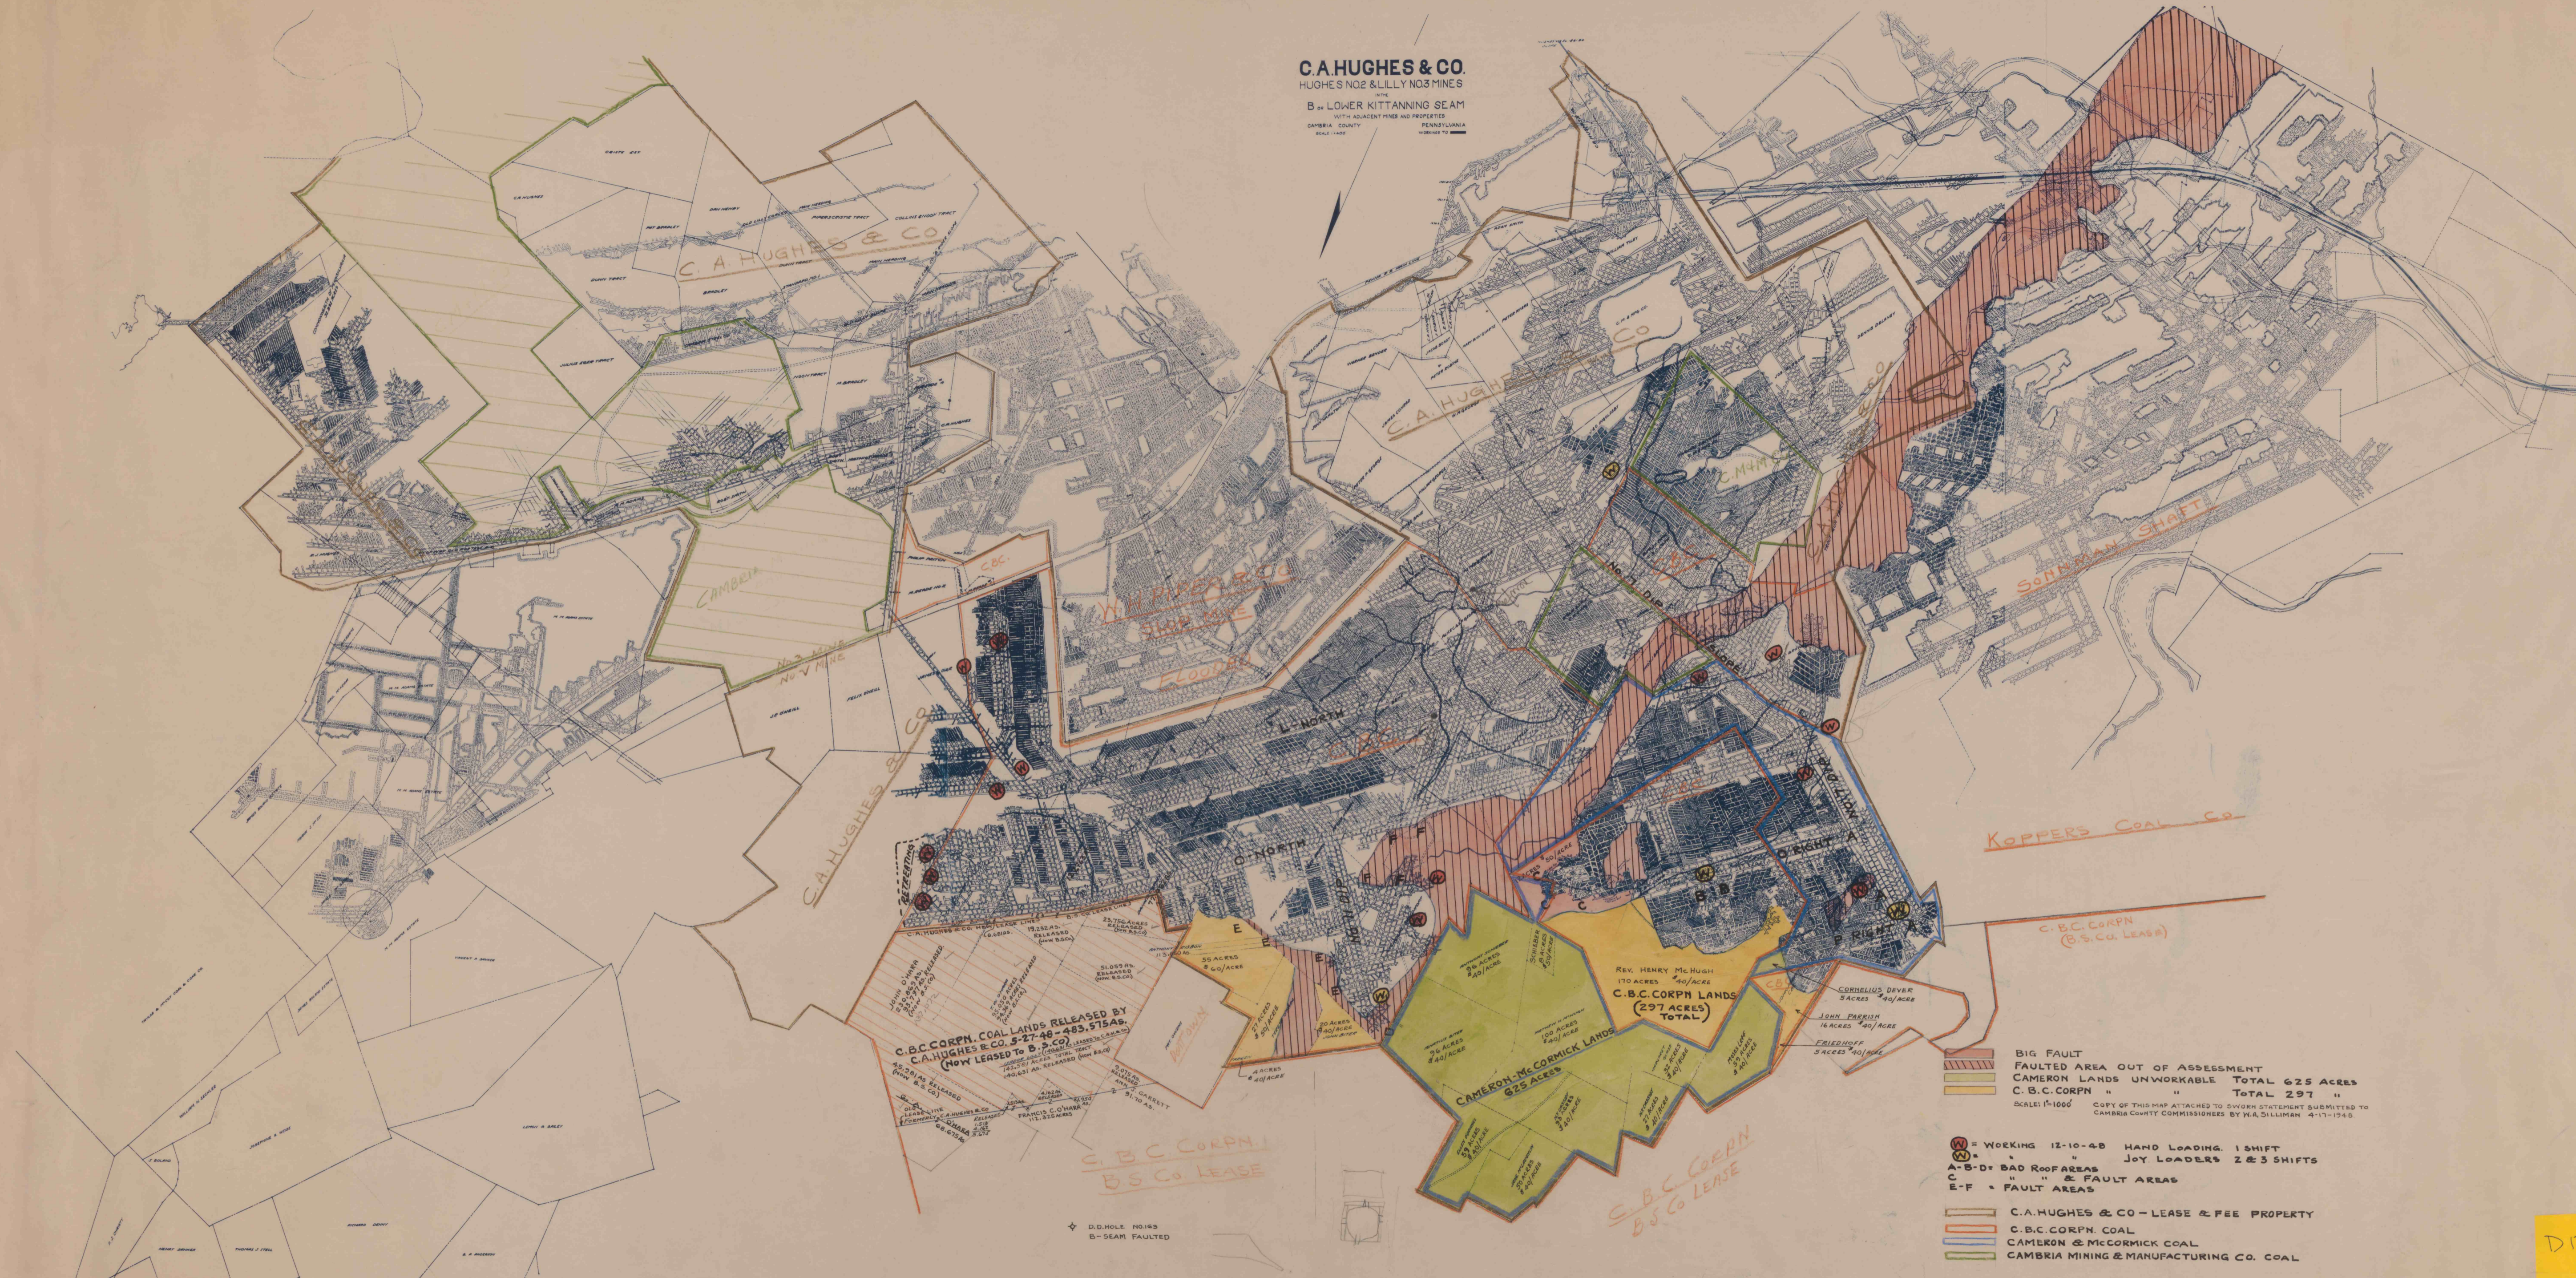

C.B.C. CORPN. COAL LANDS RELEASED BY C.A. HUGHES & CO. 5-27-48 - 483,575 AC. (NOW LEASED TO B.S. CO.)

REV. HENRY Mc HUGH 170 ACRES @ 40/ACRE C.B.C. CORPN LANDS (297 ACRES) TOTAL

CAMERON Mc CORMICK LANDS 625 ACRES

C.B.C. CORPN. B.S. CO. LEASE

C.B.C. CORPN. B.S. CO. LEASE

[Symbol] BIG FAULT  
 [Symbol] FAULTED AREA OUT OF ASSESSMENT  
 [Symbol] CAMERON LANDS UNWORKABLE TOTAL 625 ACRES  
 [Symbol] C.B.C. CORPN " " TOTAL 297 "  
 SCALE: 1"=1000' COPY OF THIS MAP ATTACHED TO SWORN STATEMENT SUBMITTED TO CAMBRIA COUNTY COMMISSIONERS BY W.R. SILLIMAN 4-17-1948

[Symbol] W = WORKING 12-10-48 HAND LOADING, 1 SHIFT  
 [Symbol] N = JOY LOADERS 2 & 3 SHIFTS  
 A-B-D = BAD ROOF AREAS  
 C = " " & FAULT AREAS  
 E-F = FAULT AREAS

[Symbol] C.A. HUGHES & CO - LEASE & FEE PROPERTY  
 [Symbol] C.B.C. CORPN. COAL  
 [Symbol] CAMERON & MCCORMICK COAL  
 [Symbol] CAMBRIA MINING & MANUFACTURING CO. COAL

D.D. HOLE NO. 195 B-SEAM FAULTED

D129