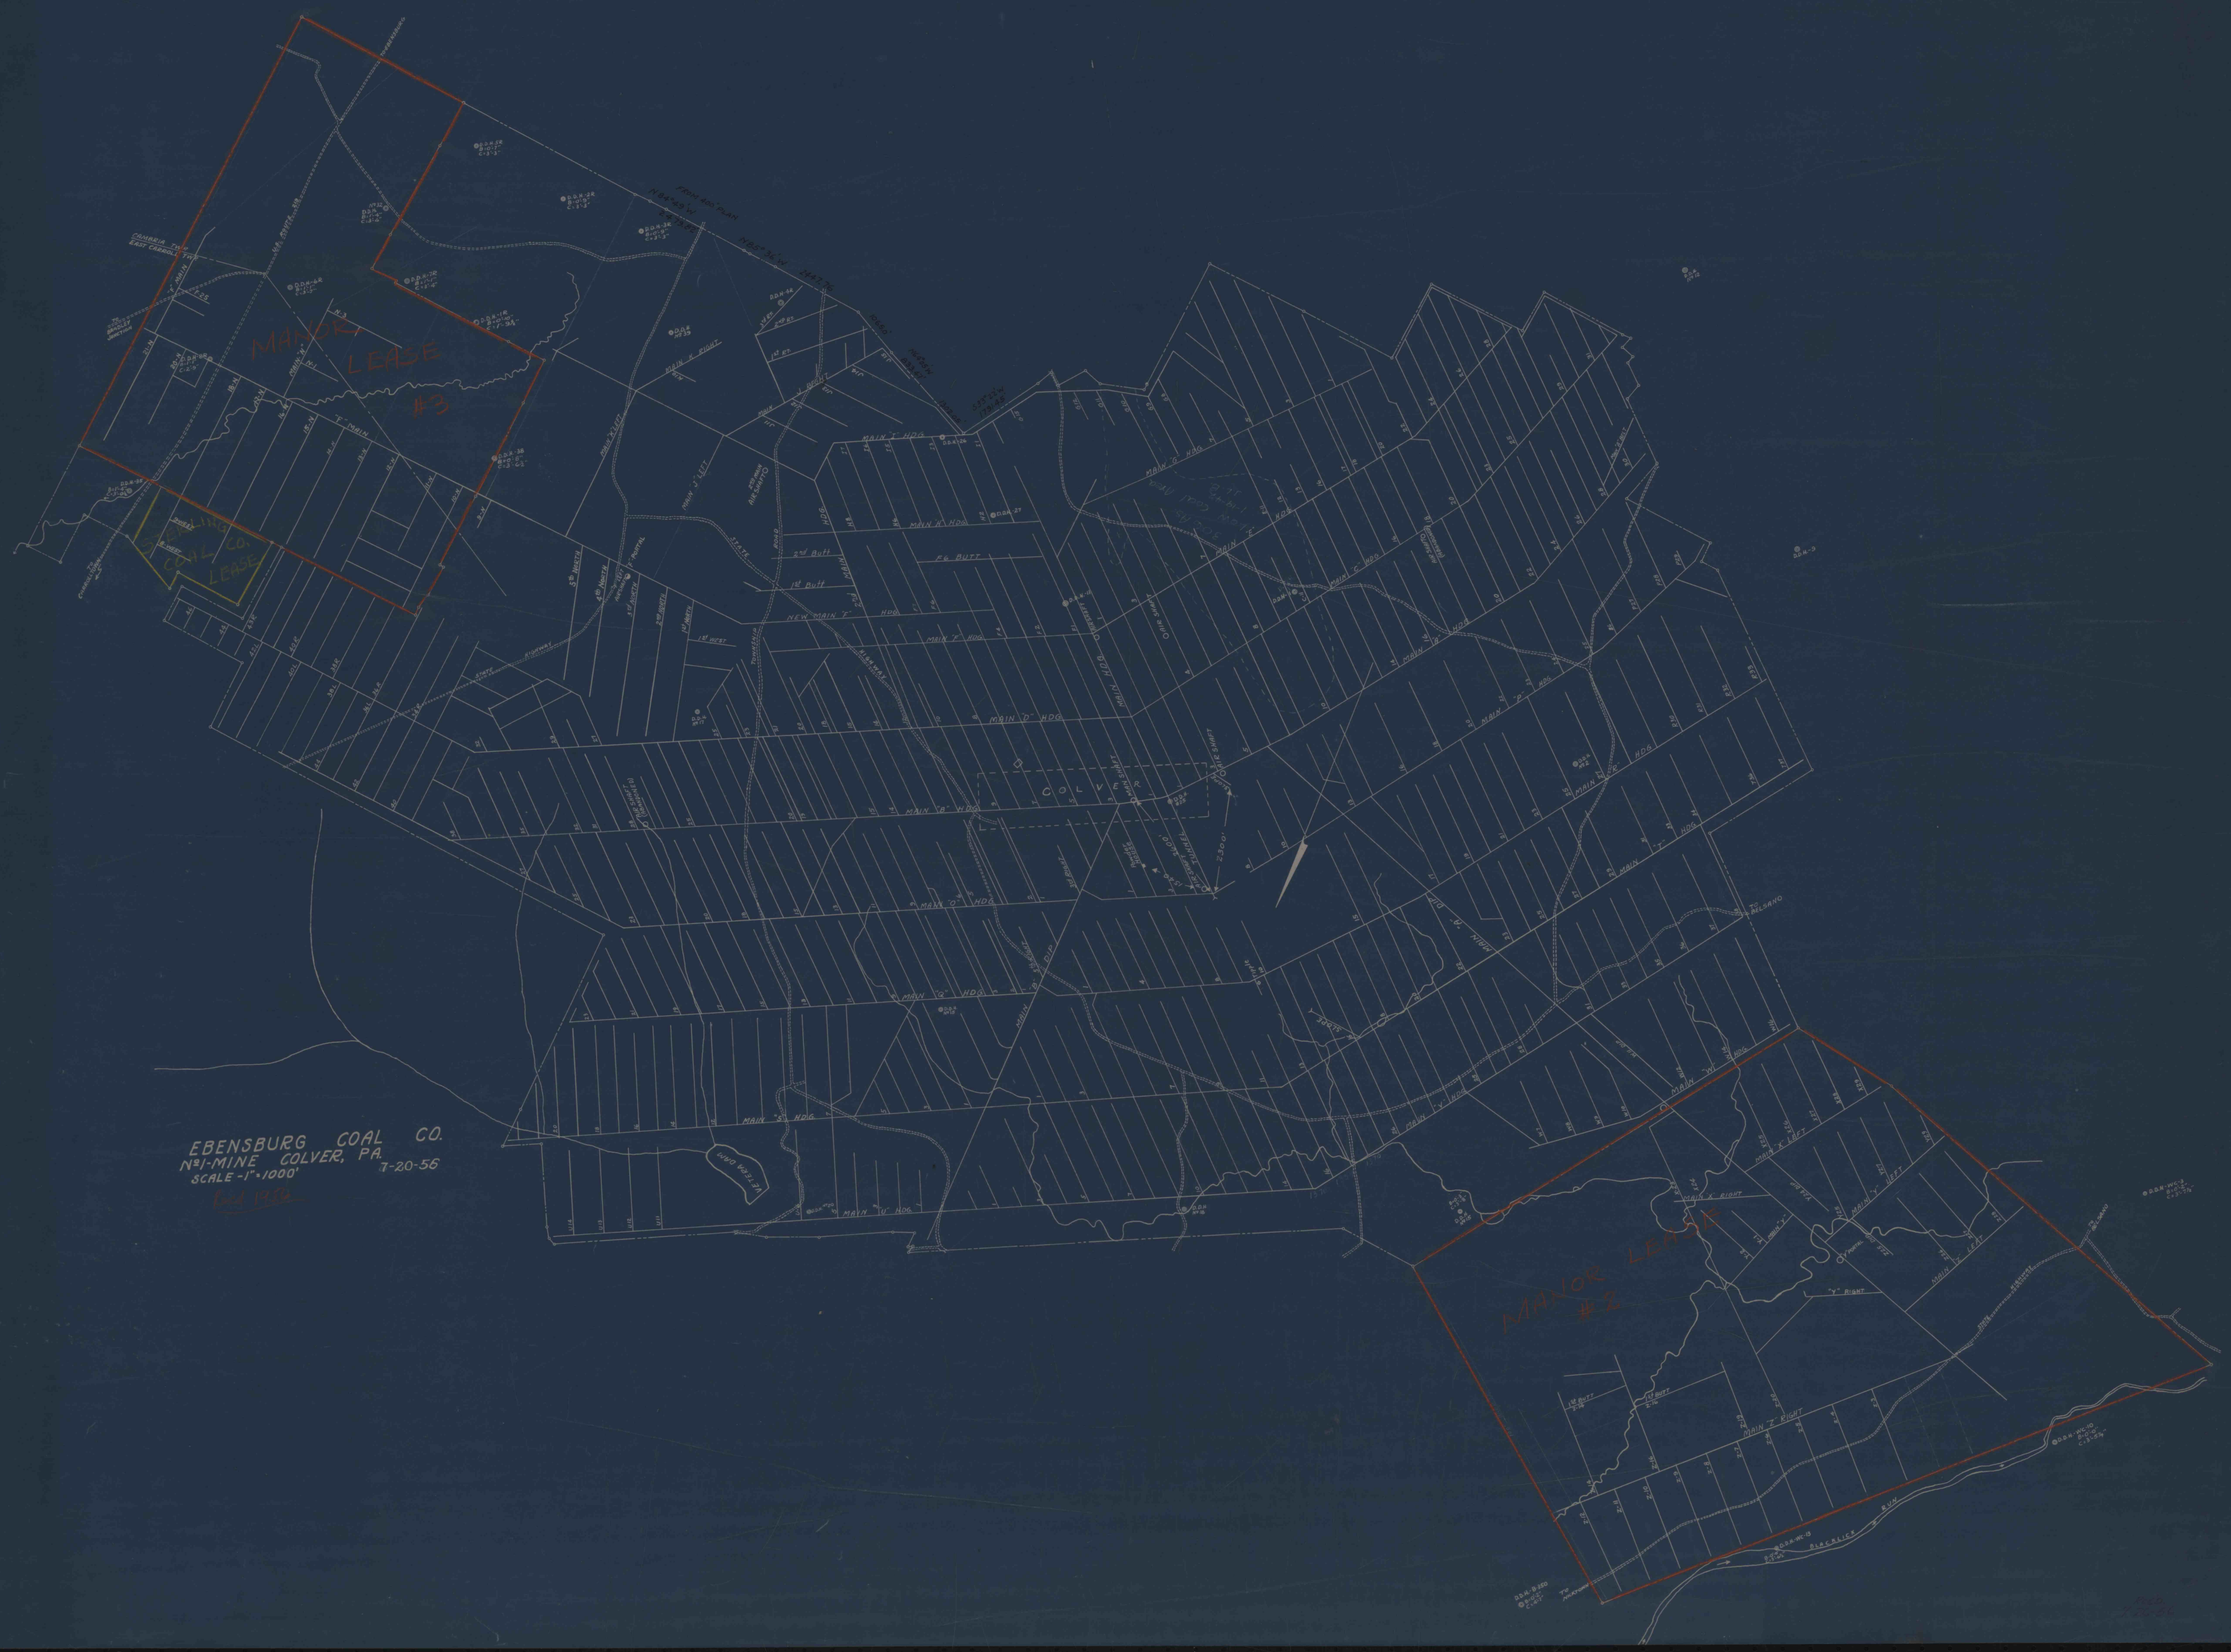
EBENSBURG No 1
1" = 1000'
MANOR LEASE #3
MANOR LEASE #2
COLVER
EBENSBURG COAL CO.
No 1-MINE COLVER, PA.
SCALE - 1" = 1000'
7-20-56
E-128