
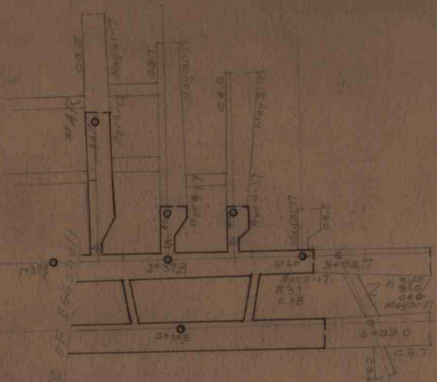


CONDUIT

E9000

+ Left of F7

E8005

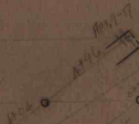

OFF 7

E5700

E8000