



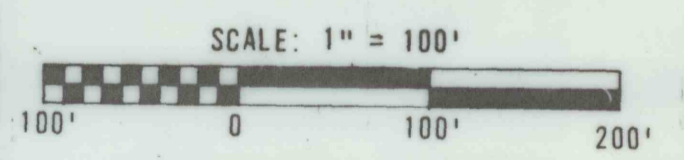

NOTES:

1. THIS DRAWING IS A PHOTOGRAPH REPRODUCTION OF BETHLEHEM MINE CORP., BARBOUR DIVISION, DRAWING NO. D68, TOPOGRAPHIC SURVEY, PREPARED BY EASTERN MAPPING CO., AND MINE MAPS SUPPLIED BY BETHLEHEM MINES CORP., MAPS NUMBERS 101-38, 101-39, 101-28, 101-29.
2. THE TOPOGRAPHY SHOWN IS MISLOCATED ABOUT 70 FEET NORTH-NORTHWEST OF ITS CORRECT PLAN LOCATION RELATIVE TO THE MINE MAP. THE APPROXIMATE PLAN LOCATION OF THE PROPOSED IMPONDMENT RELATIVE TO THE MINE MAP IS CORRECT.

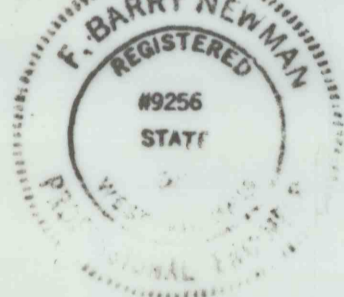

MINE MAP OF REDSTONE COAL SEAM NORTH HOLLOW REFUSE IMPONDMENT MINE 101 COAL PREPARATION PLANT CENTURY, WEST VIRGINIA

<p>CONSULTANTS, INC. Engineers • Geologists • Planners Environmental Specialists 570 Beatty Rd. • Pittsburgh Monroeville, Pa. 15146</p>		<p>BETHLEHEM MINES CORP. CHARLESTON, WEST VIRGINIA</p>	
<p>DRAWN: <u>FJC</u> REVIEWED: <u>ASB / FBN</u></p>	<p>APPROVED: <u>FBN</u> DATE: <u>7-14-83</u></p>	<p>SCALE: 1" = 100'</p>	<p>DRAWING NUMBER: 82-312-E3</p>

ADDED NOTE 2
BY G.Y. CHK'D BY FBN 11-2-83