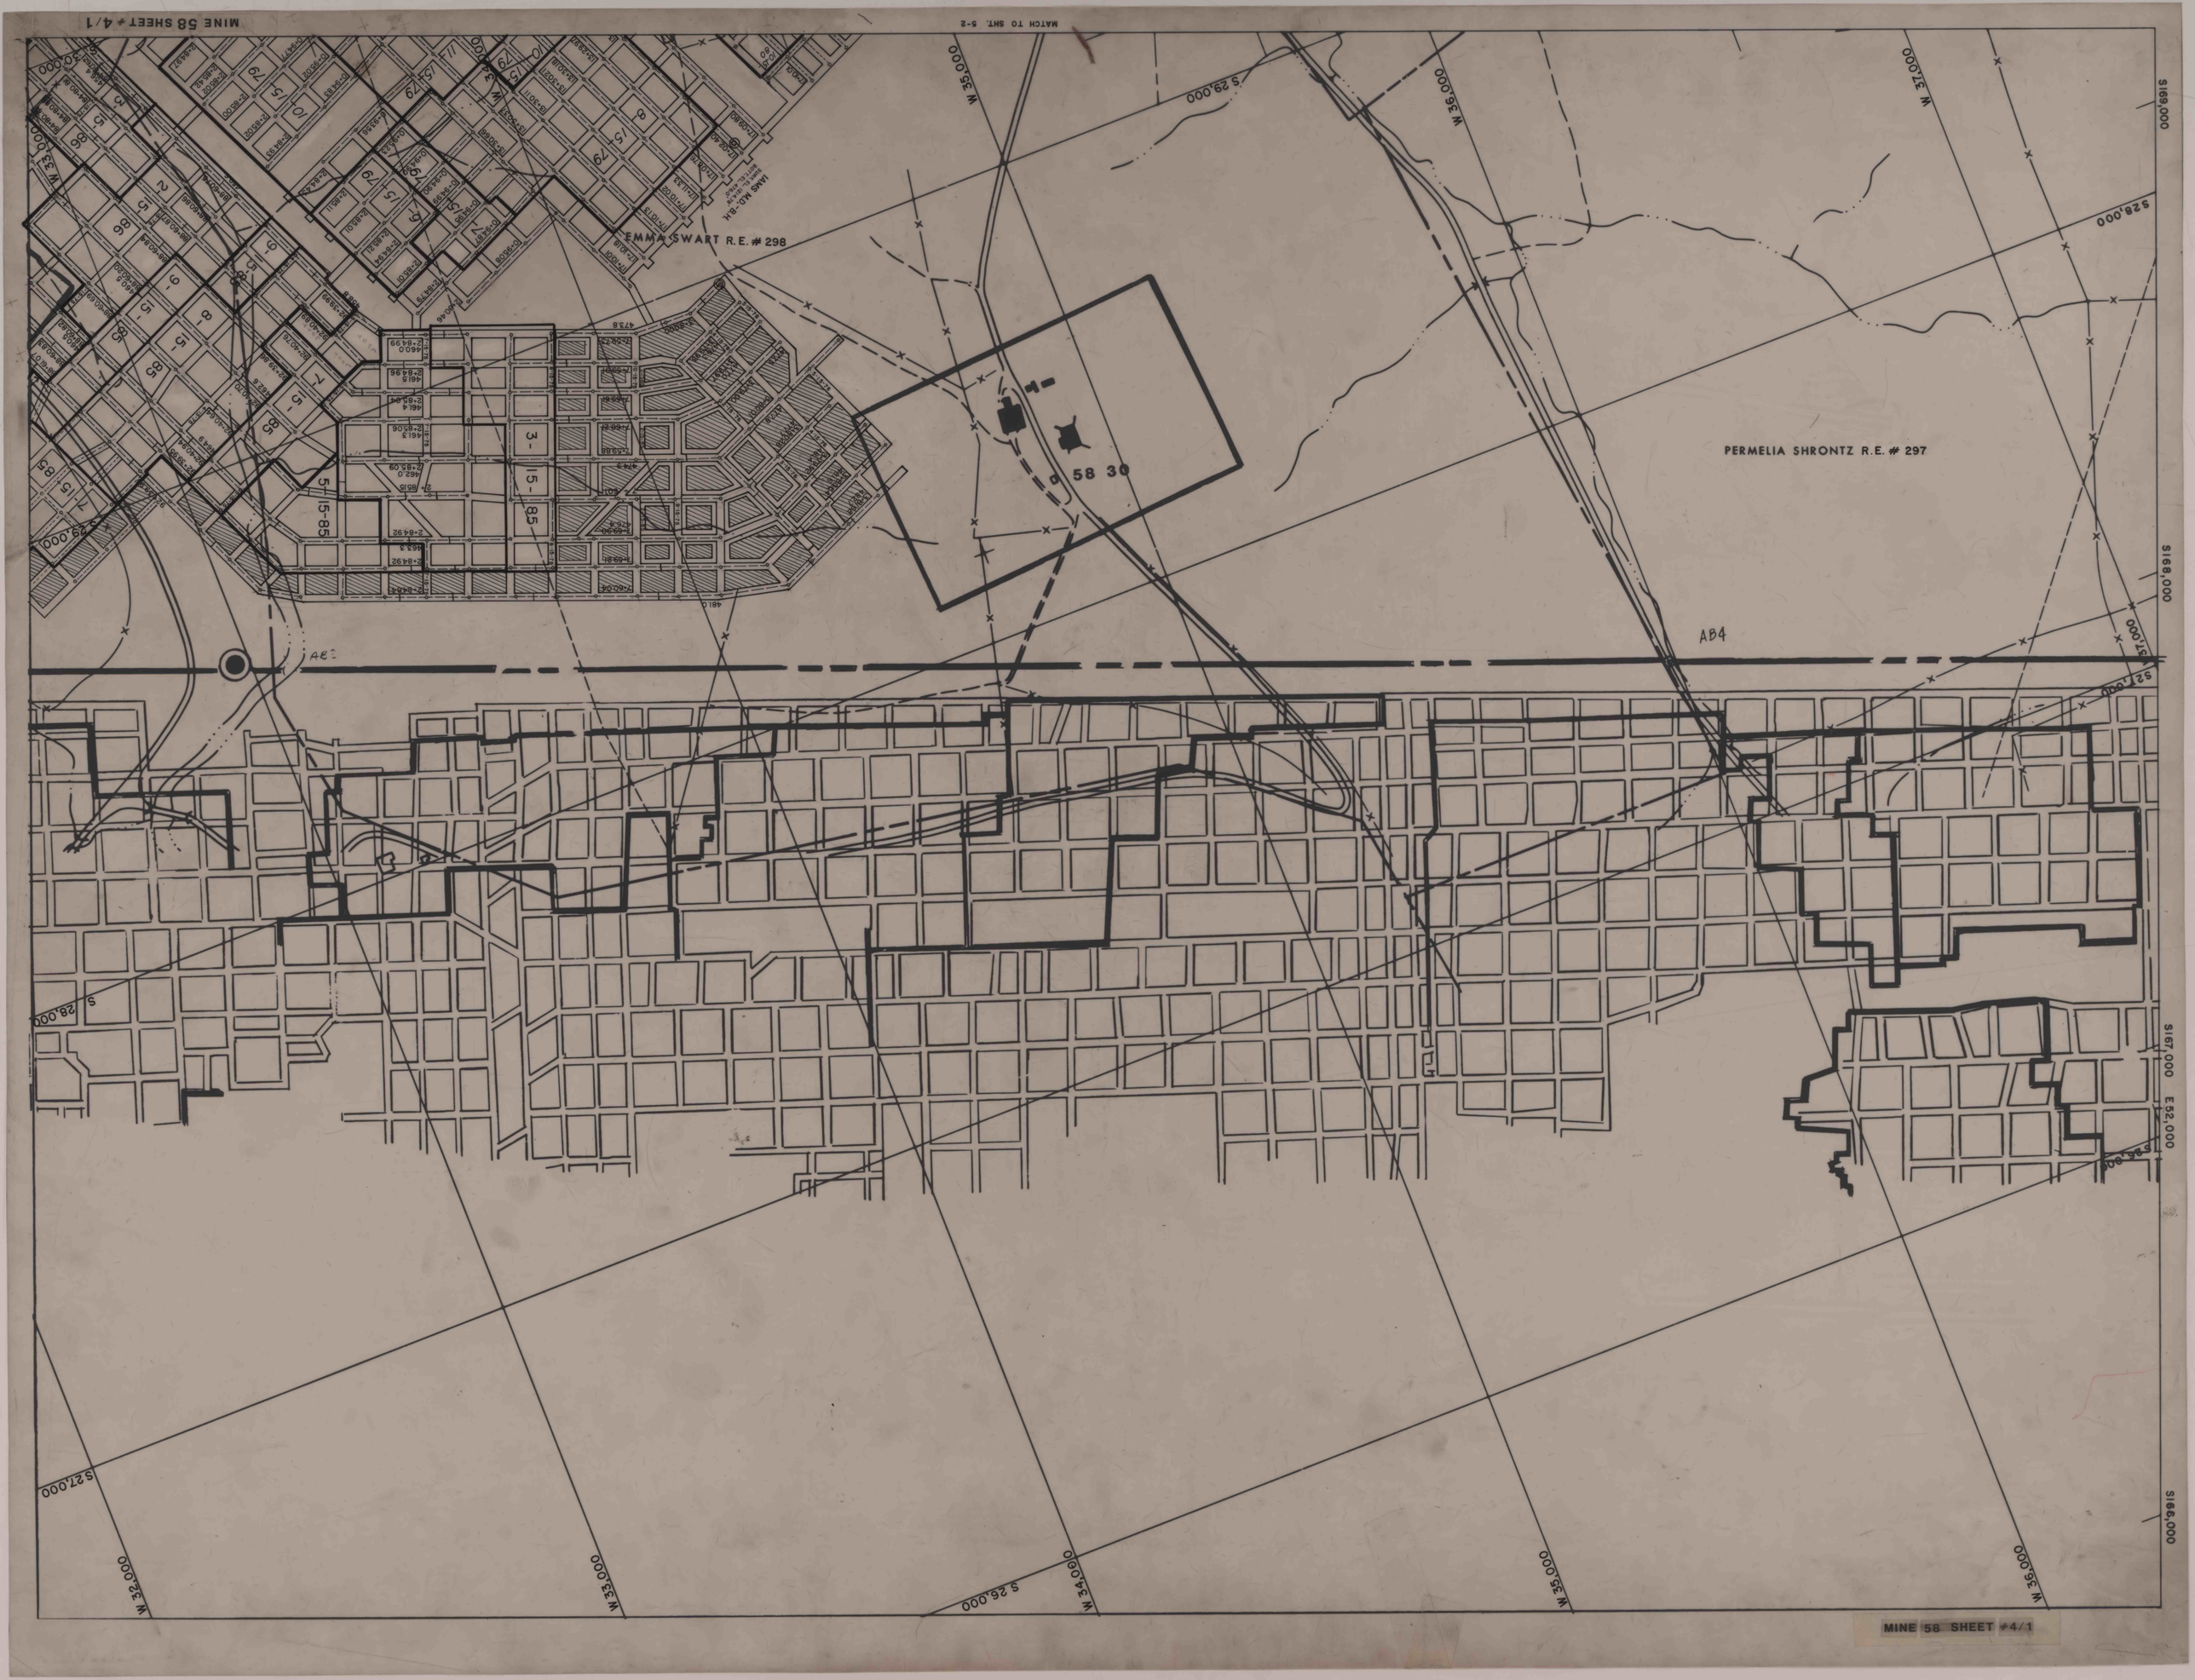
MINE 58 SHEET # 4/1
MATCH TO SHT. 5-2
EMMA SWART R.E. # 298
PERMELIA SHRONTZ R.E. # 297
58 30
AB4
W 32,000
W 33,000
W 34,000
W 35,000
W 36,000
W 37,000
S 26,000
S 27,000
S 28,000
S 29,000
S 30,000
S 169,000
S 168,000
S 167,000
S 166,000
E 52,000
MINE 58 SHEET #4/1