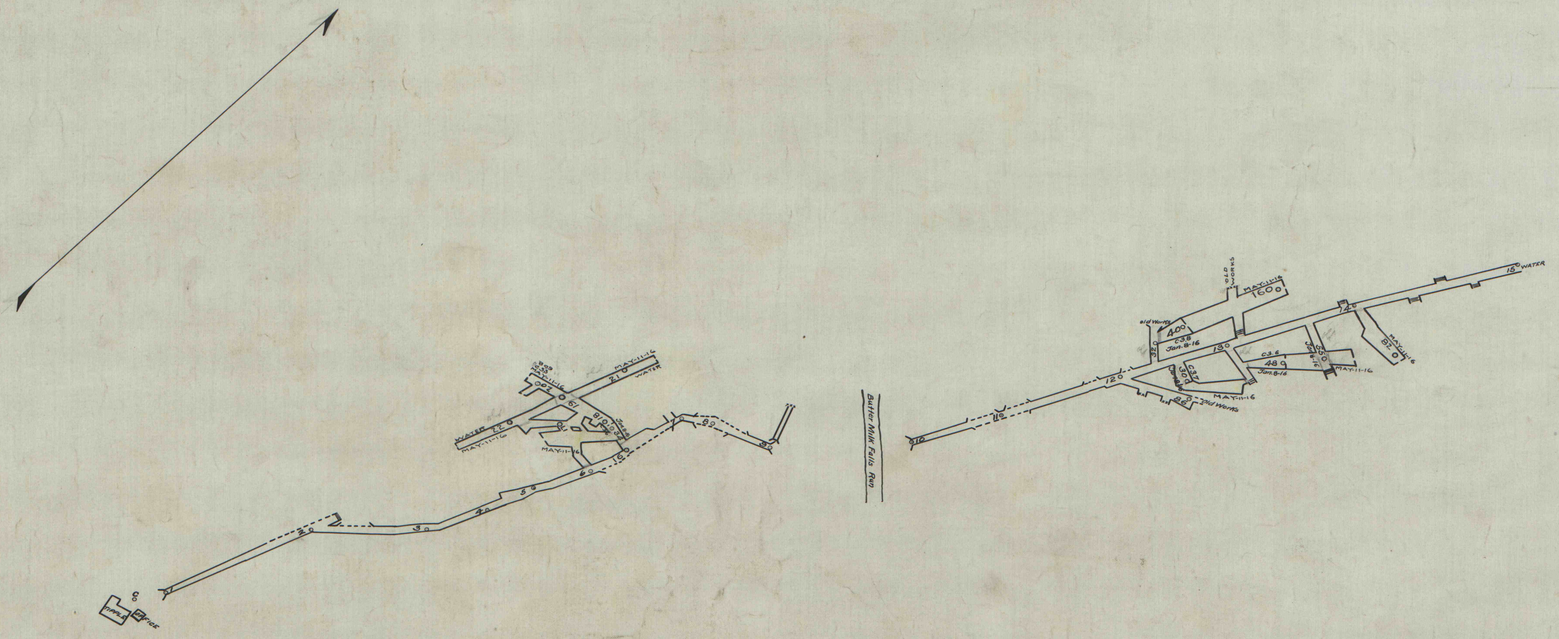
WATER
