

**JOHN CUMMINGS WARRANT.**  
314 AS. 31 PS. & ALL. DEC. 20-1784.

BLAIR IRON & COAL COMPANY.  
Sells all the Coal and 1/2 Inst. in Surf. to  
**CAMBRIA IRON COMPANY.**  
314 AS. 41 PS. DEED NO. 3625.

**CAMBRIA IRON CO**  
Sells 'B' Seam of Coal to  
**JAMES GLASS**  
9 AS. 155 PS.  
June 10-1903 - Deed No. 7369.

**BLAIR IRON & COAL CO.**  
Sells all the Coal & 1/2 Inst. in the Surface.  
DEED NO. 3625.

**MILLER COAL CO. MINE.**

**JOHN KUNKLE WARRANT.**  
463 AS. 33 PS. & ALL. APRIL 29-1794.

**ROBERT GALBRAITH WARRANT.**  
39 AS. 35 PS. & ALL. MAR. 23-1785.


**BETHLEHEM MINES CORP.**  
ENGINEERING DEPT.  
JOHNSTOWN, PA.  
**MILLER COAL CO'S MINE**  
OPERATED BY ELMER DIMOND.  
JUNIATA TWP, BLAIR CO. PA.

SCALE 100' = 1"

NOTE BOOKS HOUSE Coal Mines.  
REFERENCES  
REVISIONS

DATE	5-7-1925		
DRAWN BY	A. G. P.		
TRACED BY	A. G. P.		
CHECKED BY	A. G. P.		

INDEX: MINES.- Foreign  
BLAIR CO. PA.  
DRAWING NO.-52 A. 241.

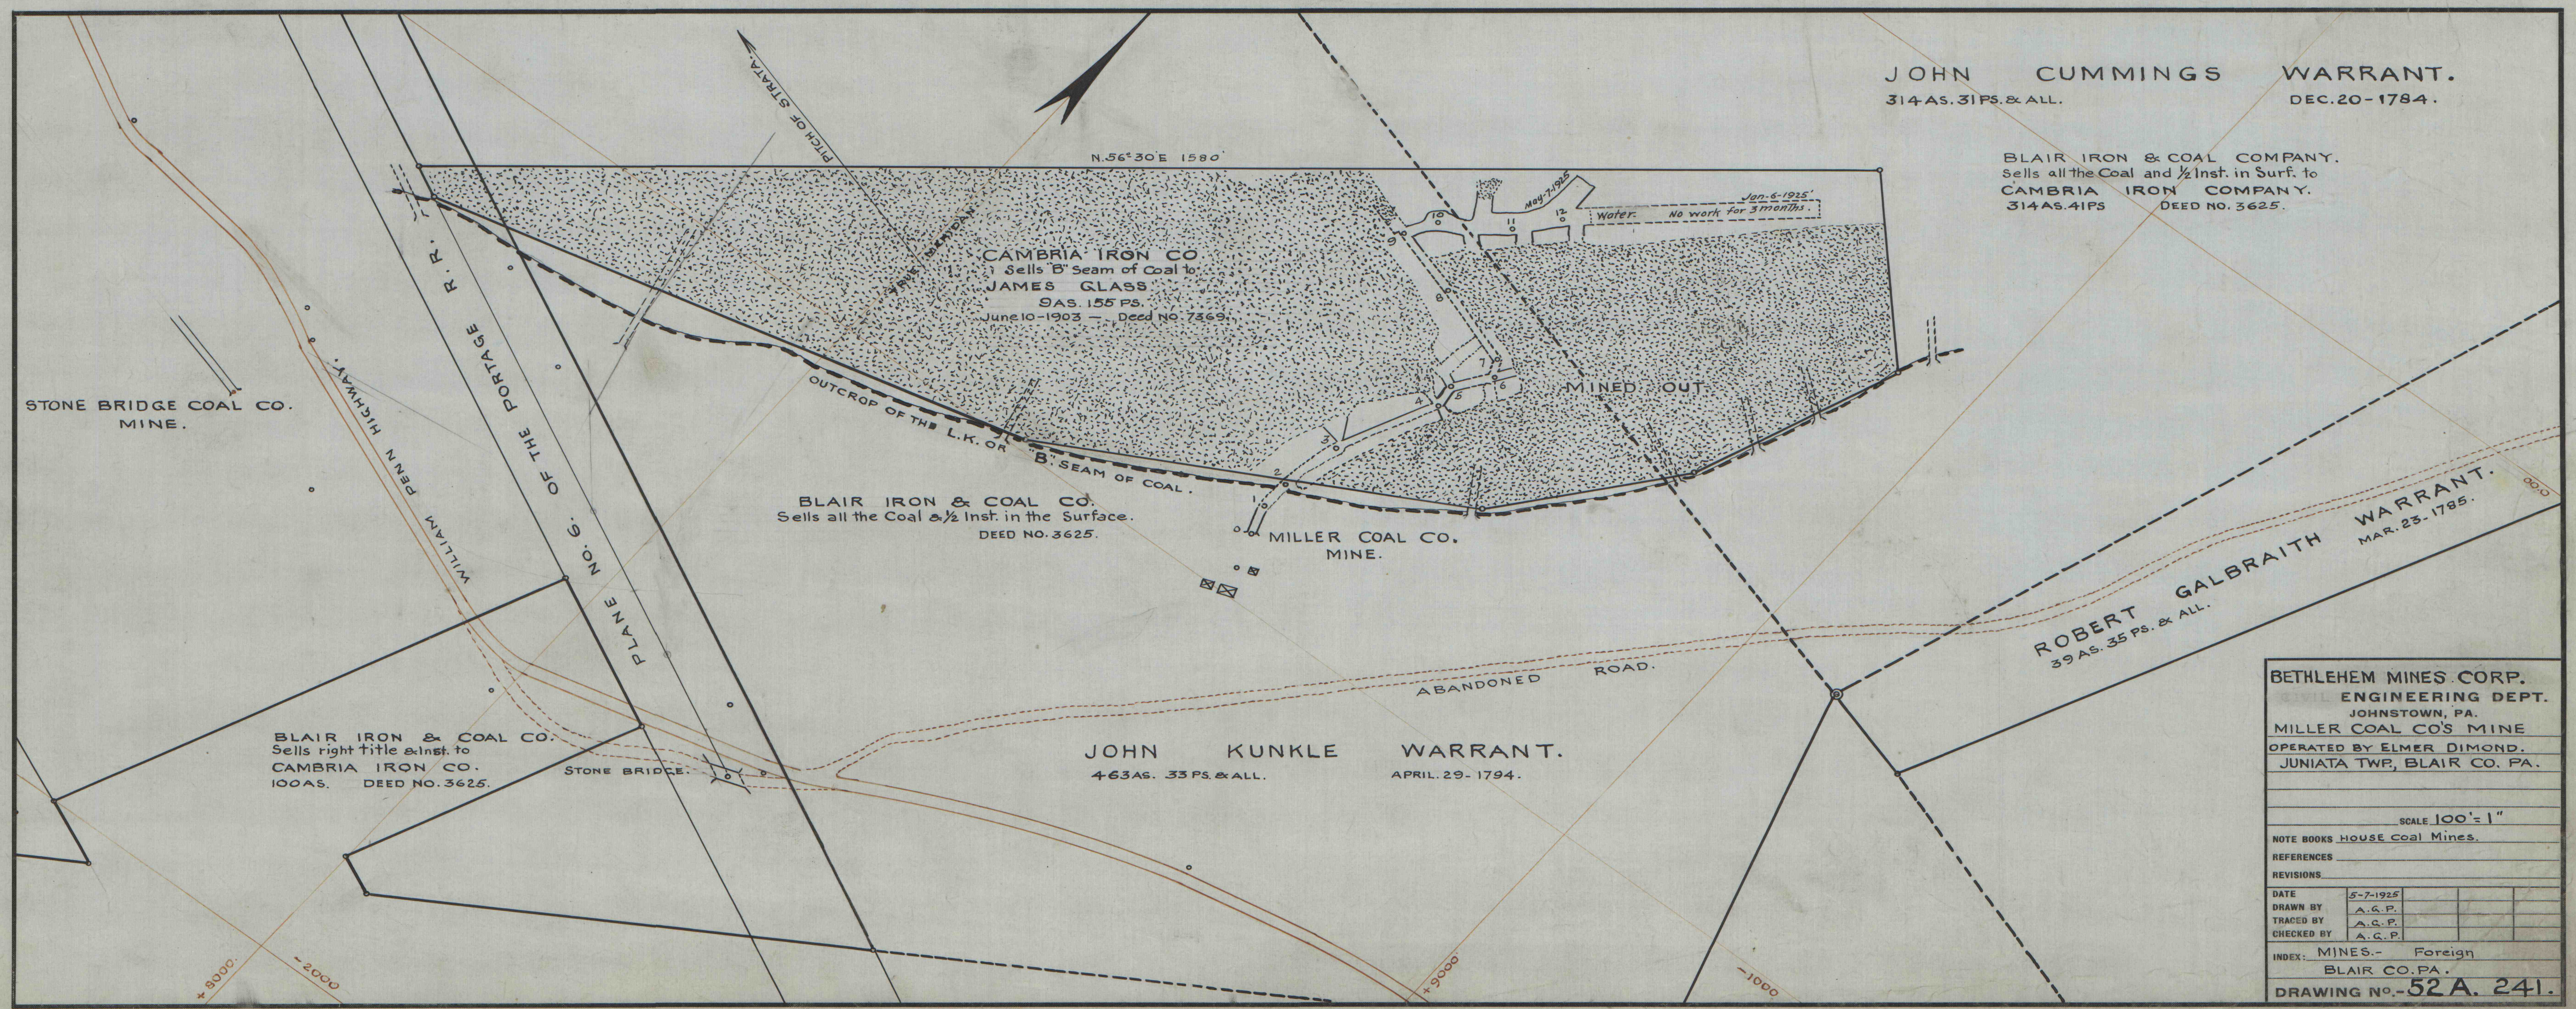

D-9