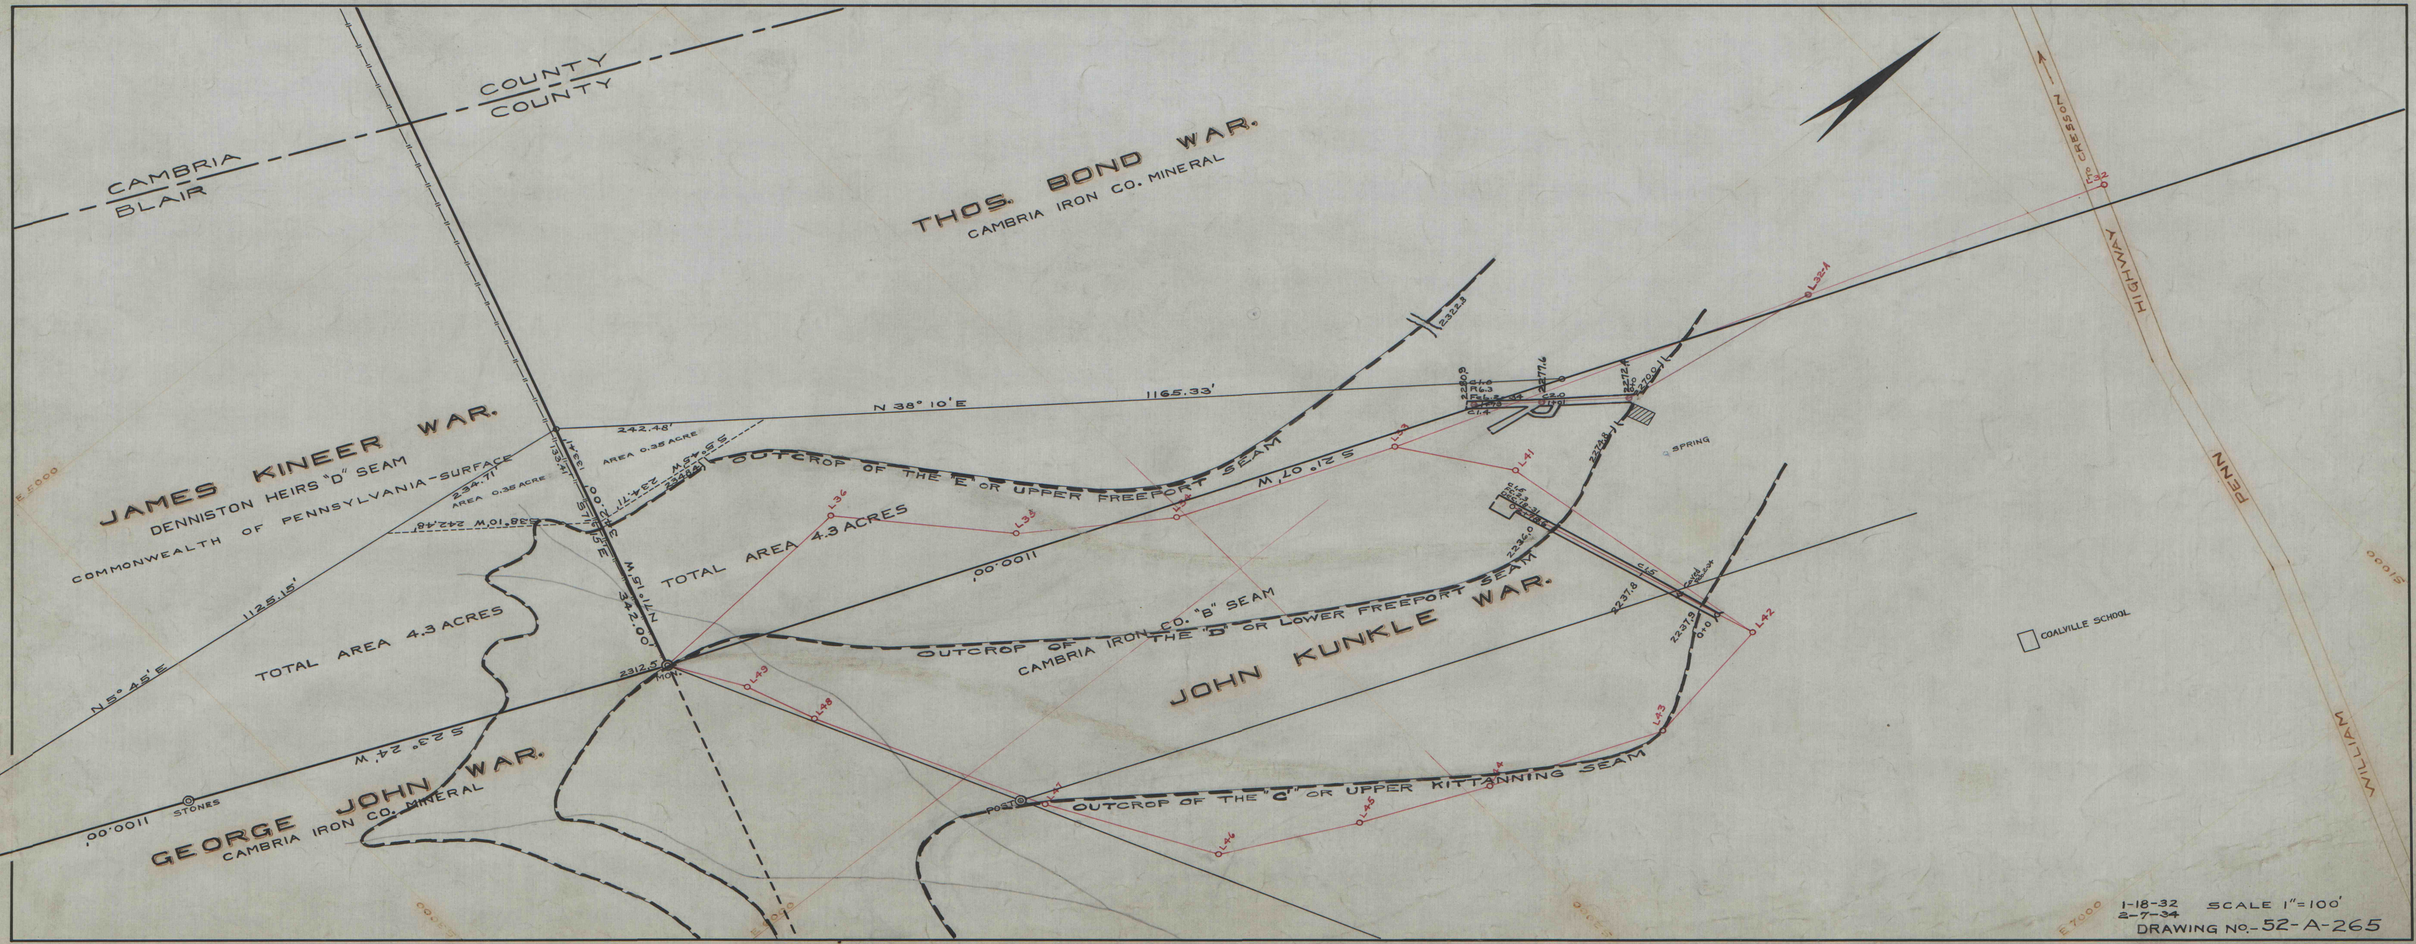
CAMBRIA
BLAIR
COUNTY
COUNTY
THOS. BOND WAR.
CAMBRIA IRON CO. MINERAL
JAMES KINEER WAR.
DENNISTON HEIRS "D" SEAM
COMMONWEALTH OF PENNSYLVANIA-SURFACE
JOHN KUNKLE WAR.
GEORGE JOHN WAR.
CAMBRIA IRON CO. MINERAL
N 38° 10' E
1165.33'
242.48'
AREA 0.35 ACRE
234.77'
AREA 0.35 ACRE
S 38° 10' W 242.48'
1125.15'
N 5° 45' E
S 23° 24' W
N 71° 15' W
342.00'
TOTAL AREA 4.3 ACRES
TOTAL AREA 4.3 ACRES
OUTCROP OF THE "E" OR UPPER FREEPORT SEAM
OUTCROP OF CAMBRIA IRON CO. "B" SEAM
THE "B" OR LOWER FREEPORT SEAM
OUTCROP OF THE "C" OR UPPER KITTANNING SEAM
SPRING
COALVILLE SCHOOL
PENN WILLIAM HIGHWAY
To GRESSON
STONES
POST
MON
E 7000
1-18-32
2-7-34
SCALE 1"=100'
DRAWING No.-52-A-265
Exchange-4
D-9