


BETHLEHEM STEEL PRODUCTS CO.  
OWNS COAL.

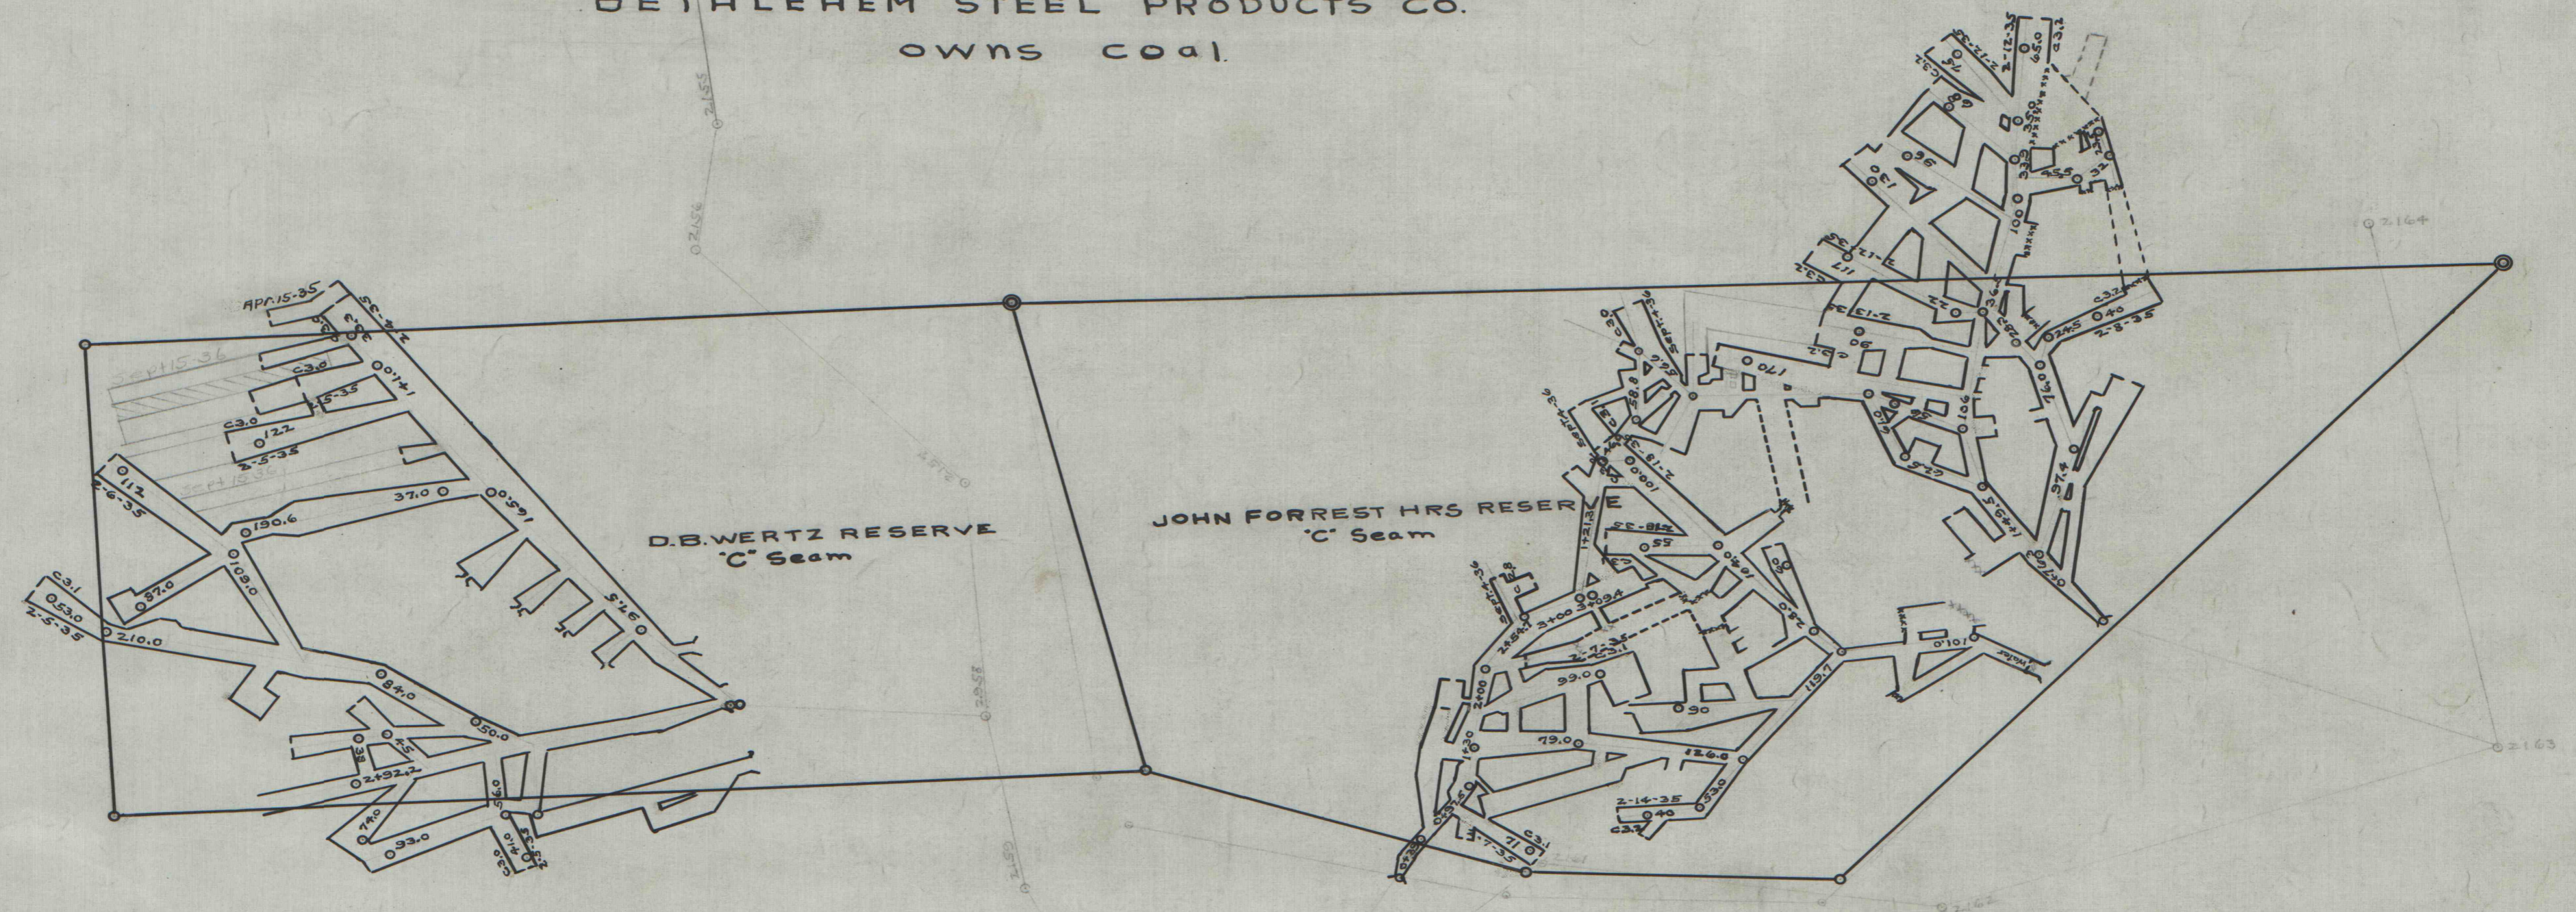

MAP SHOWING WORKINGS IN CEMENT SEAM  
D.B. WERTZ AND JOHN FORREST RESERVE  
SITUATE  
CONEMAUGH TWP SOMERSET COUNTY PENNA.  
SCALE 1"=100' APRIL-10-1935.

52-A-276

D-9