


see 52-A-278 of addition

JACOB MENELY

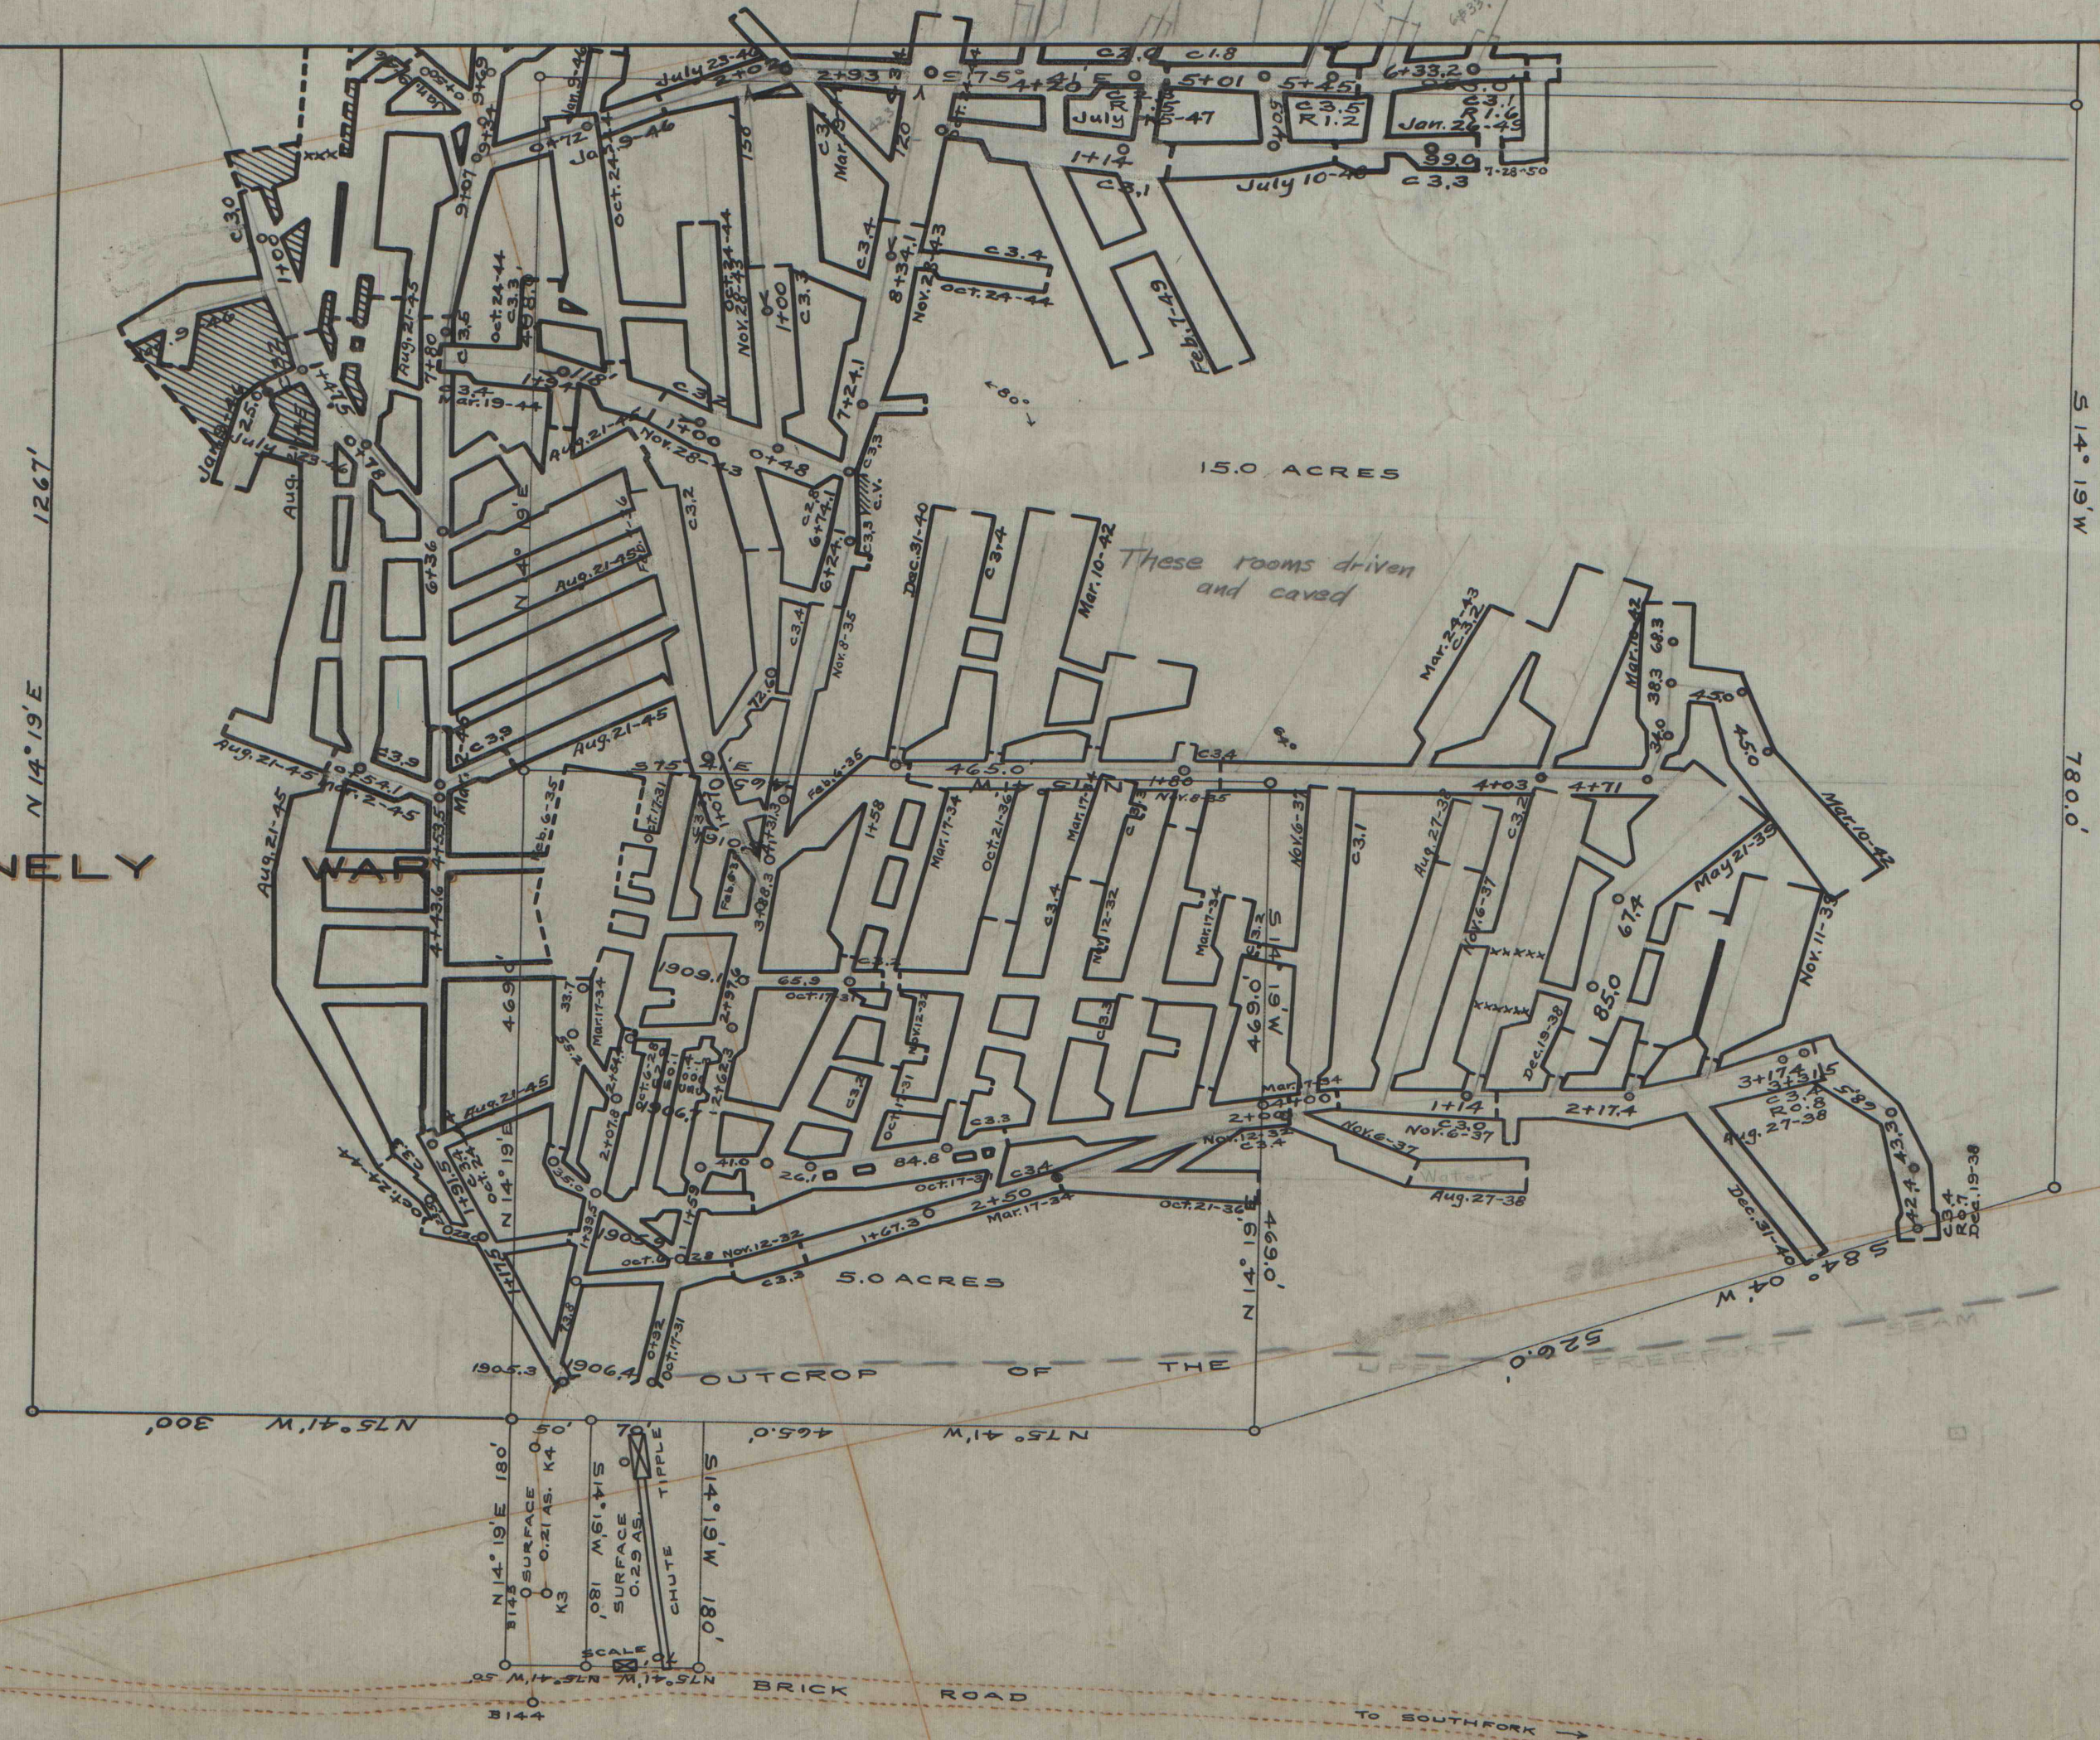

MAP OF A. C. KING MINE
 UPPER FREEPORT SEAM
 SITUATE
 CONEMAUGH TOWNSHIP, CAMBRIA COUNTY,
 PENNA.
 SCALE 1" = 100' JUNE 10-1935

52-A-278

D-9