


MAP
 TO ACCOMPANY THE AGREEMENT
 BETWEEN
BETHLEHEM STEEL COMPANY
 AND
GEORGE W. GRIFFITH
 SITUATE IN LOWER YODER TWP, CAMBRIA CO., PENNA.
 SCALE 1"=100' MAY 27, 1946.

BATEY

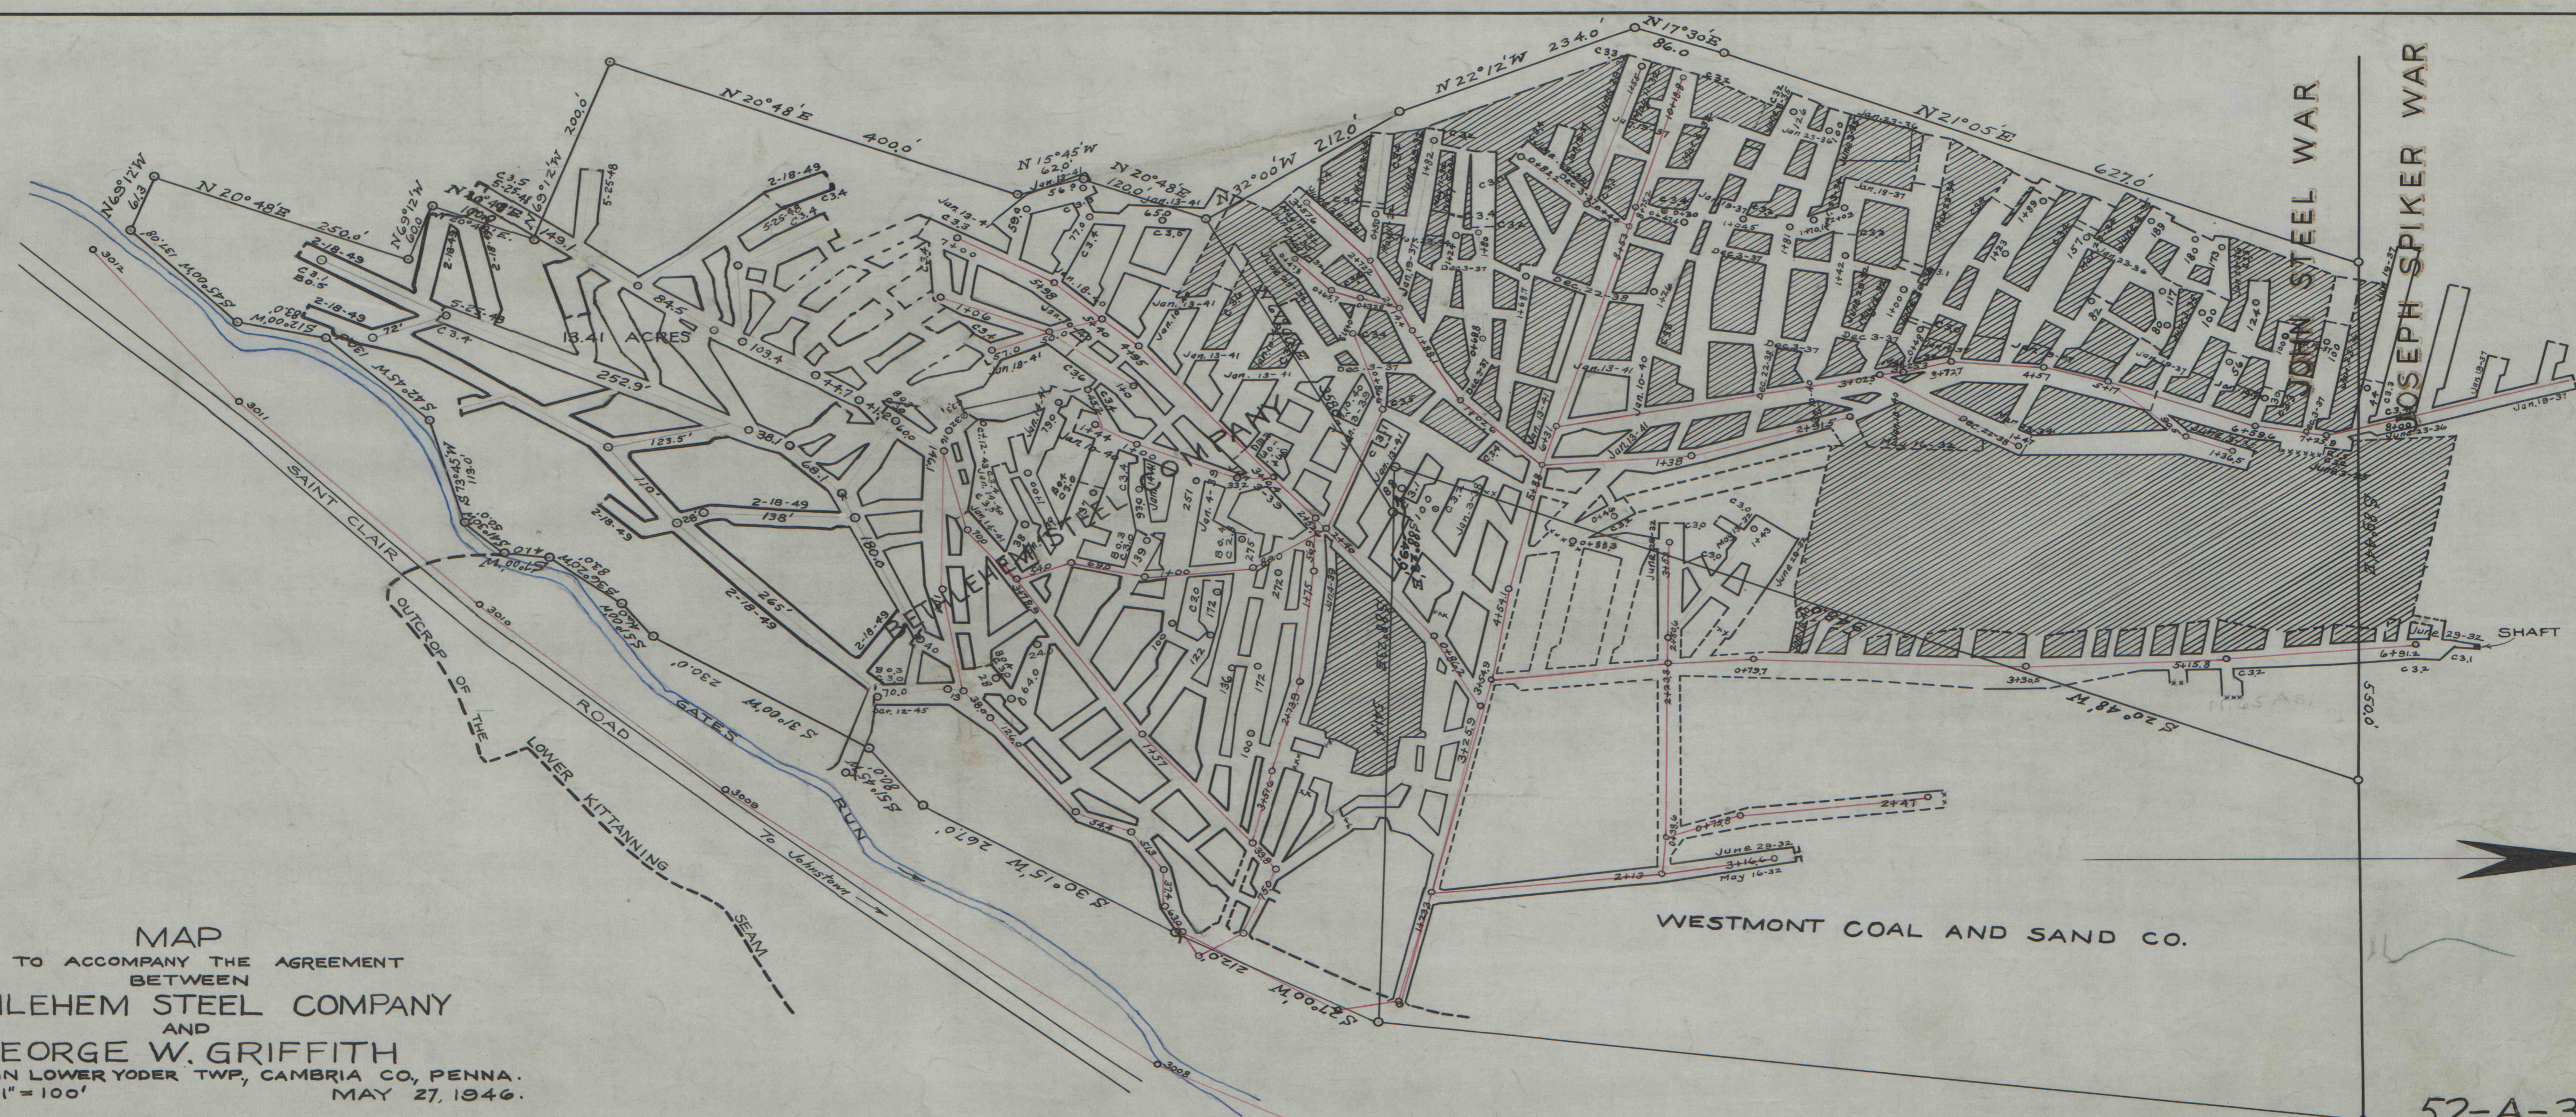

JOHNSTOWN WATER CO
 IN FEE

52-A-396

D-9