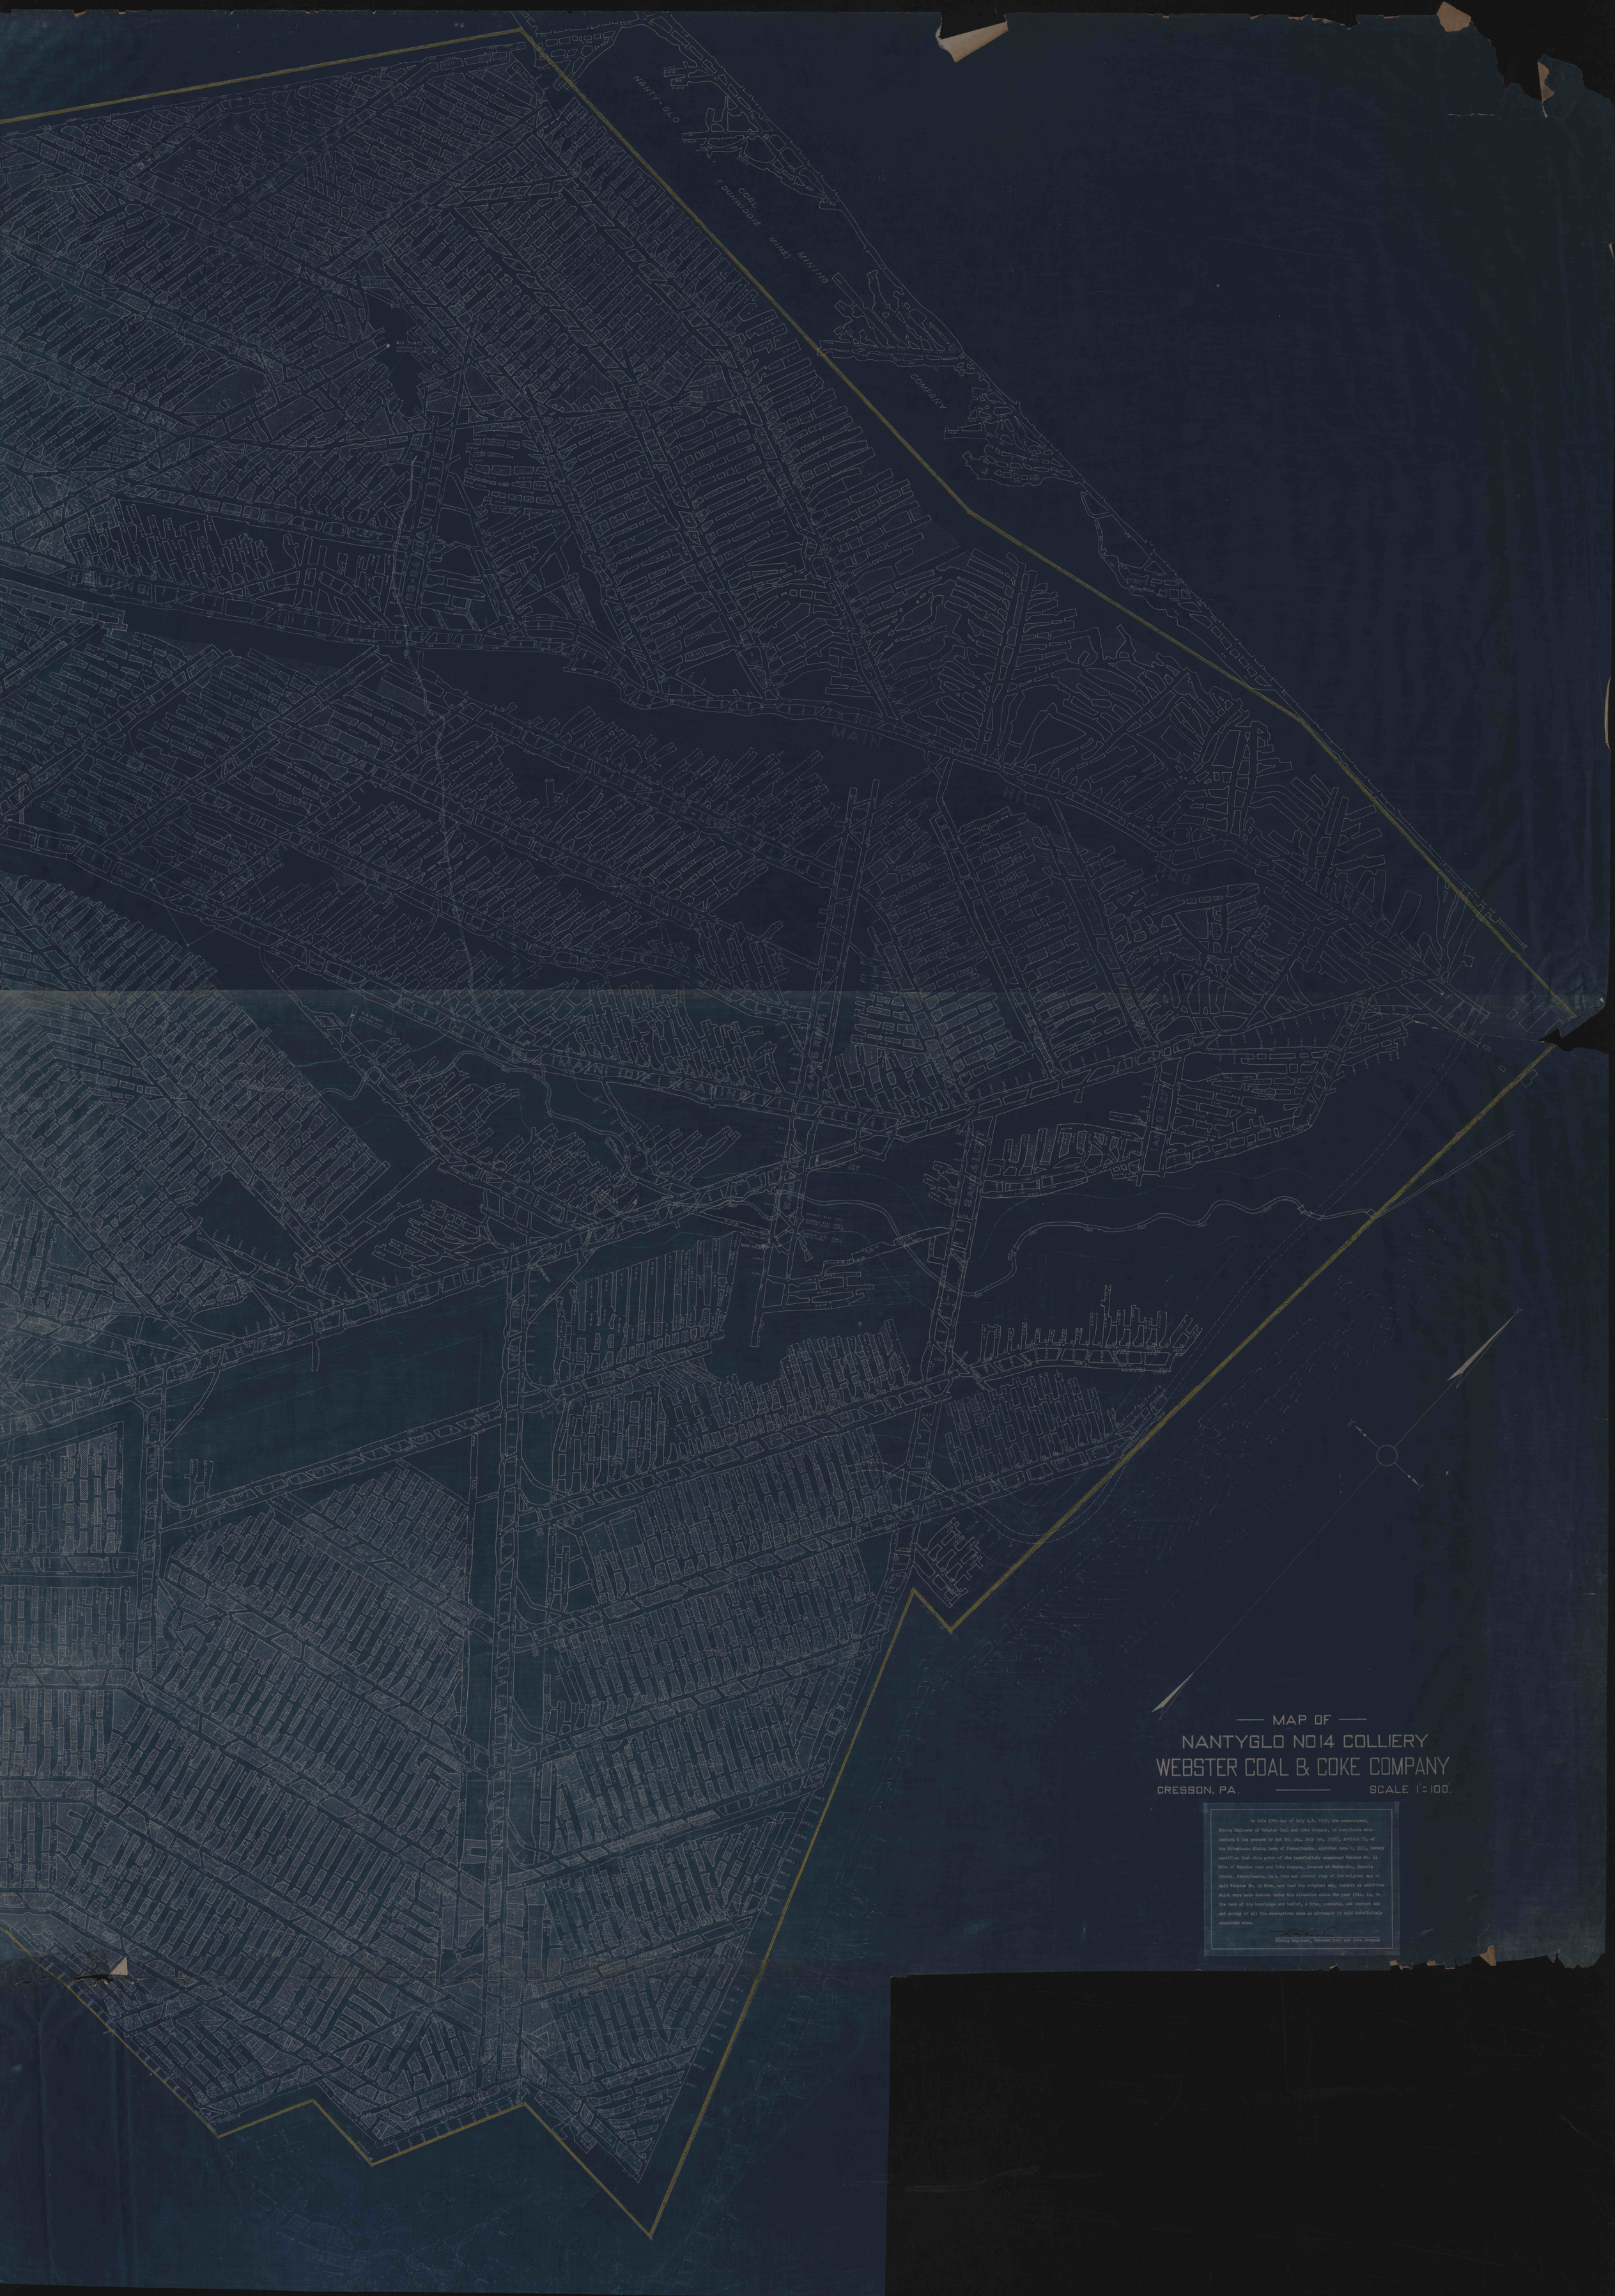
NANTY-GLO
COAL
(DUNWOODIE MINE) MINING
COMPANY
HEADING
MAIN
MAIN
HEADING
BANK
HUG
MAP OF
NANTYGLO NO14 COLLIERY
WEBSTER COAL & COKE COMPANY
CRESSON, PA.
SCALE 1"=100'.
On this 13th day of July A.D. 1943, the undersigned,
Mining Engineer of Webster Coal and Coke Company, in compliance with
Section 6 (as amended by Act No. 444, July 1st, 1937), Article II, of
the Bituminous Mining Laws of Pennsylvania, approved June 9, 1911, hereby
certifies that this print of the indefinitely abandoned Webster No. 14
Mine of Webster Coal and Coke Company, located at Nanty-Glo, Cambria
County, Pennsylvania, is a true and correct copy of the original map of
said Webster No. 14 Mine, and that the original map, insofar as additions
which were made thereto under his direction since the year 1912, is, to
the best of his knowledge and belief, a true, complete, and correct map
and survey of all the excavations made as aforesaid in said indefinitely
abandoned mine.
Mining Engineer, Webster Coal and Coke Company