
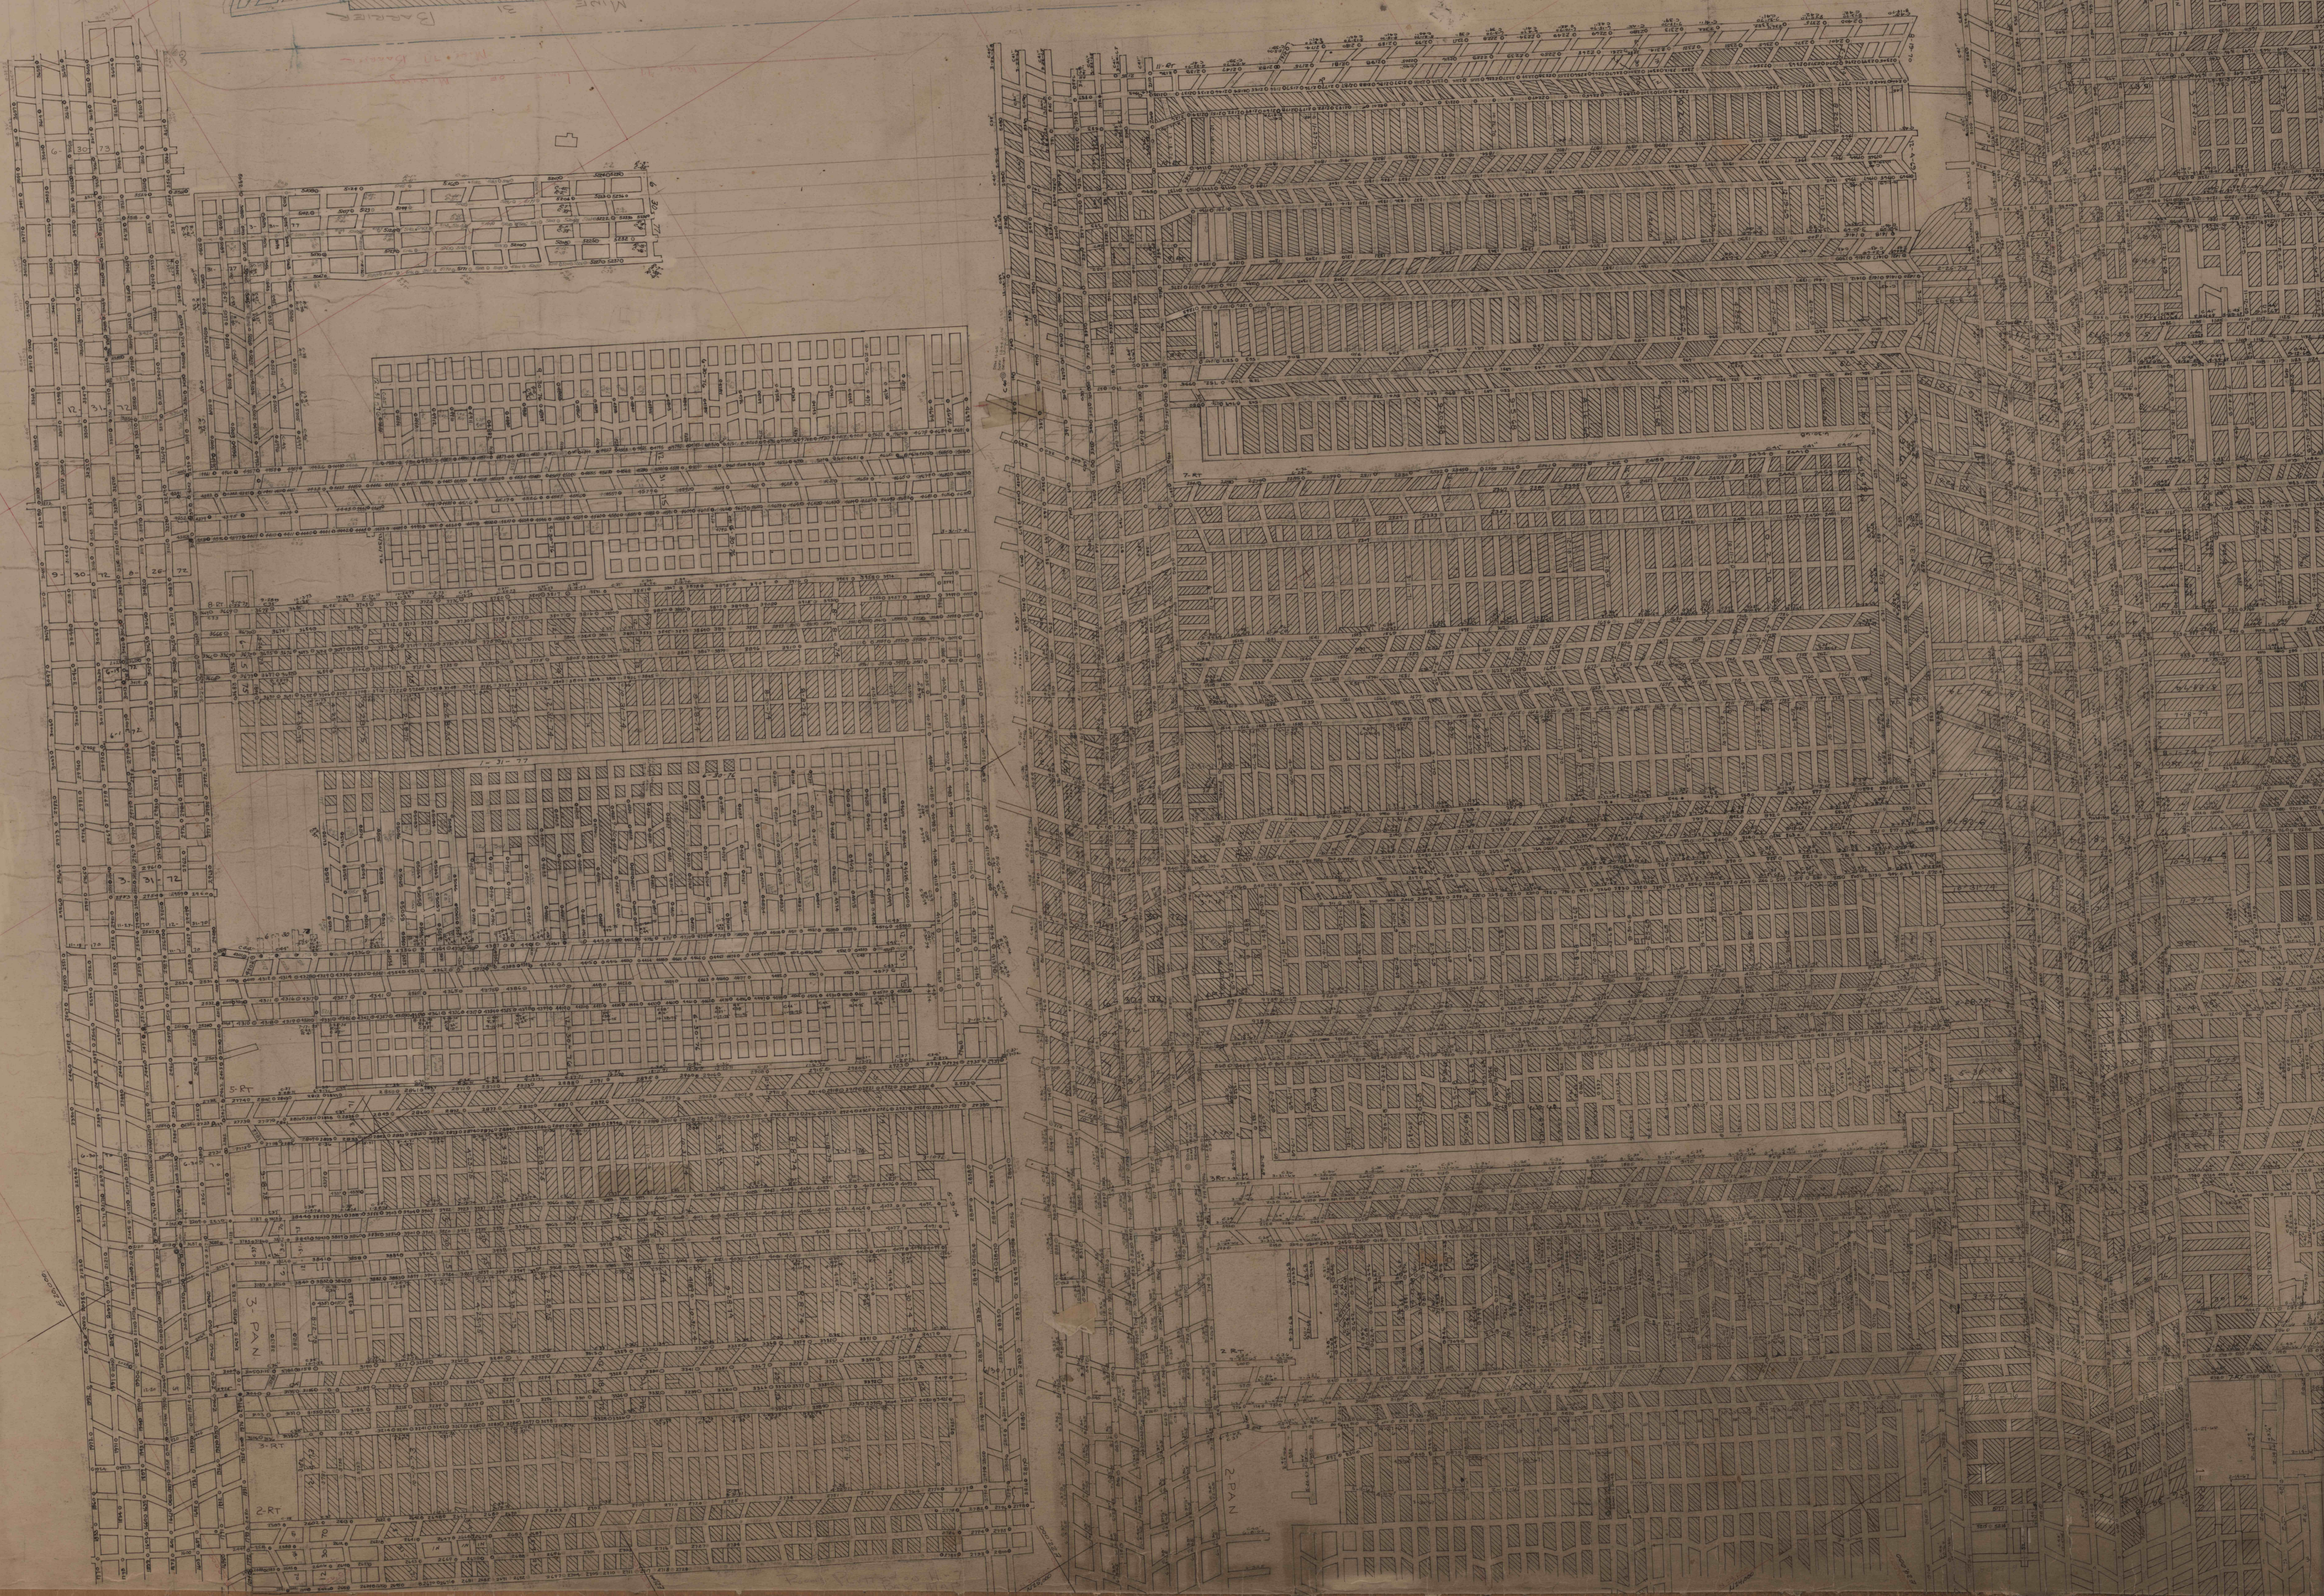


MINE 77  
MAP G-2

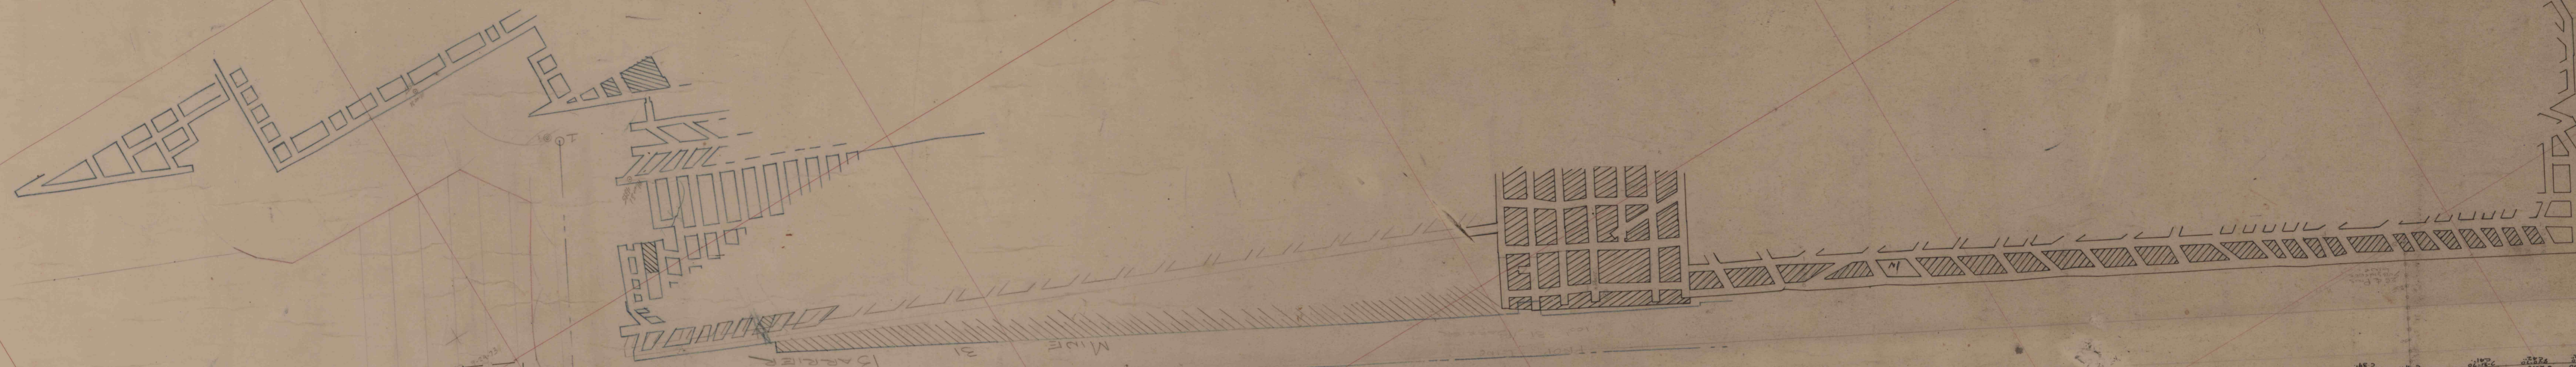

MINE 77  
MAP G-2