

MAP 77
MINE H-7

N 29,000

E 12,000

N 26,000

E 12,000


N 25,000

N 24,000

E 12,000

N 23,000

3/4 PANEL

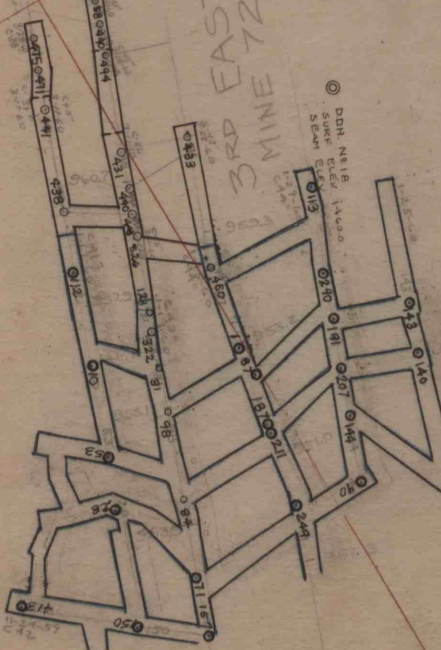

MAP 77
MINE H-7