


**MAP**  
**OF THE**  
**LEMON MINE**  
 OPERATED BY  
**THE TUNNEL MINING CO.**  
 SITUATE  
 BLAIR AND CAMBRIA COUNTIES  
 PENNSYLVANIA  
 Jan. 10, 1906

OUTCROP OF THE LEMON SEAM.

JOHN CUMMINS TRACT.

JOHN TAYLOR TRACT.

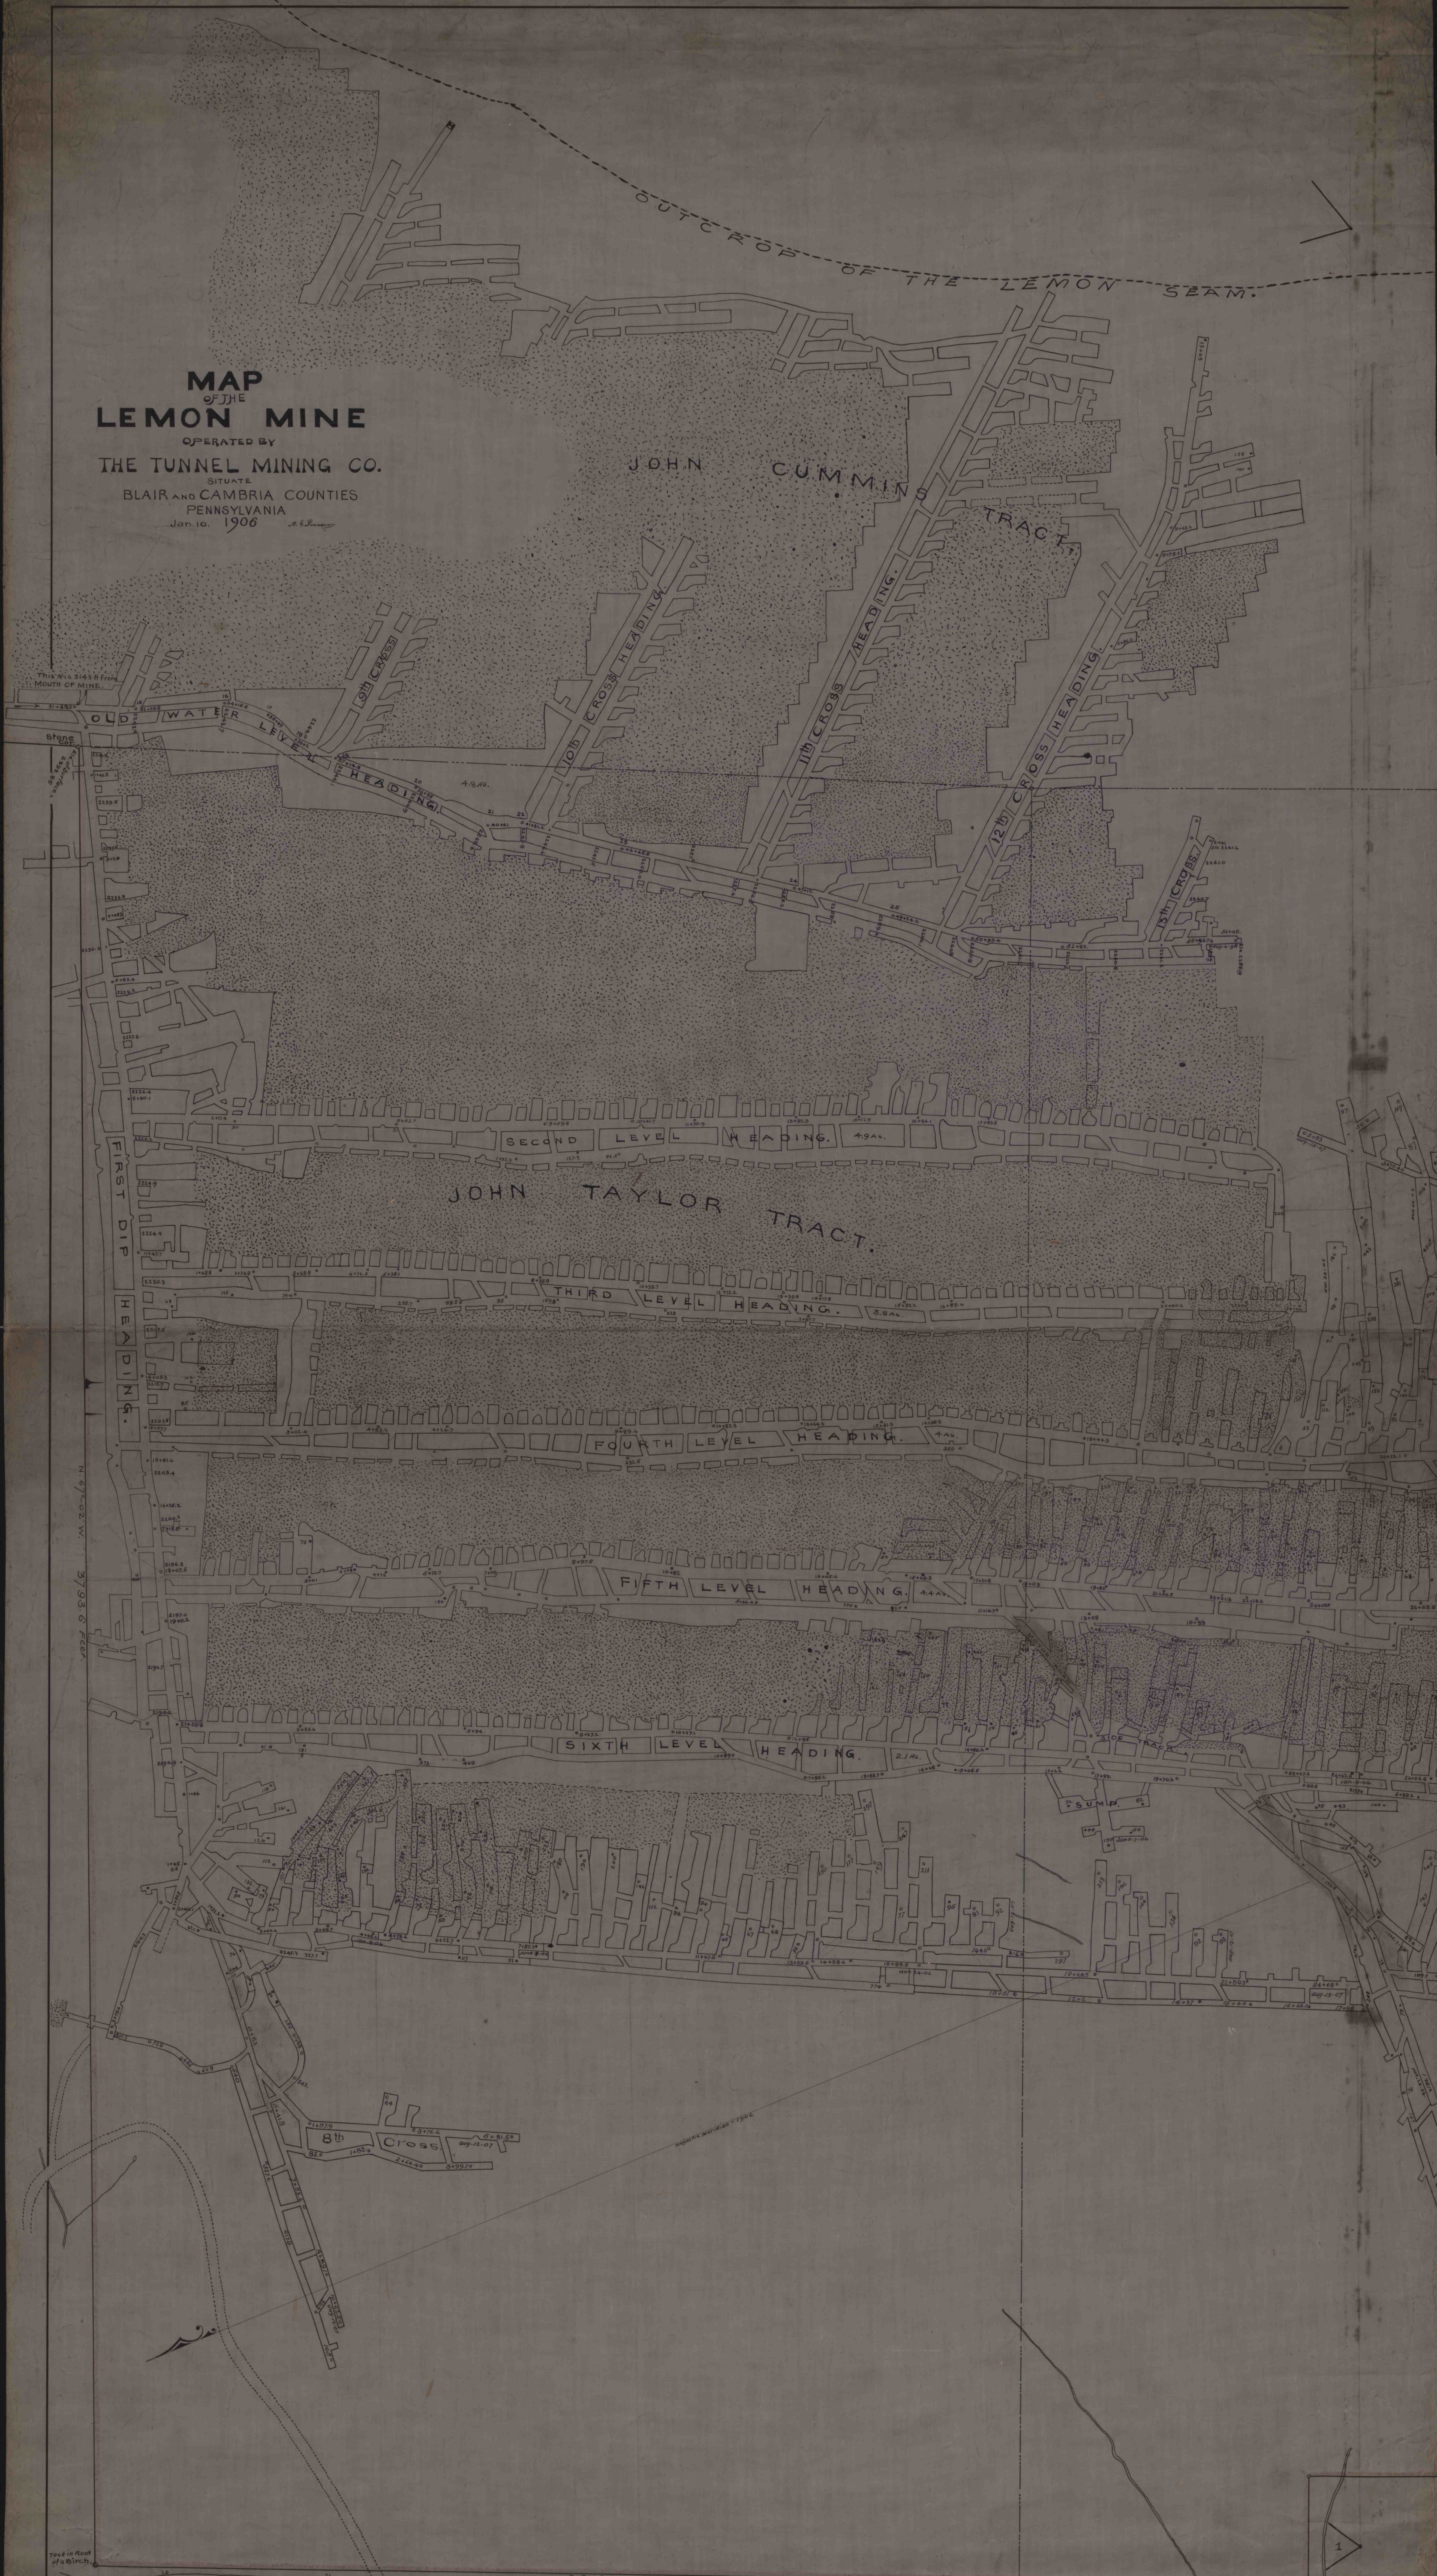

INDEX NO. 53/184

TAYLOR & MCGOY MINE OPERATIONS.

L.B.2-2