


CAMBRIA IRON COMPANY

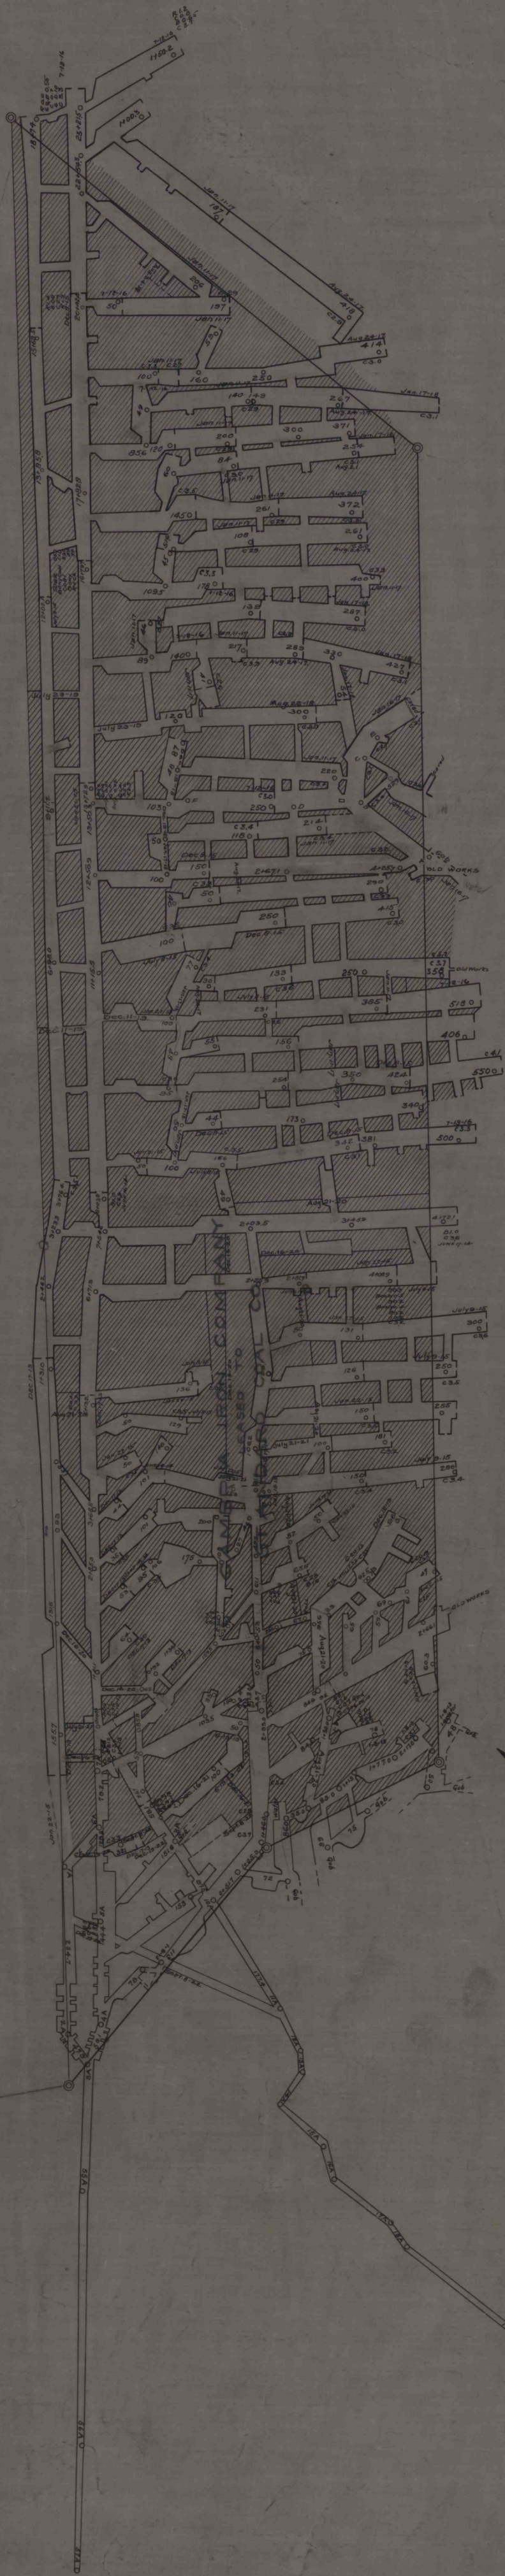

MAP OF MINE
OPERATED BY
STANDARD COAL COMPANY
SITUATE
CRESSON TOWNSHIP
CAMBRIA COUNTY
PENNA.

SCALE 1 IN 100 FT

TRUE MERIDIAN