


CAMBRIA IRON COMPANY  
WILLIAM LANE WARRANT, AUG 11-1829  
PROPERTY.

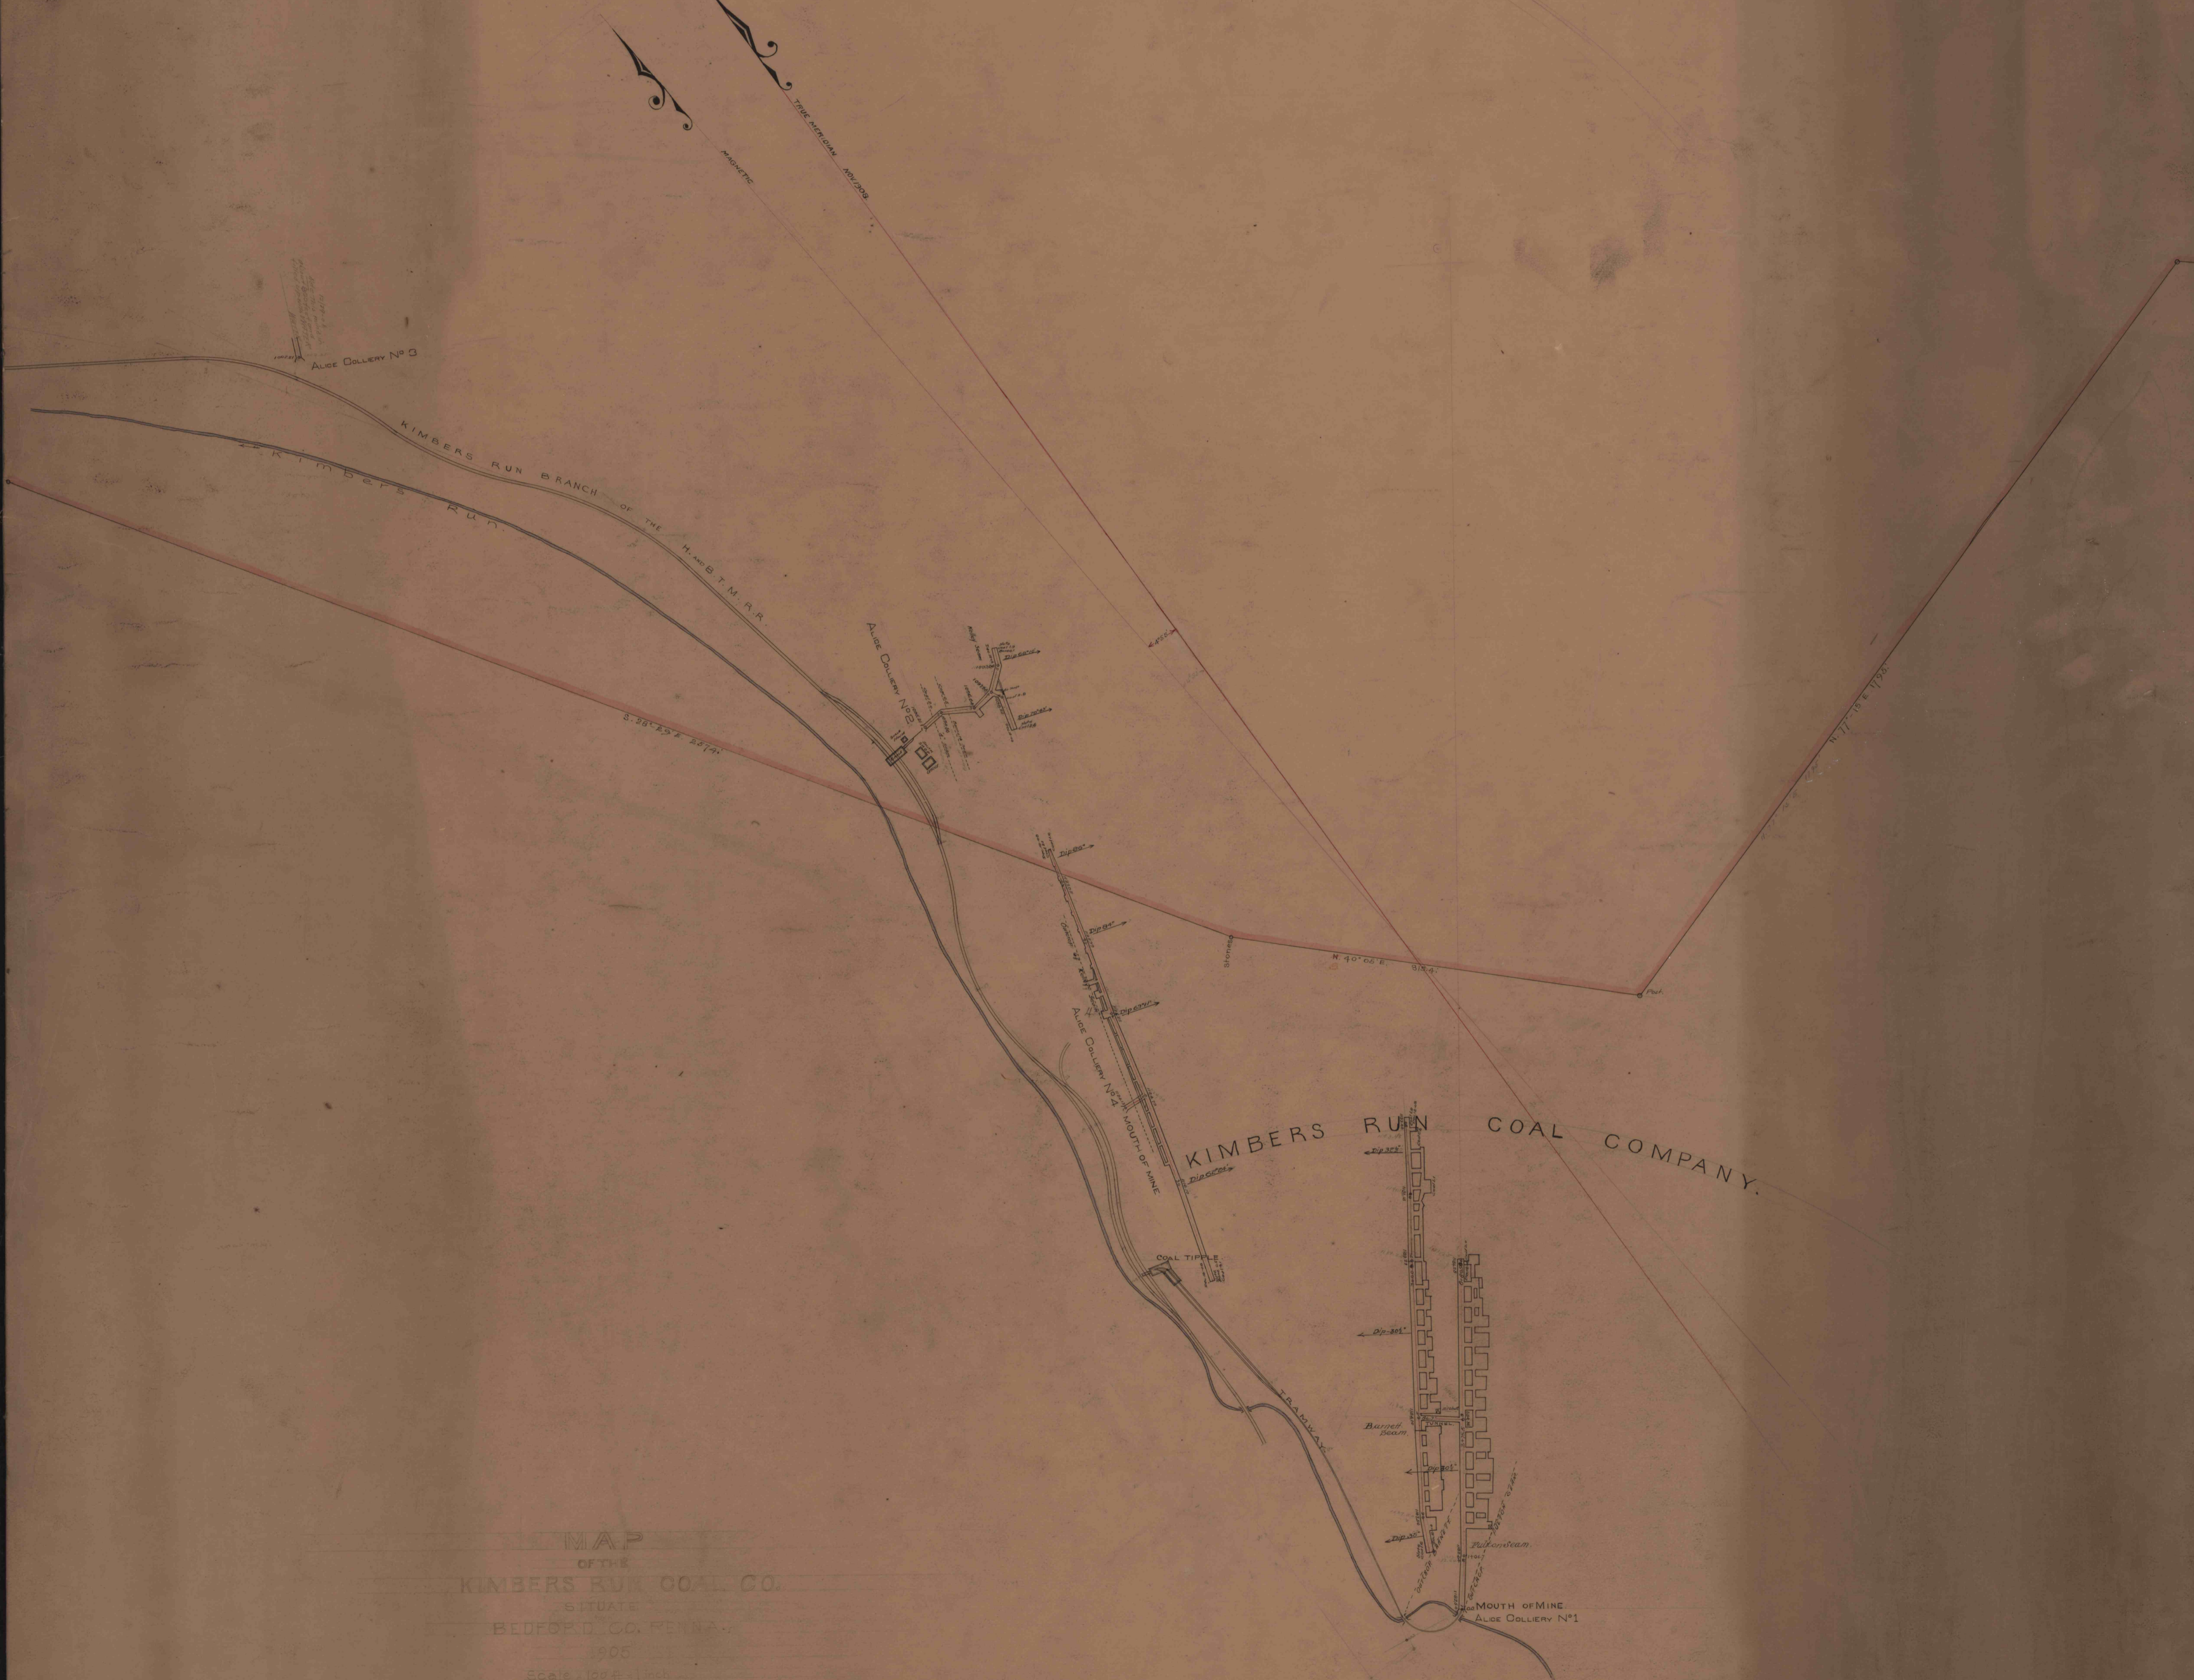

MAP  
OF THE  
KIMBERS RUN COAL CO.  
SITUATE  
BEDFORD CO. PENN.  
1905  
Scale 100 ft. = 1 in.