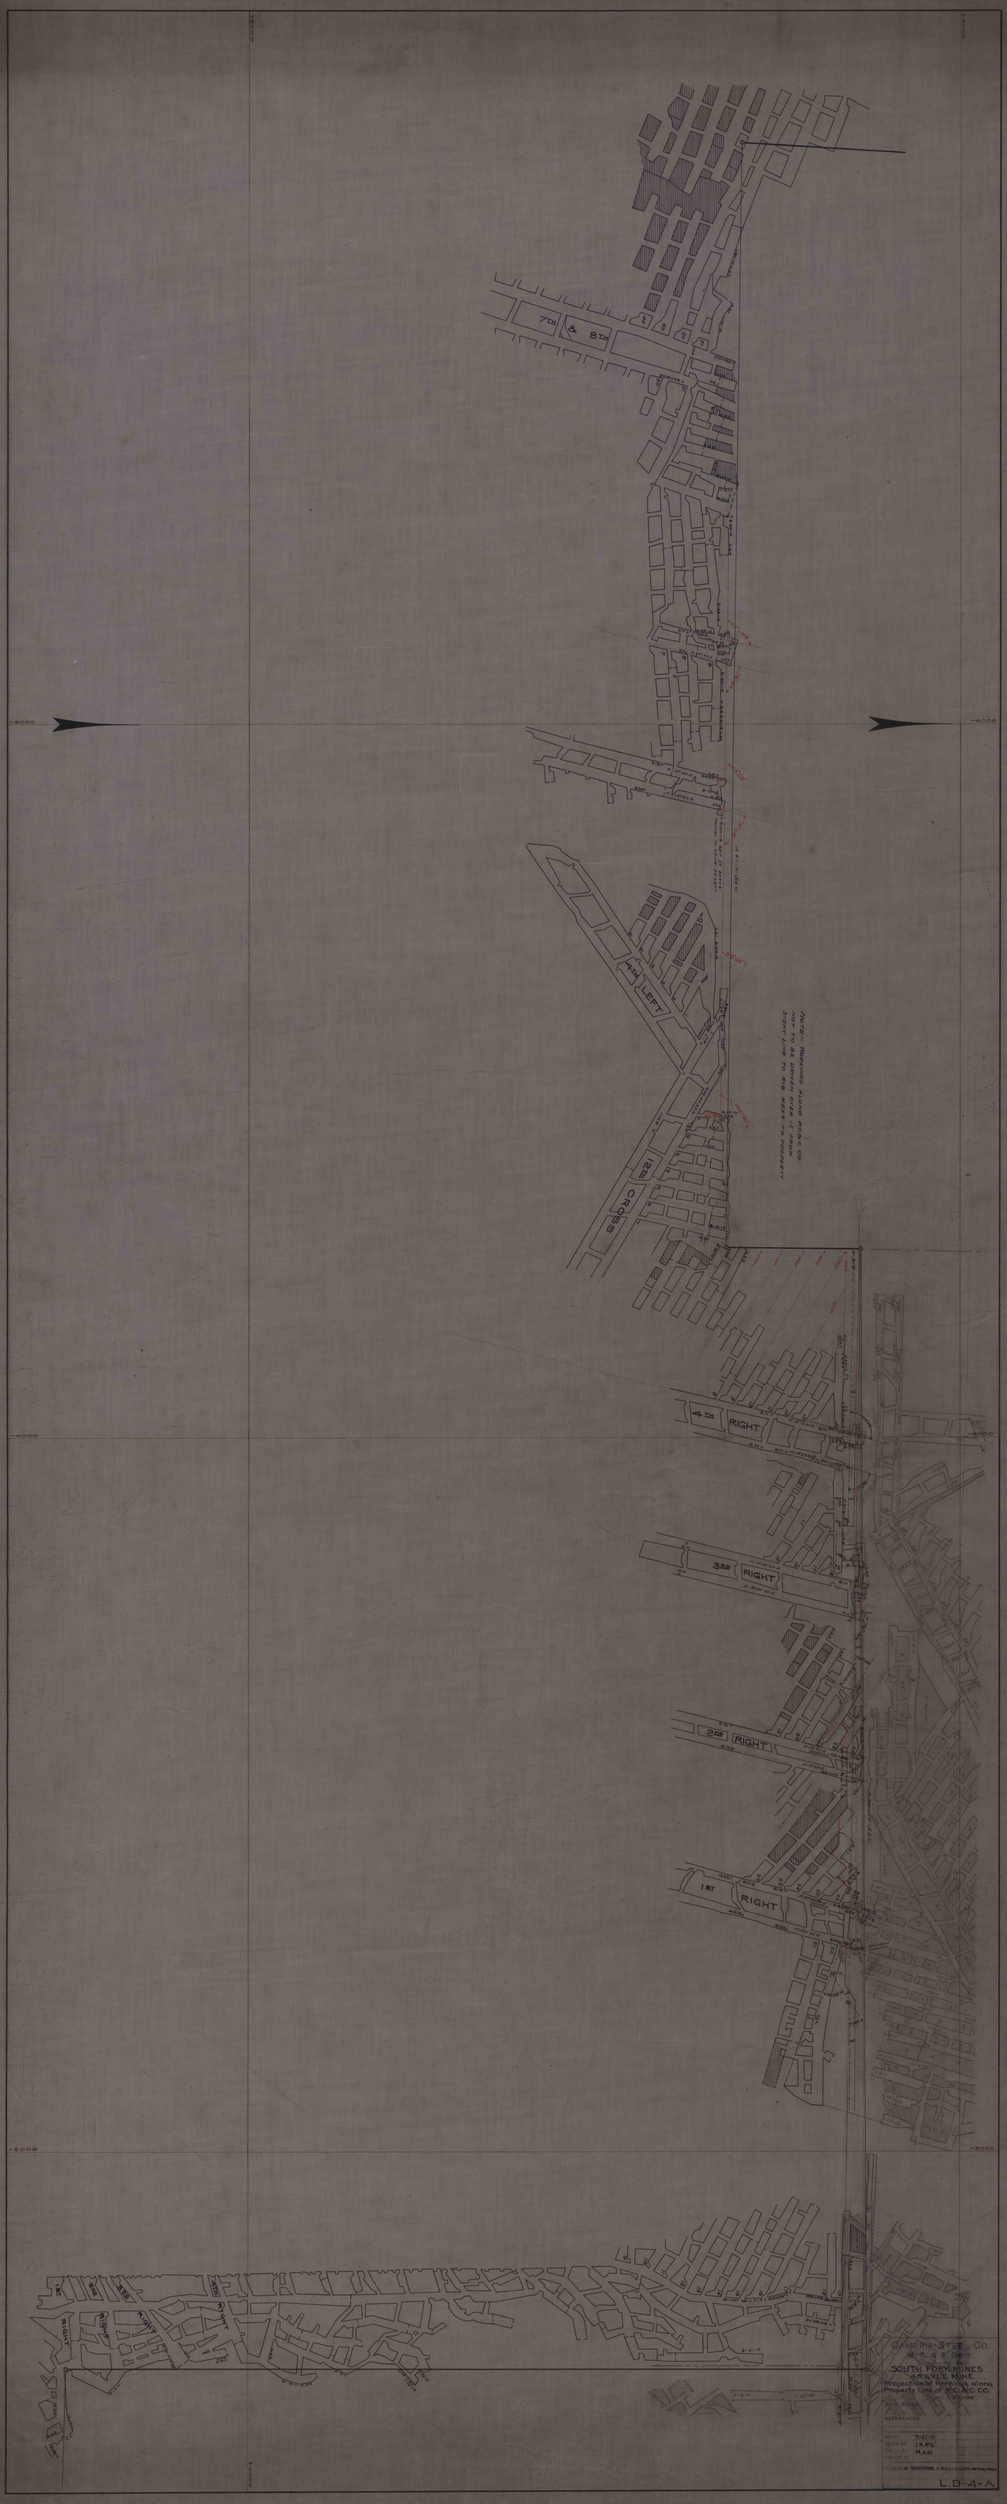
7TH & 8TH
4TH LEFT
12TH CROSS
4TH RIGHT
3RD RIGHT
2ND RIGHT
1ST RIGHT
NOTE:- WORKINGS ALONG R.C.&C. CO. NOT TO BE DRIVEN OVER IS FROM SIGHT LINE TO RIG NEAT TO PROPERTY
GAMORN STEEL CO.
M.T. & S. Dept.
SOUTH FORK MINES
ARGYLE MINE
Projection of Workings along Property Line of R.C.&C. CO.
1" = 100'
REFERENCES
DATE 9-27-12
DRAWN BY J.R.W.G.
CHECKED BY M.A.W.
PROJECT BY
G. SOUTHFORK, C.S.CO. LEASED working maps
L.B-4-A