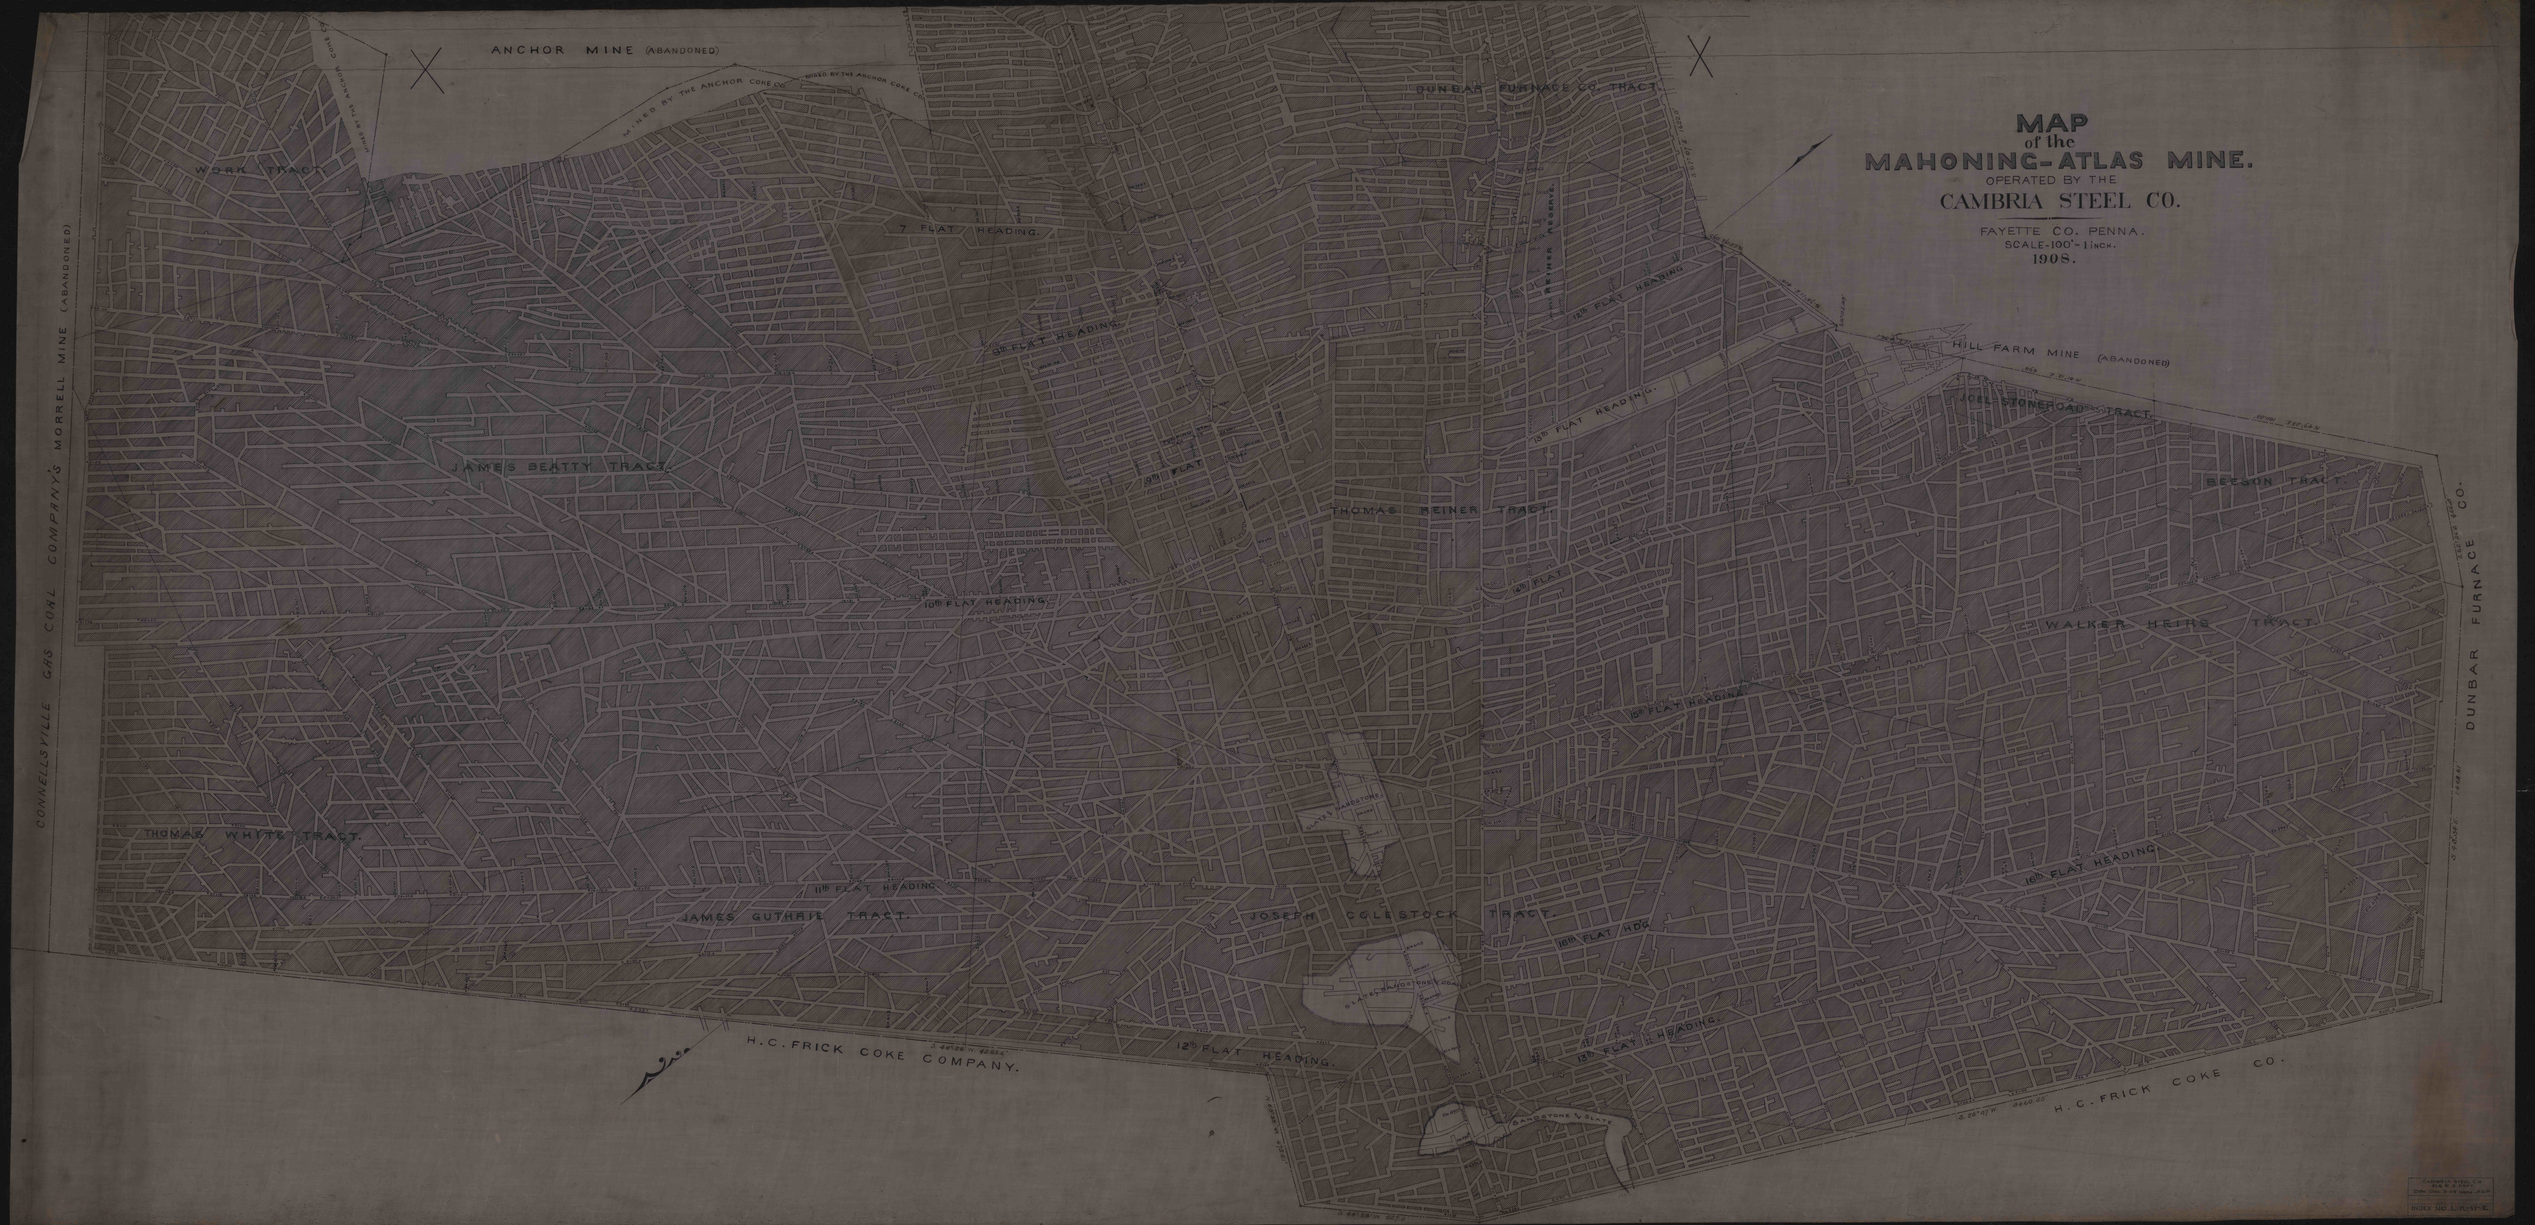
MAP
of the
MAHONING-ATLAS MINE.
OPERATED BY THE
CAMBRIA STEEL CO.
FAYETTE CO. PENNA.
SCALE-100'-1 INCH.
1908.
ANCHOR MINE (ABANDONED)
MINED BY THE ANCHOR COKE CO.
WORK TRACT
7 FLAT HEADING.
3rd FLAT HEADING.
9th FLAT
10th FLAT HEADING.
11th FLAT HEADING.
12th FLAT HEADING.
13th FLAT HEADING.
15th FLAT HEADING.
16th FLAT HDG.
18th FLAT HEADING.
JAMES BEATTY TRACT.
THOMAS WHITE TRACT.
JAMES GUTHRIE TRACT.
THOMAS BEINER TRACT
JOSEPH COLESTOCK TRACT.
DUNBAR FURNACE CO. TRACT
HILL FARM MINE (ABANDONED)
JOEL STONEROAD TRACT.
BEESON TRACT.
WALKER HEIRS TRACT.
CONNELLSVILLE GAS COAL COMPANY'S MORRELL MINE (ABANDONED)
H.C. FRICK COKE COMPANY.
H.C. FRICK COKE CO.
DUNBAR FURNACE CO.