


10 1/2
20

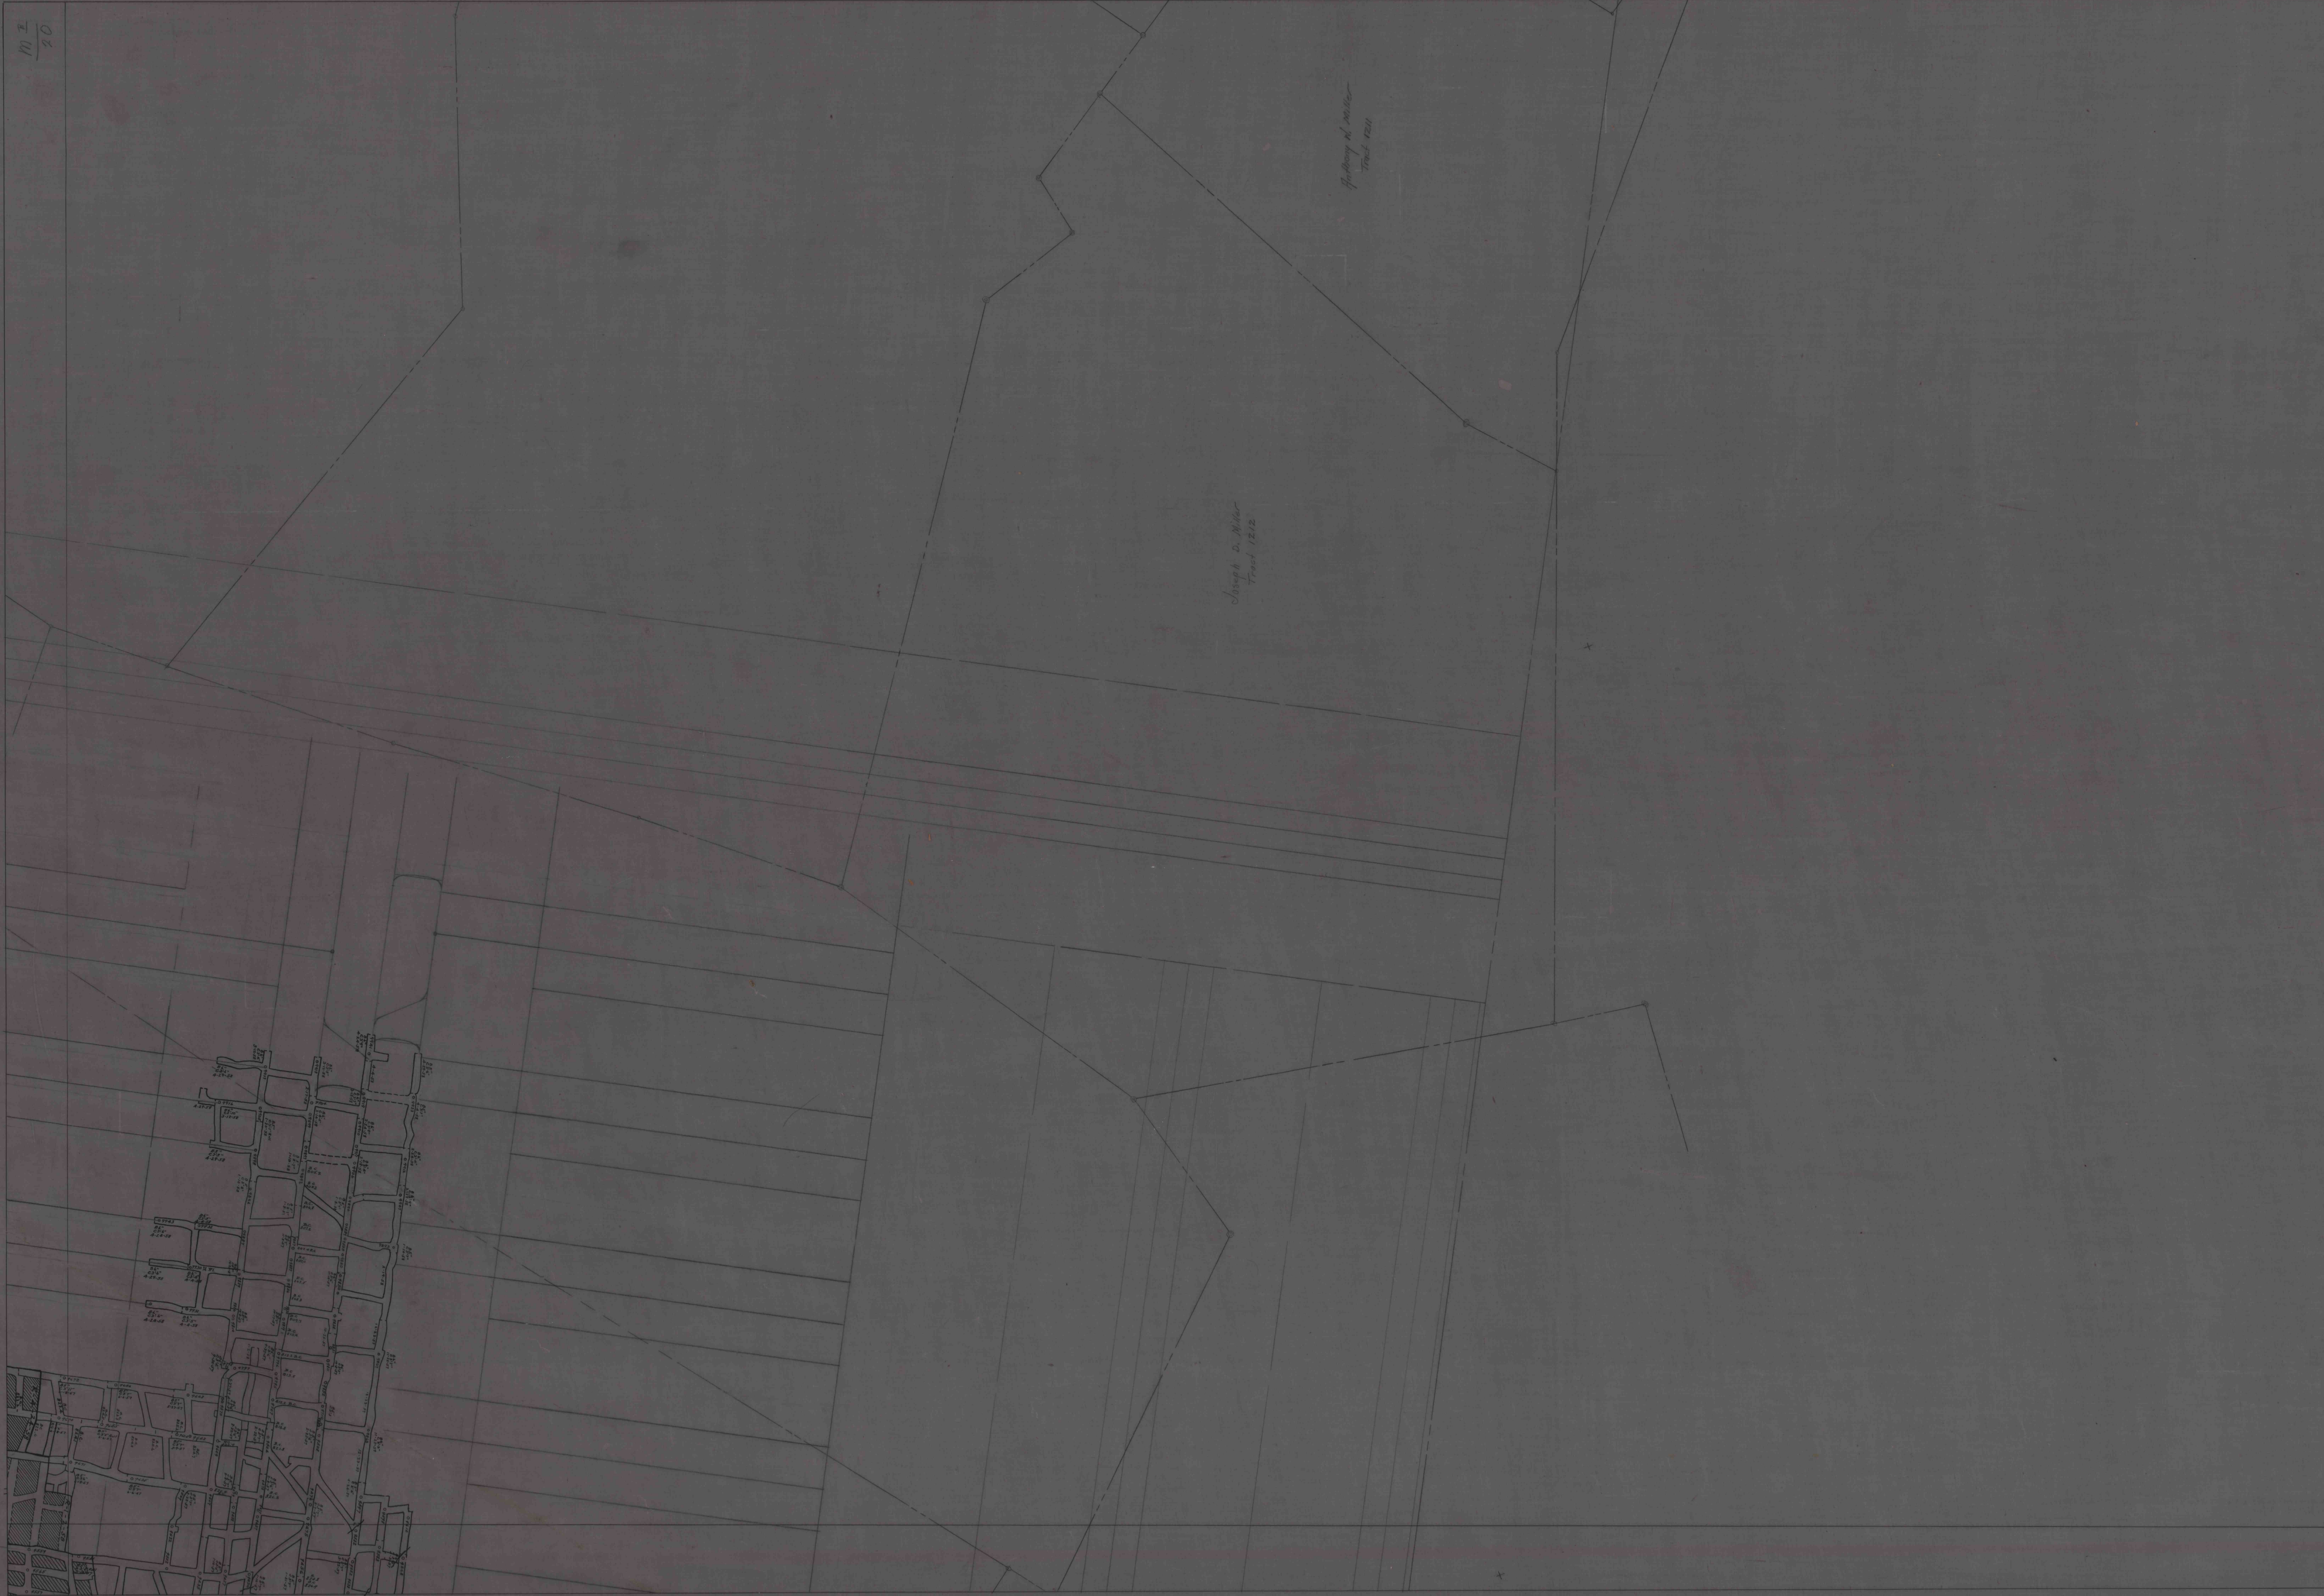


