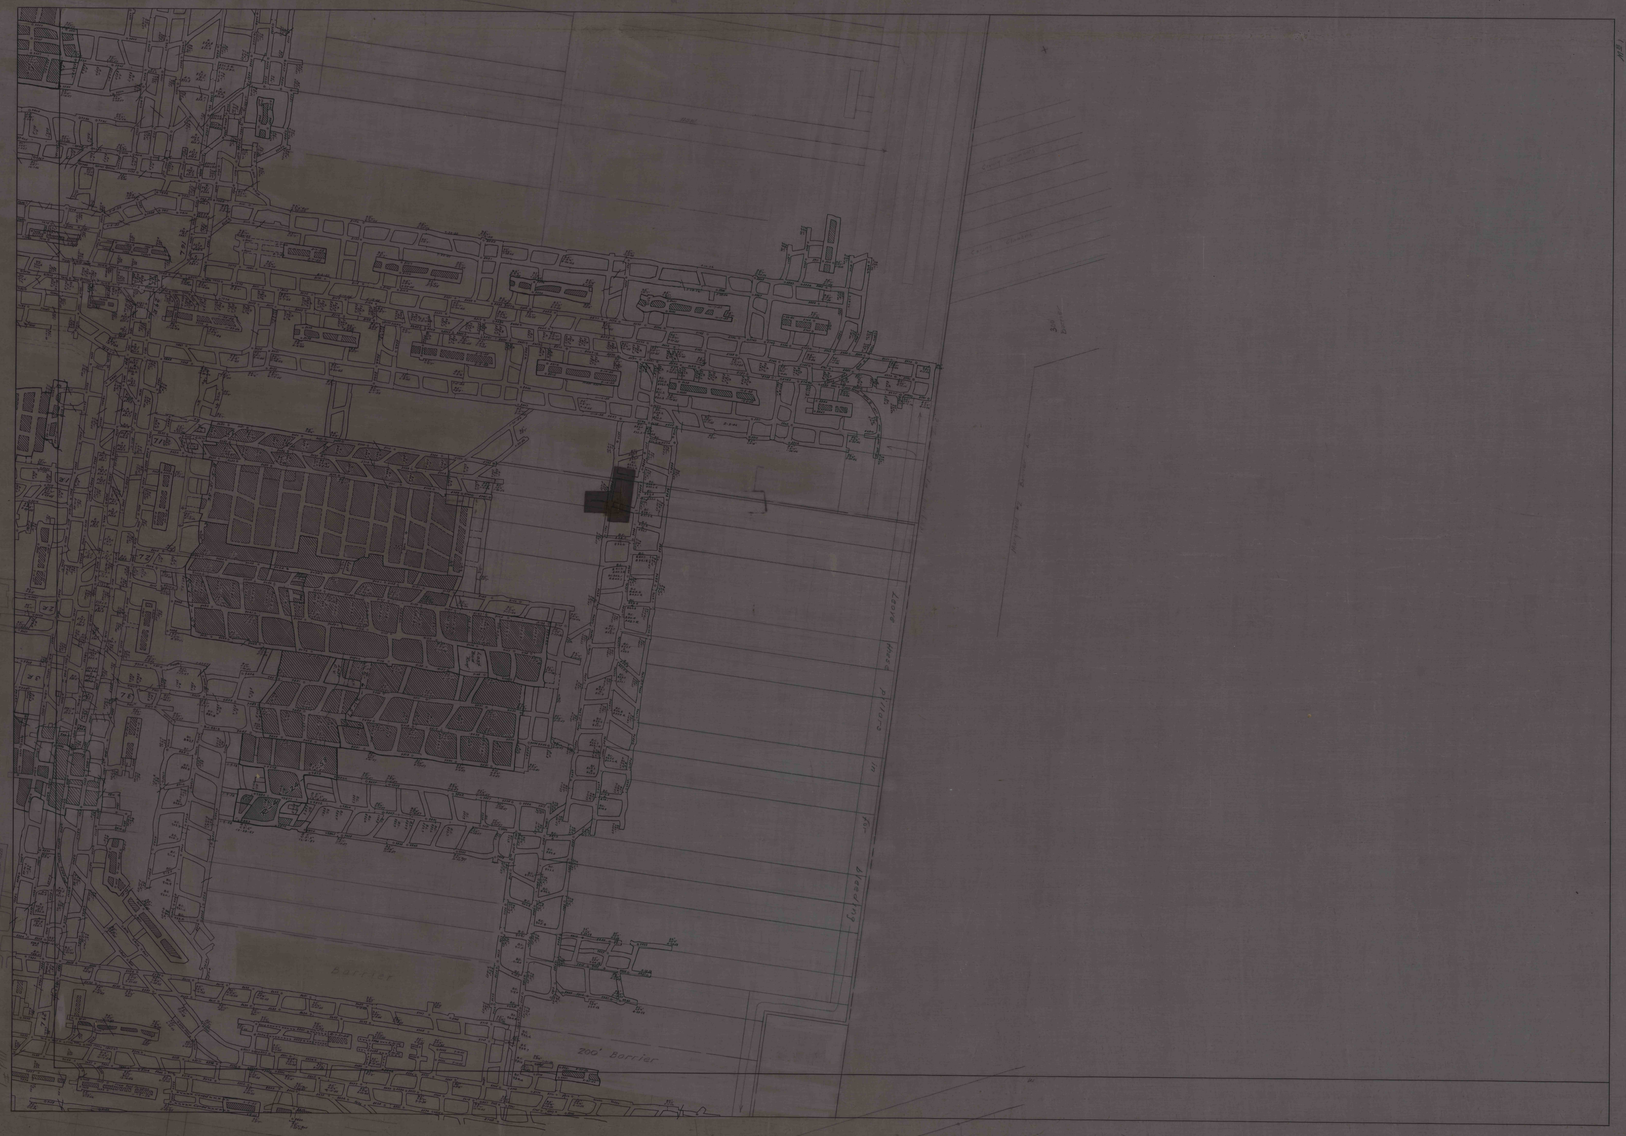
Fairmount Avenue
200' Border