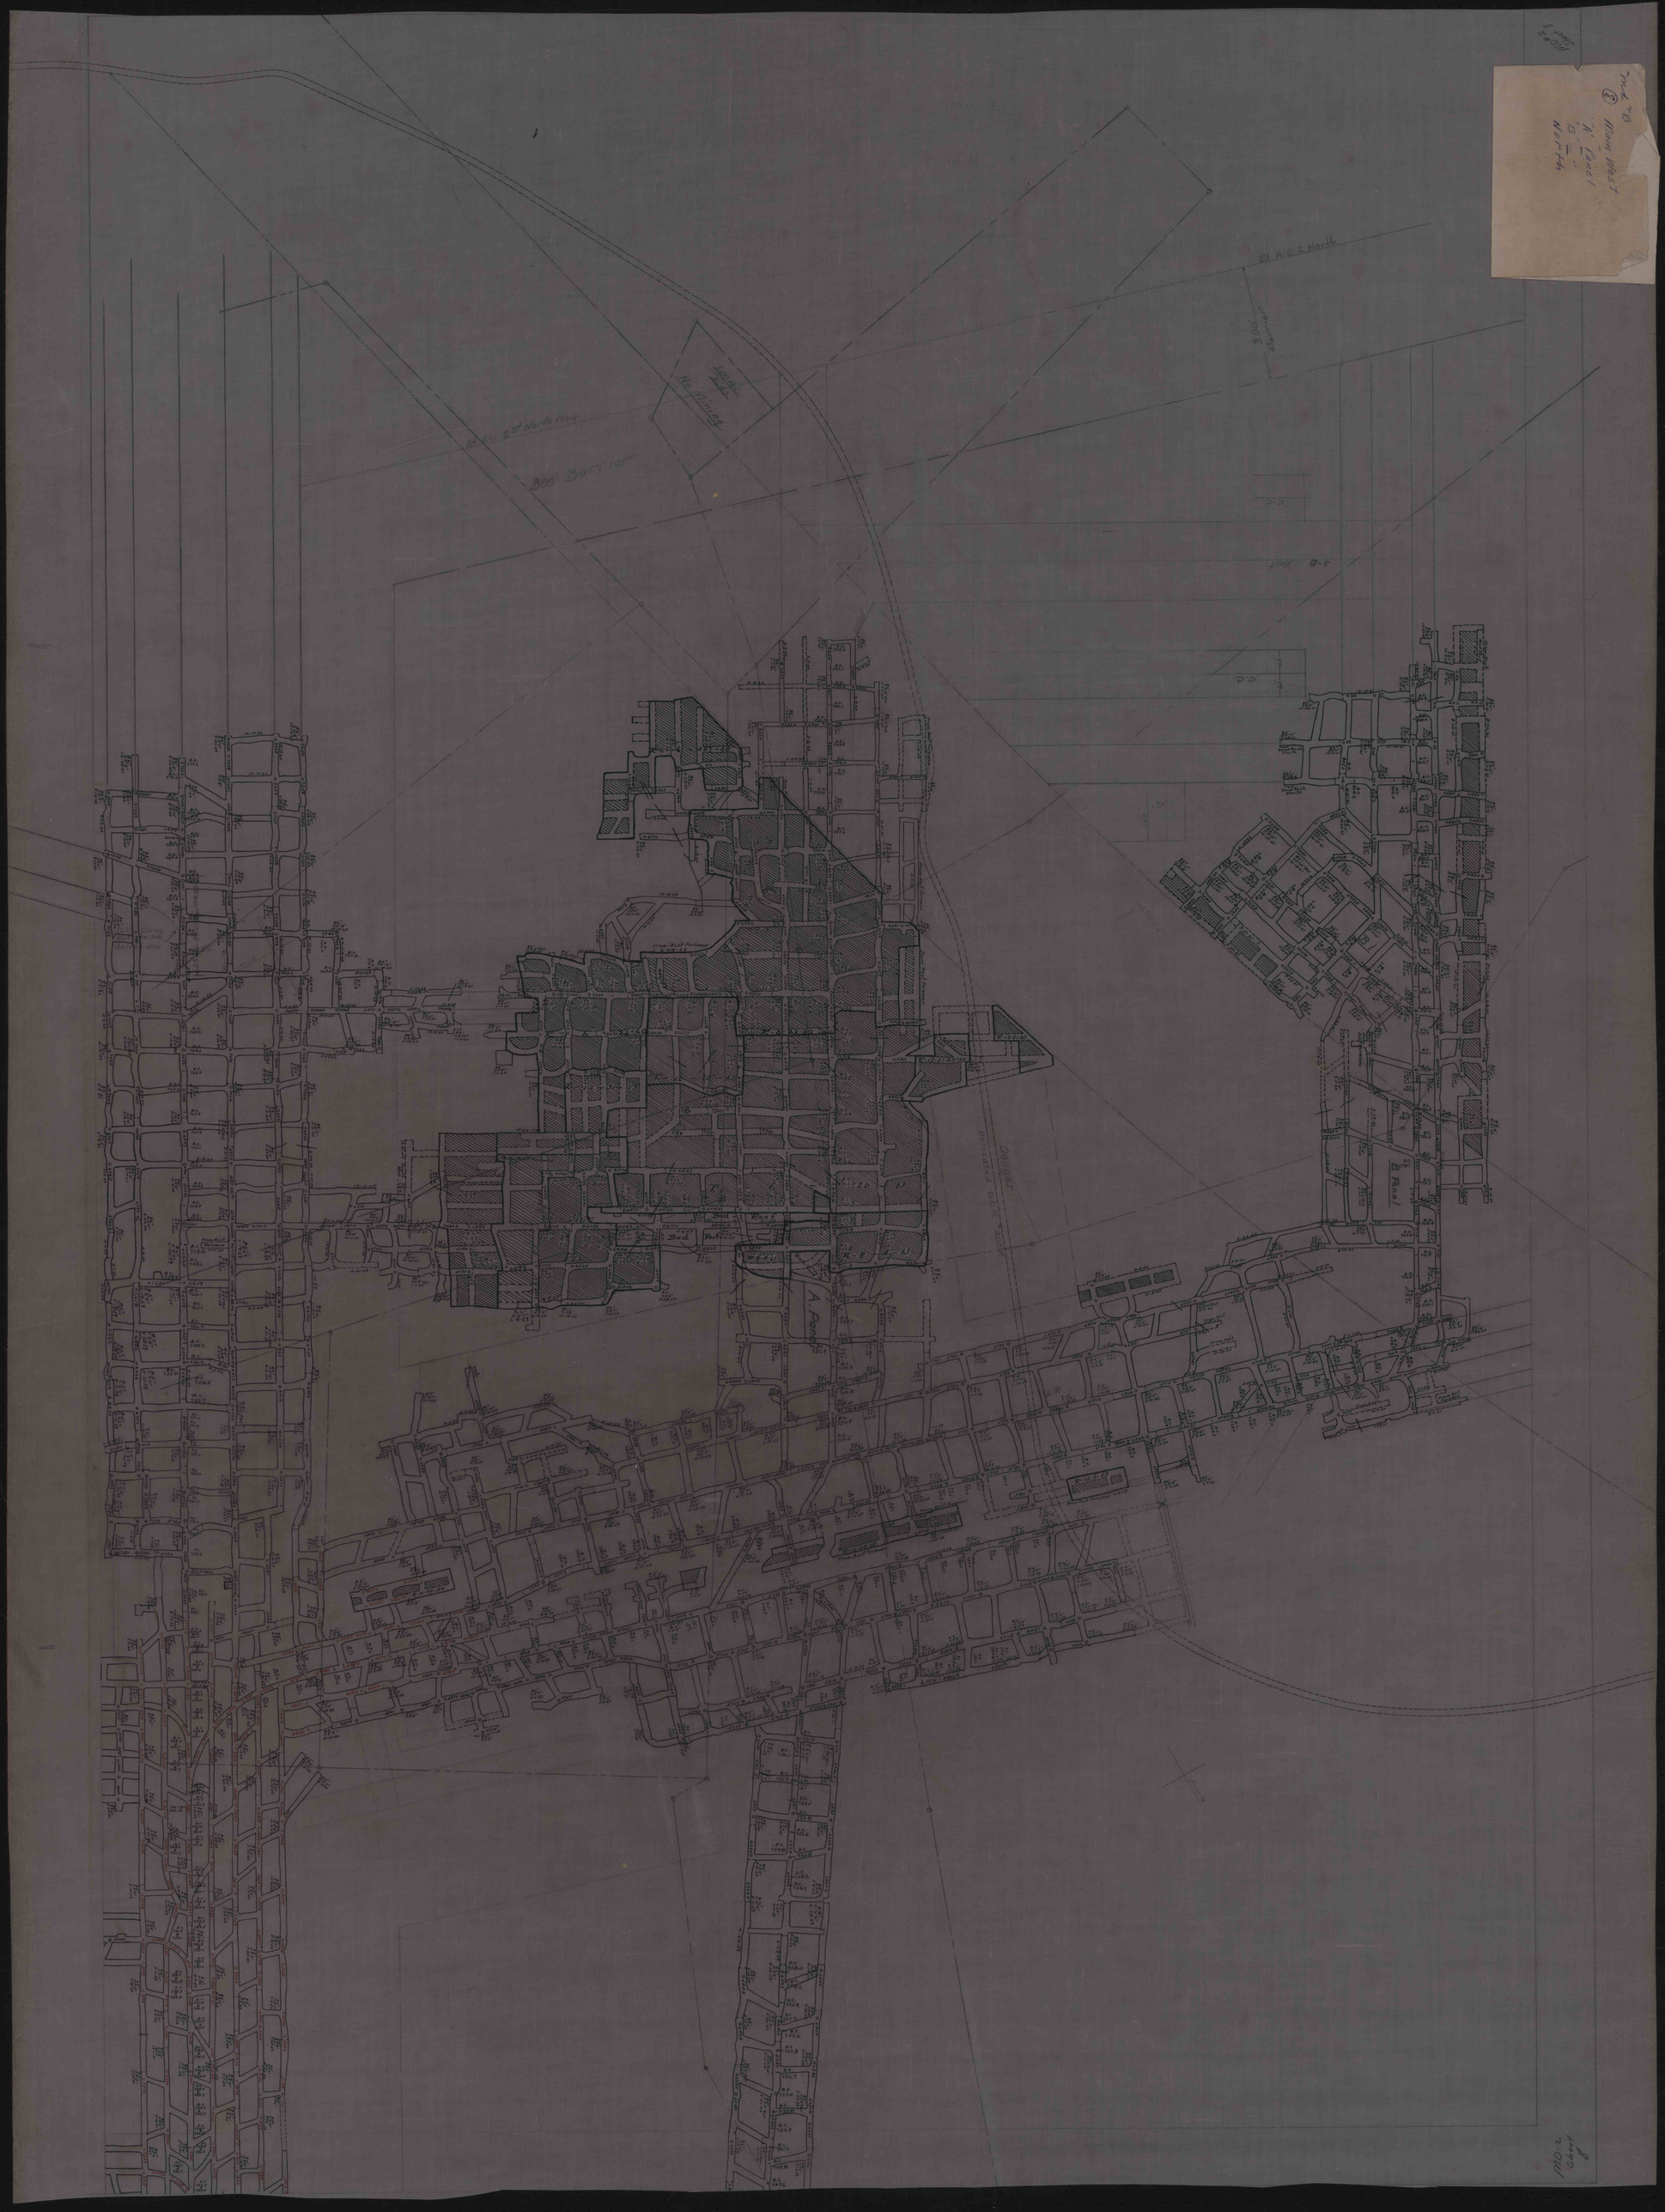
Map 78
Mun West
N. Canal
To
North
Ft. A.G. 2 North
300 Barrier
No Mining
Ft. A.G. 2nd North Line
300 Barrier
Bad Roof
Bad Roof
A Pond
B Pond
Dunlap
Universal Coal Co.
Coal Bin
Coal Bin
Coal Bin