


1807

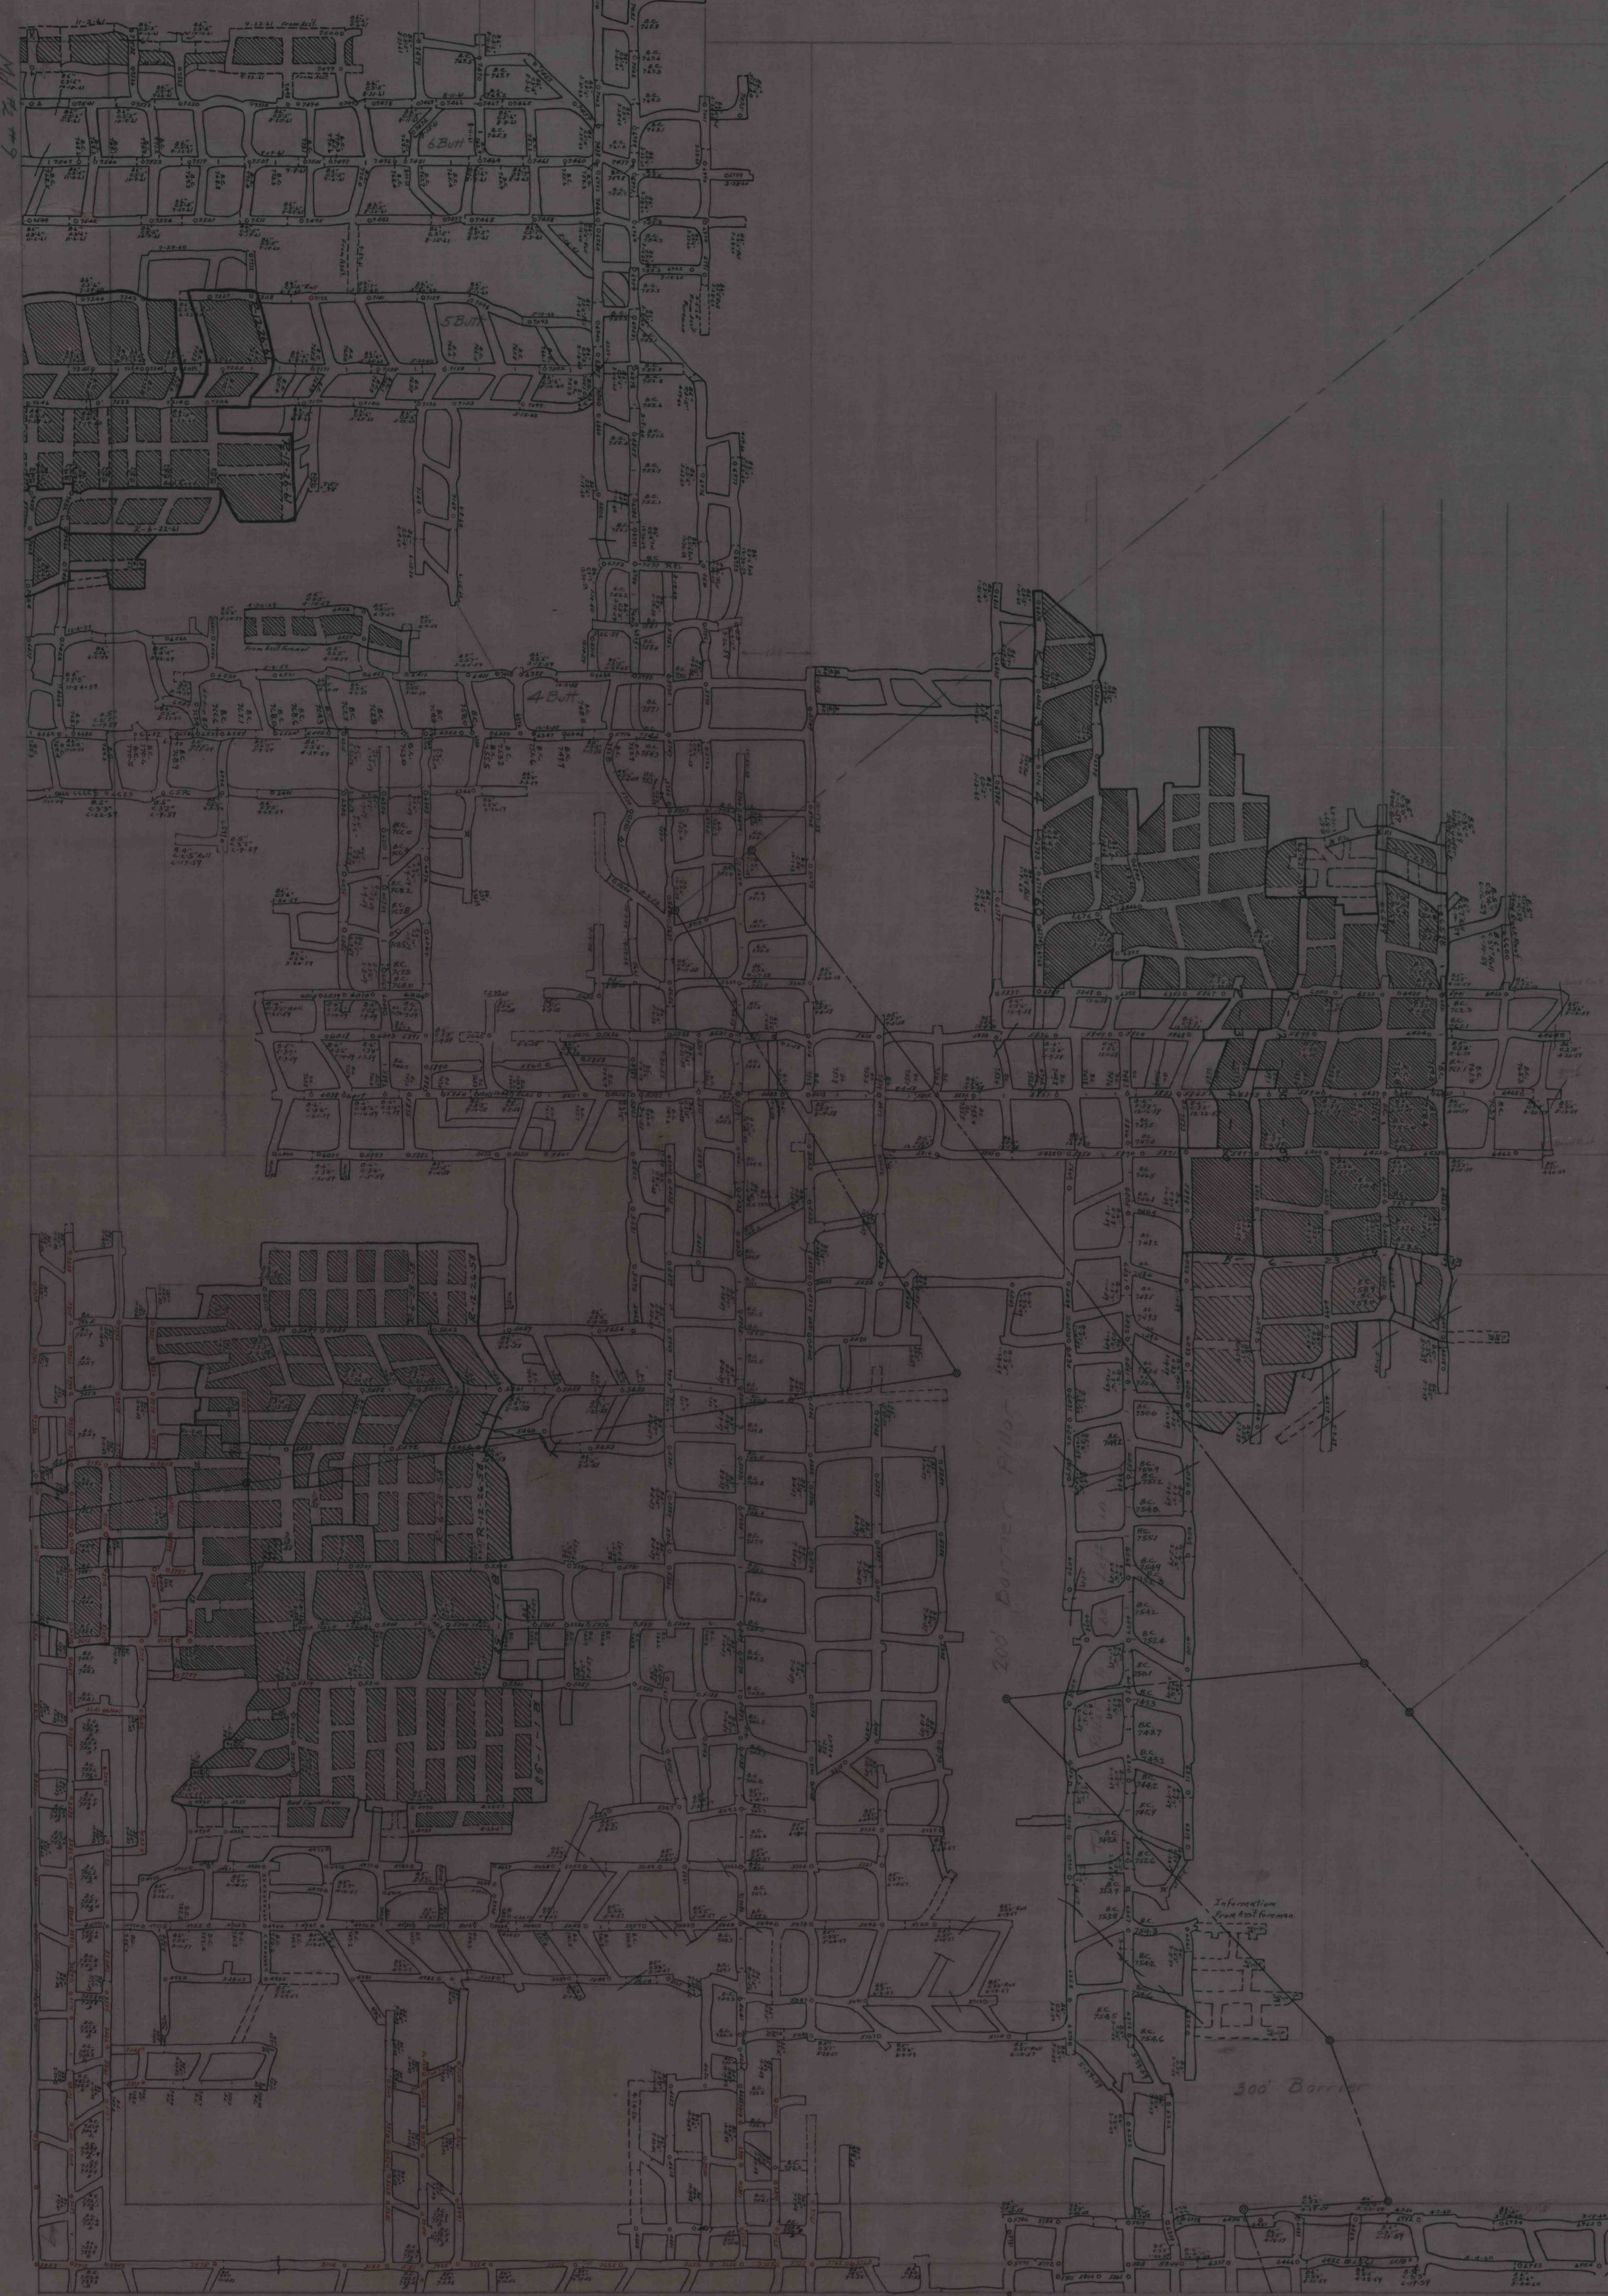

200 Barrer Alley

300 Barrer

Information Court and Rooms

17/06
 Res.
 2. 1/10/06

1250

1251