


J

COLONIAL IRON COMPANY.

COLONIAL IRON COMPANY.

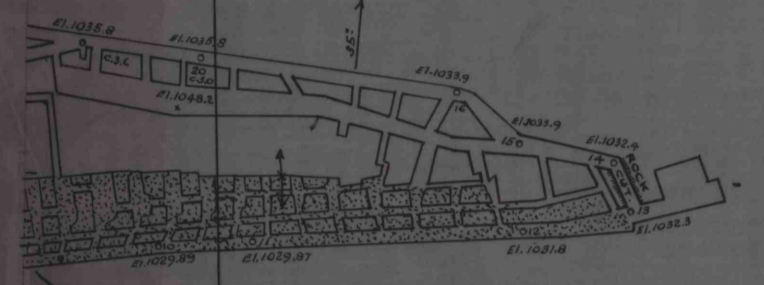

CAMBRIA IRON COMPANY

CAMBRIA IRON COMPANY.

CARBON COAL AND COKE COMPANY.

S.B.5.A

